



**JANET MATHESON ARCHITECT**

P.O. BOX 81038  
FAIRBANKS, ALASKA 99708  
(907) 452-4640


**CITY OF FAIRBANKS  
SENIOR CITIZENS RECREATION  
& NUTRITION CENTER**

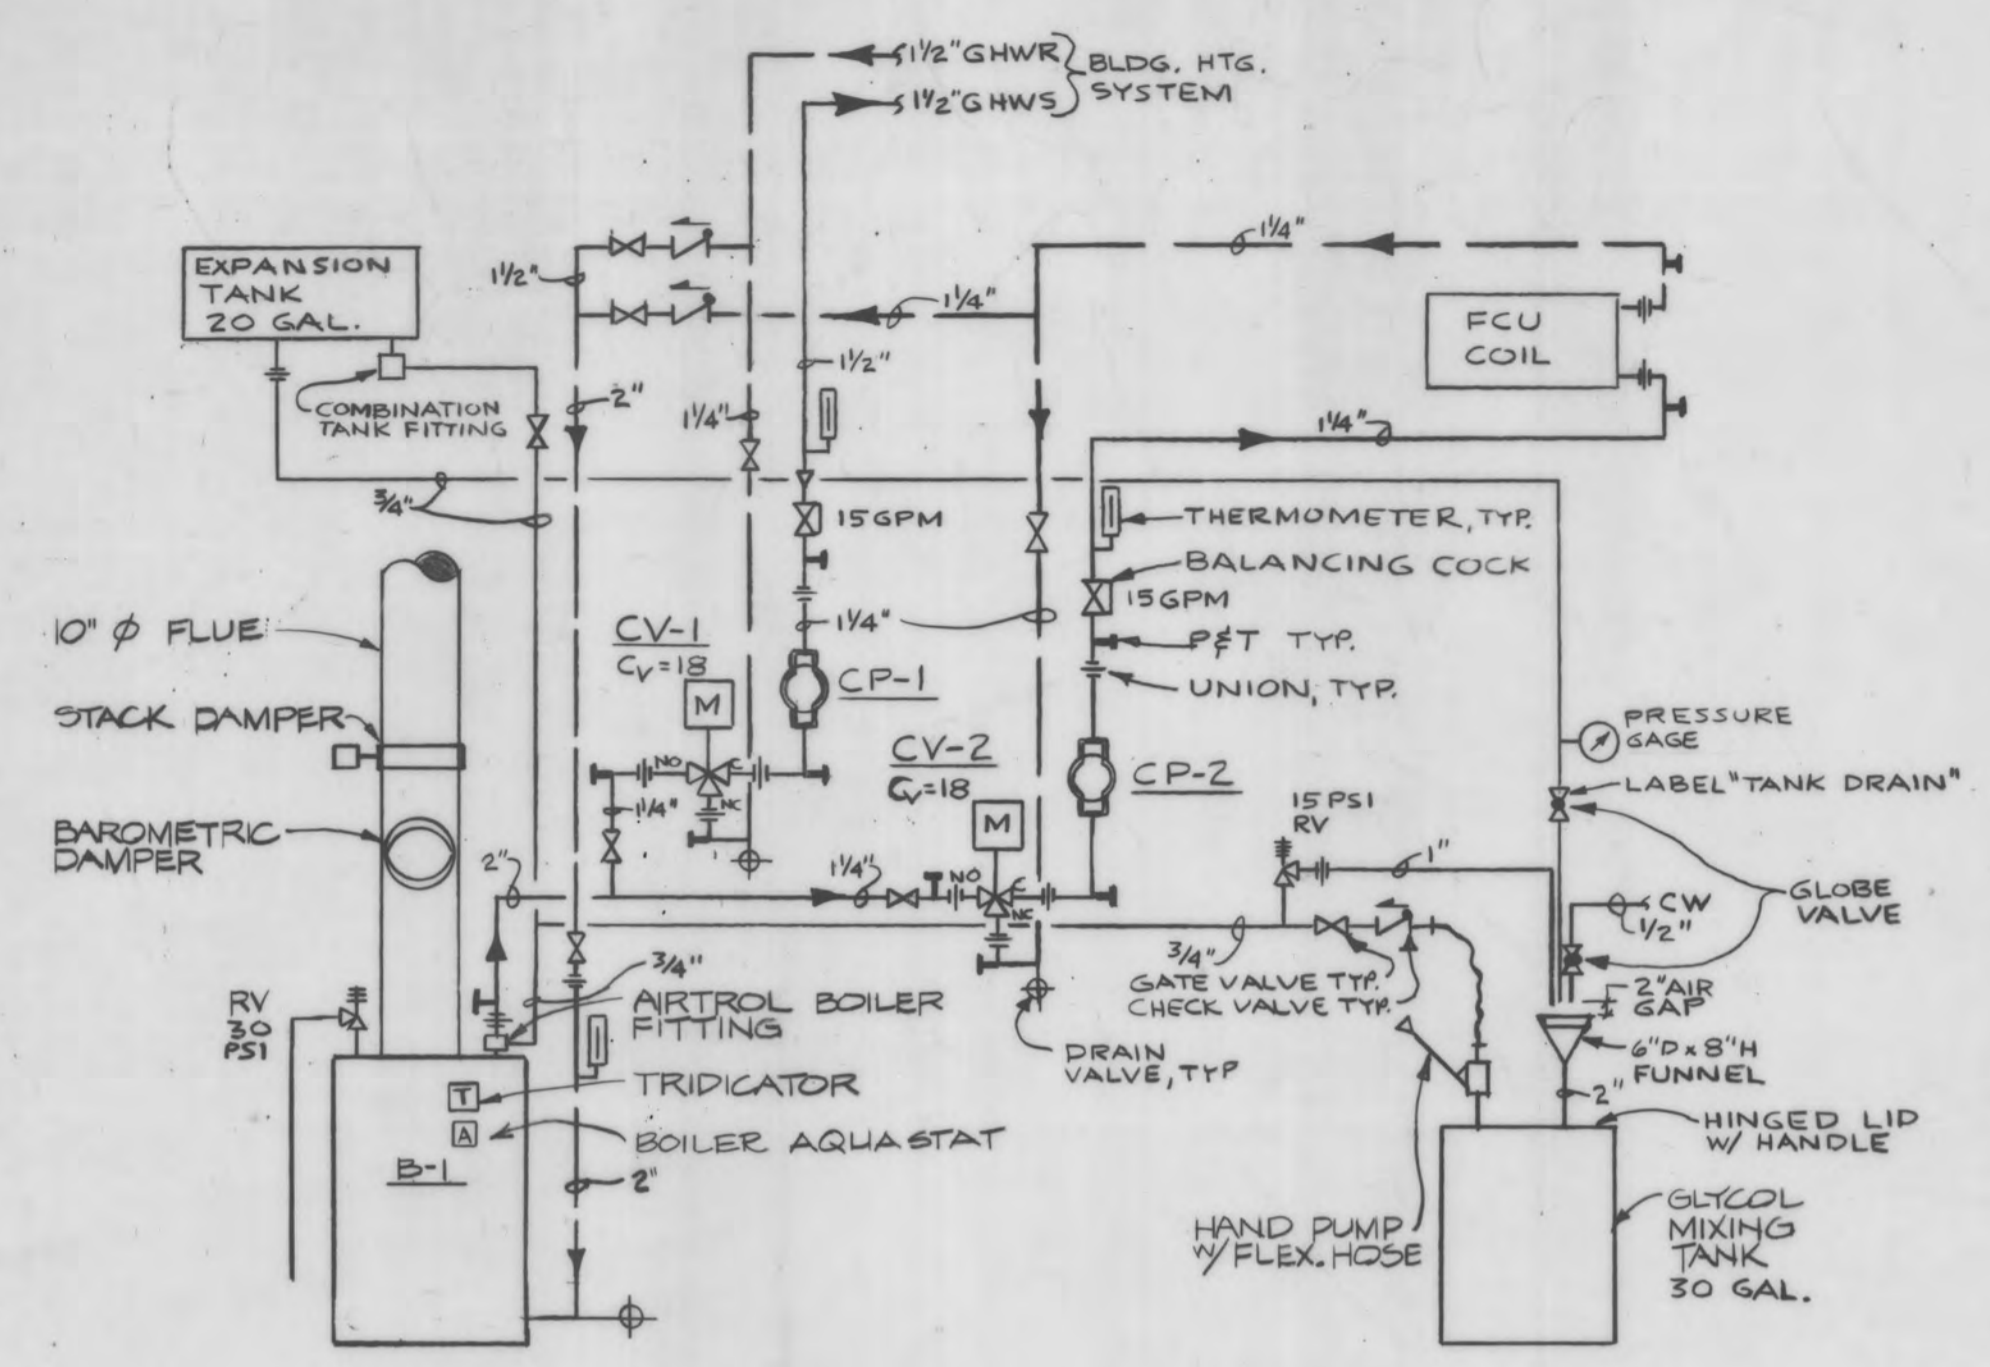


**1 M7 GLYCOL HEATING SYSTEM FLOW DIAGRAM**  
NO SCALE

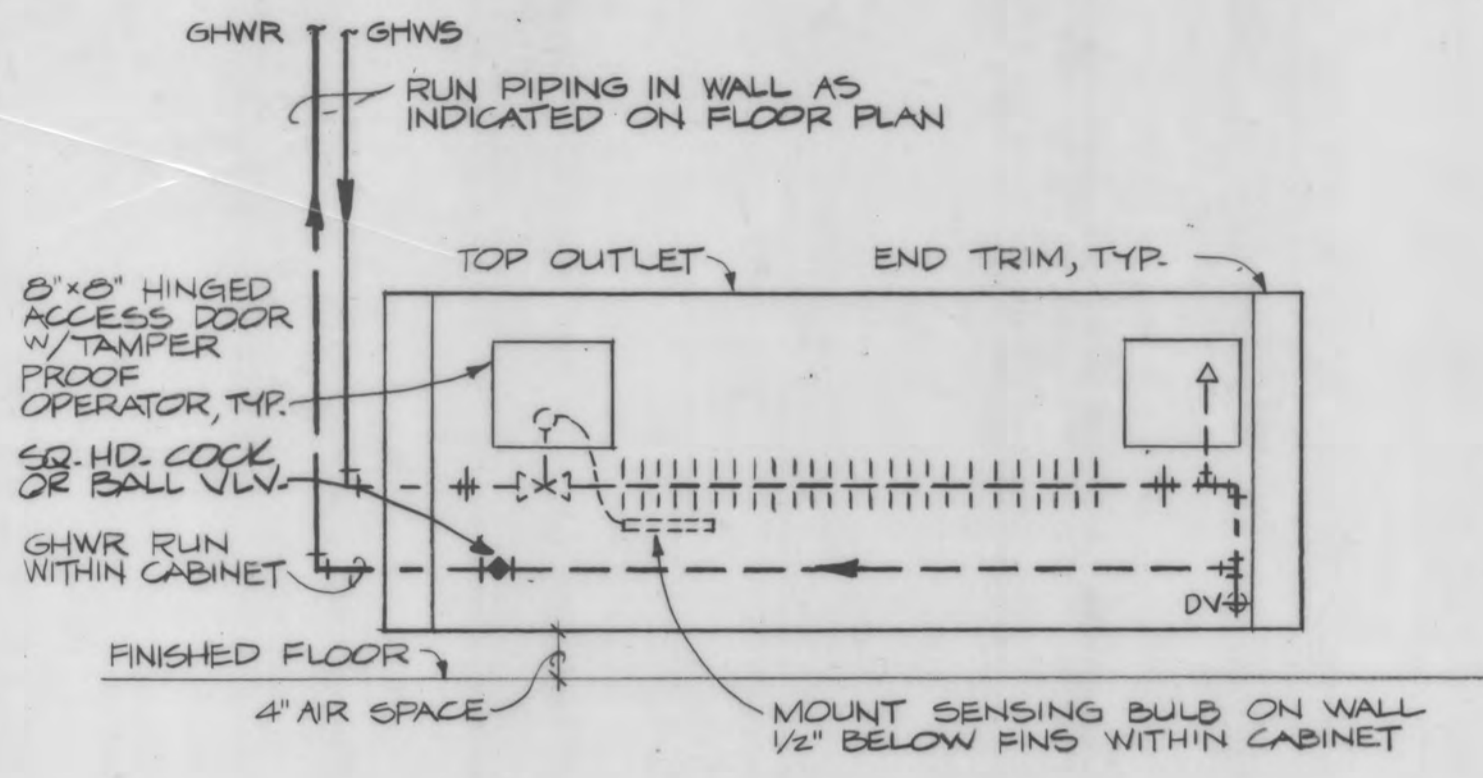


**2 M7 FTR-1 & 2 PIPING DIAGRAM**  
NTS

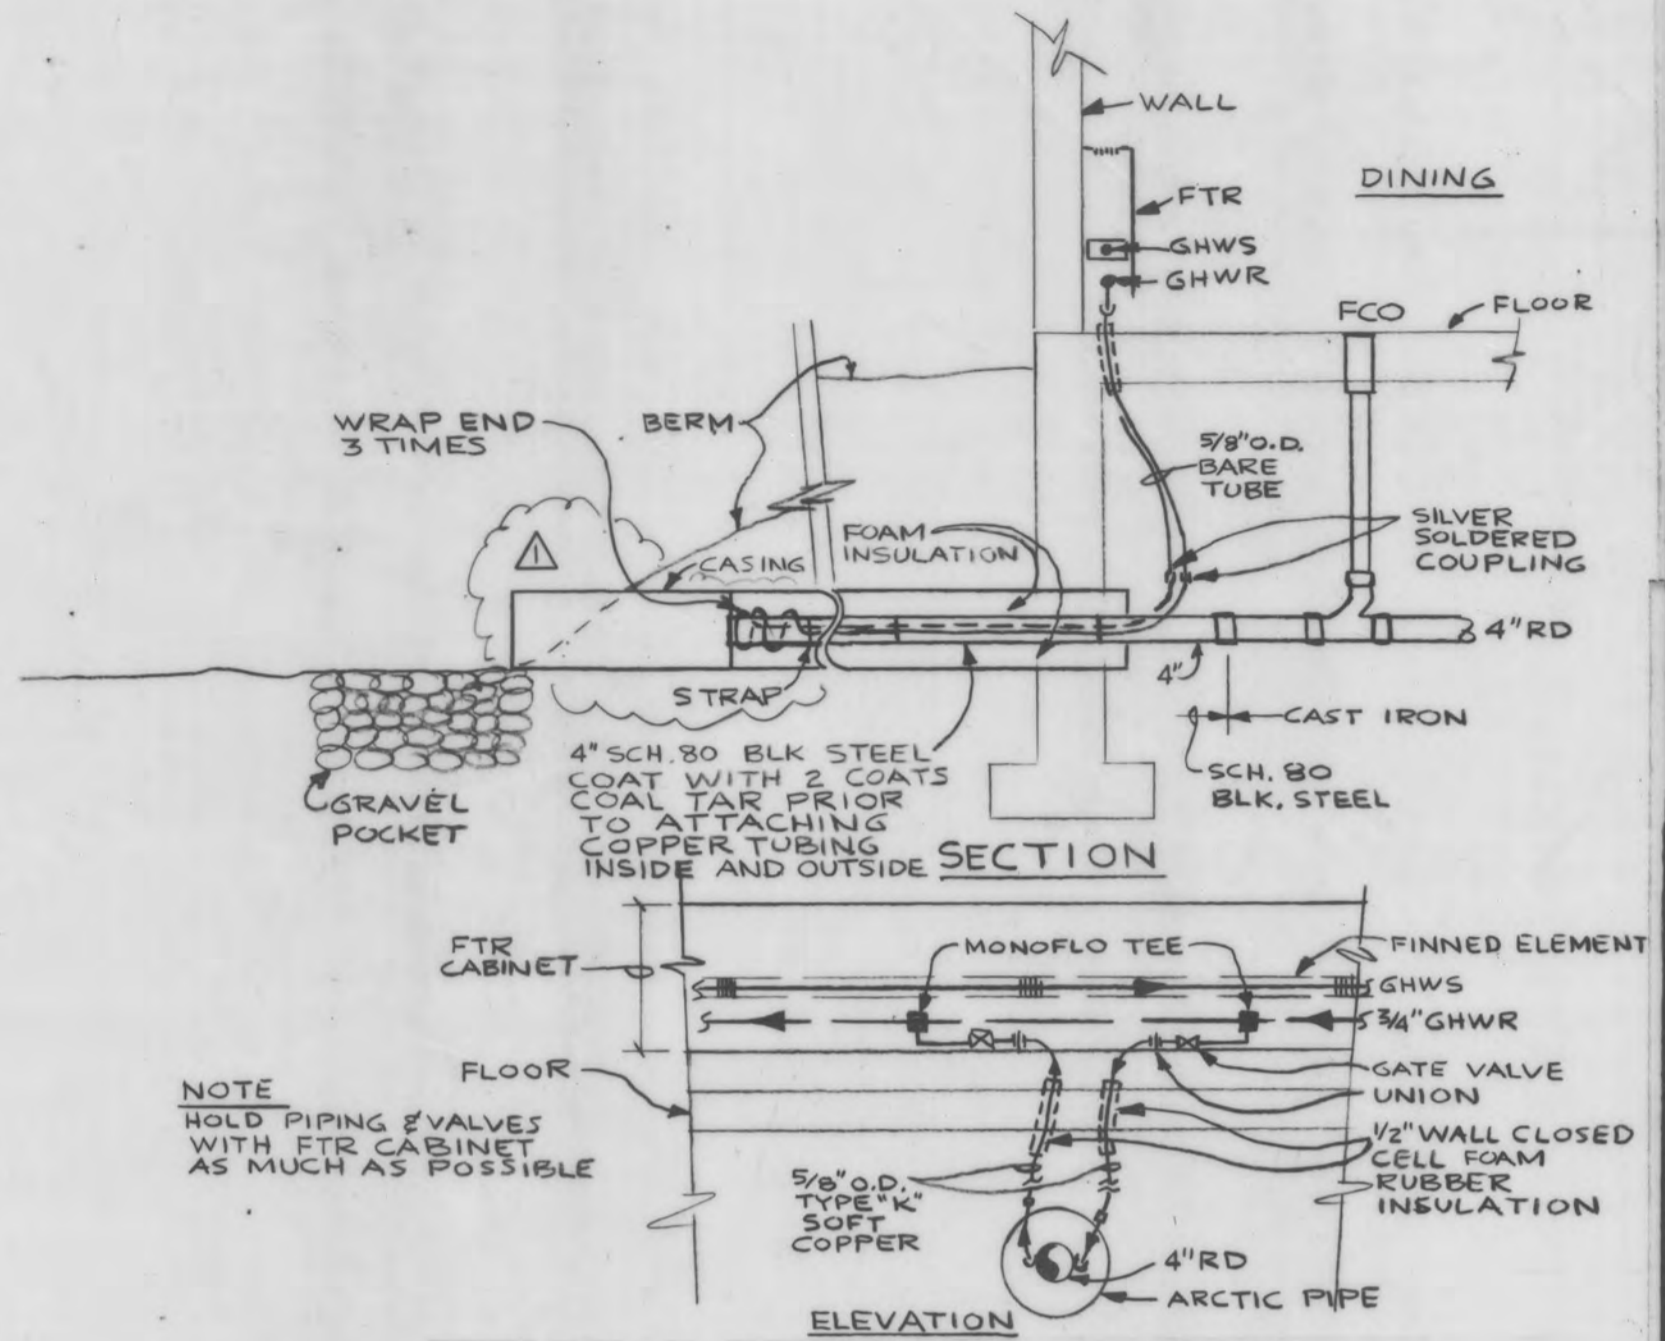



**3 M7 RAIN DRAIN FREEZE PROTECTION DETAILS**  
NTS

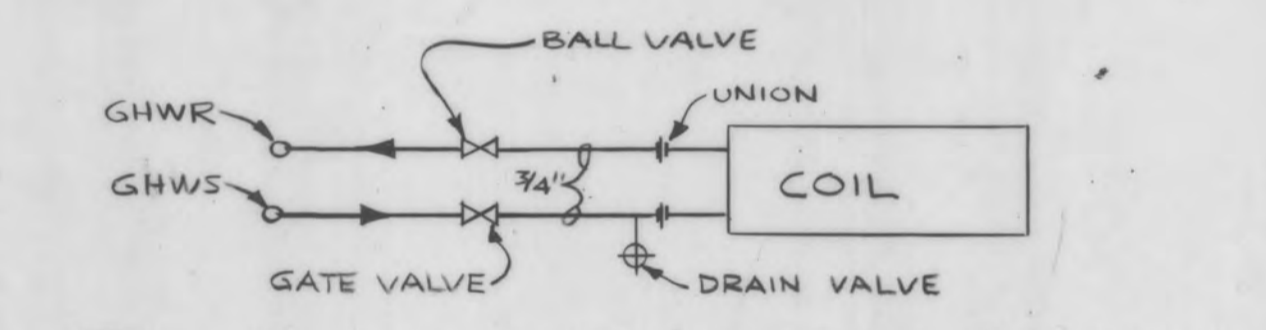

**6 M7 CUH PIPING DIAGRAM**  
NTS

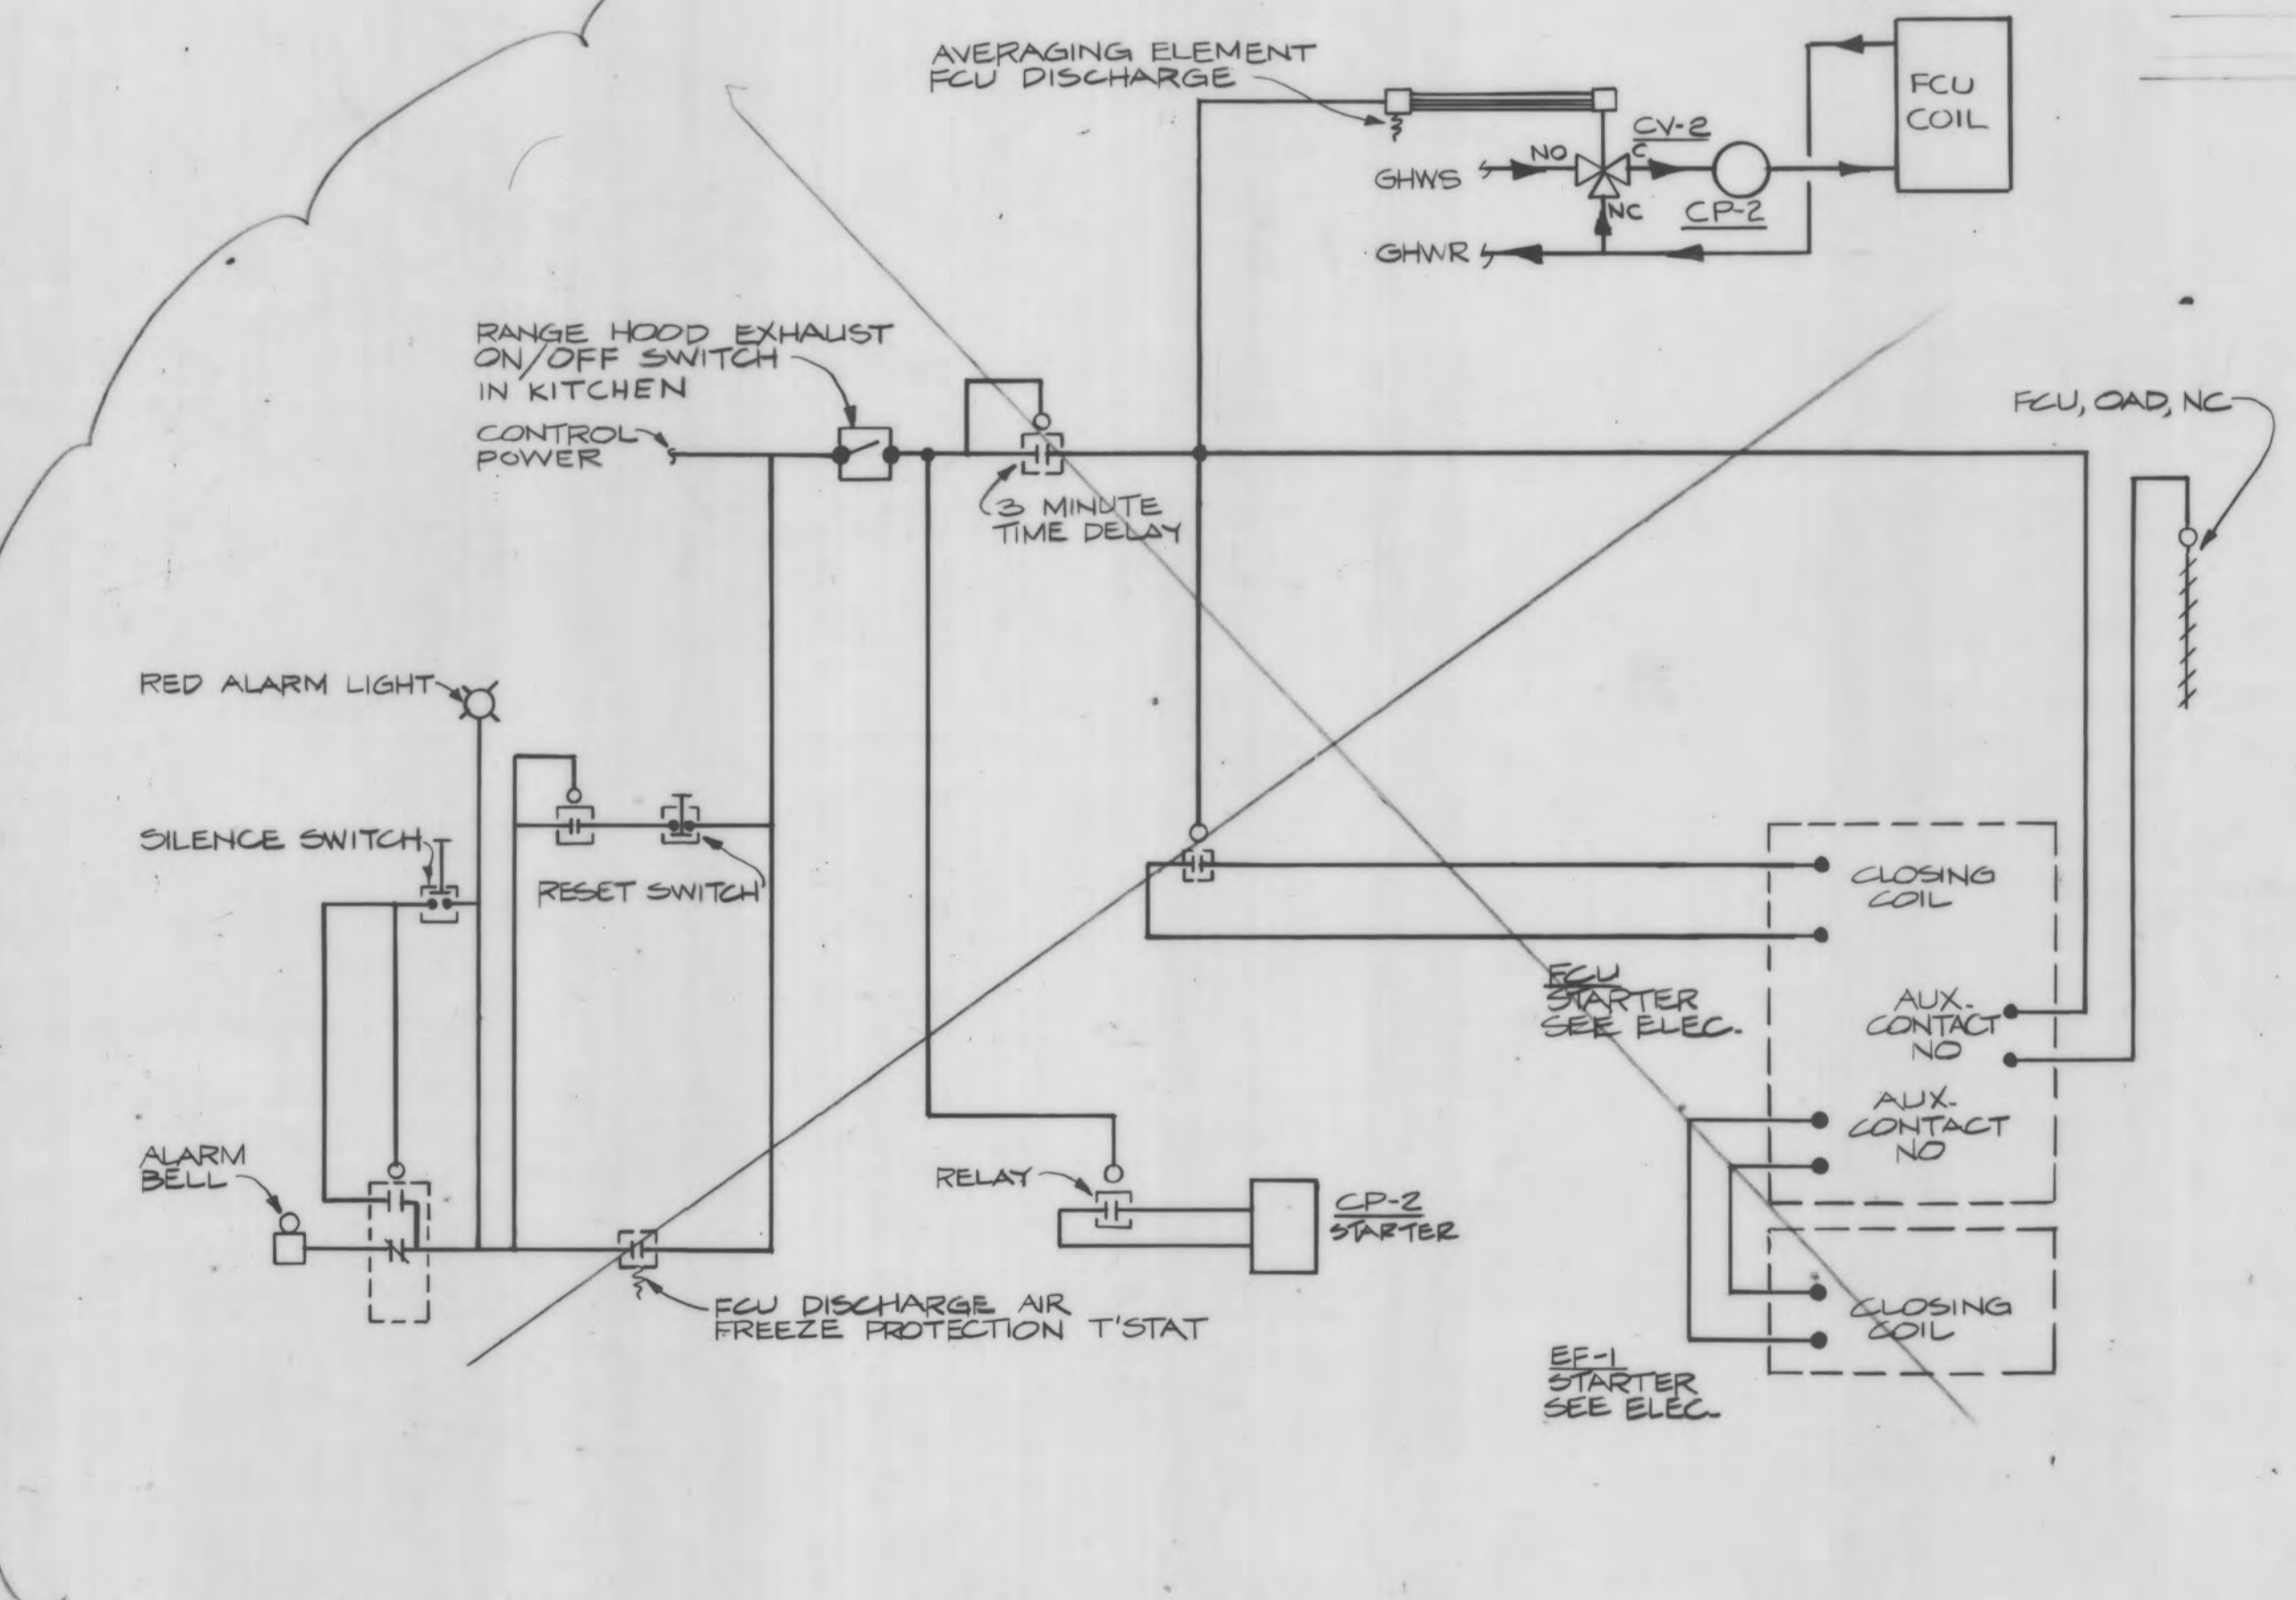

**4 M7 FCU, EF-1 & CP-2 CONTROL SCHEMATIC**  
NTS

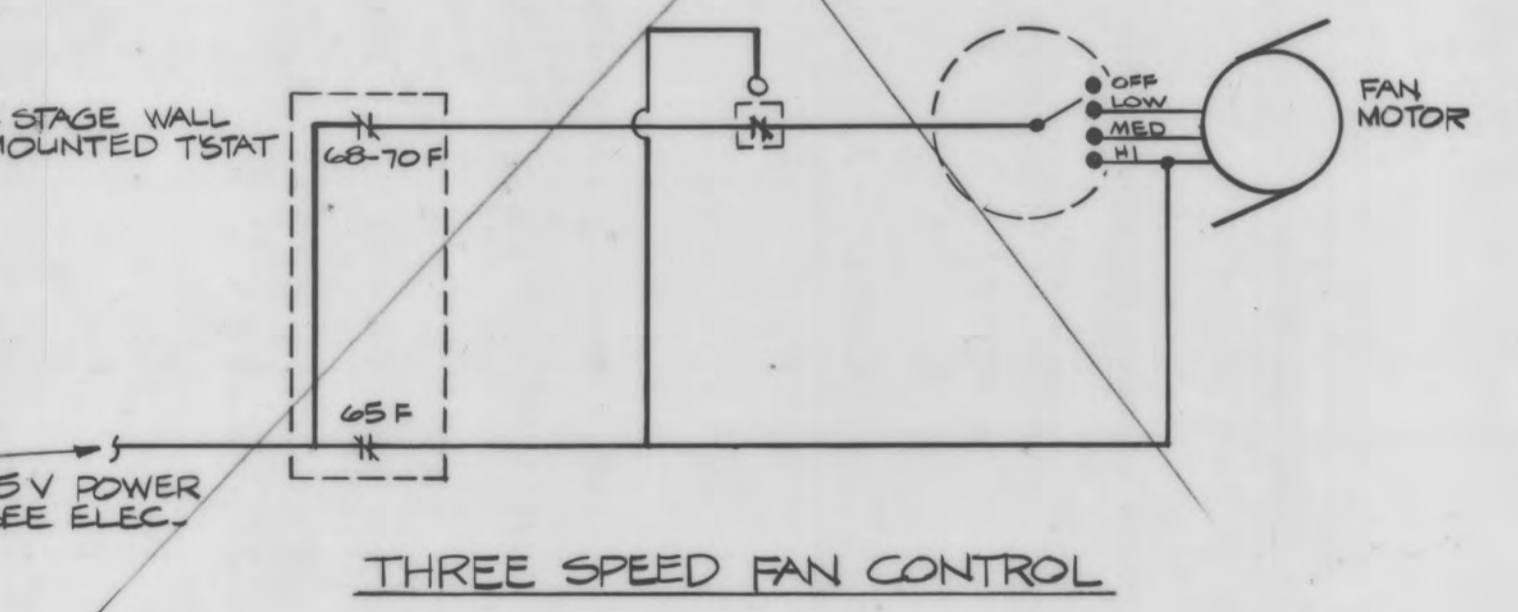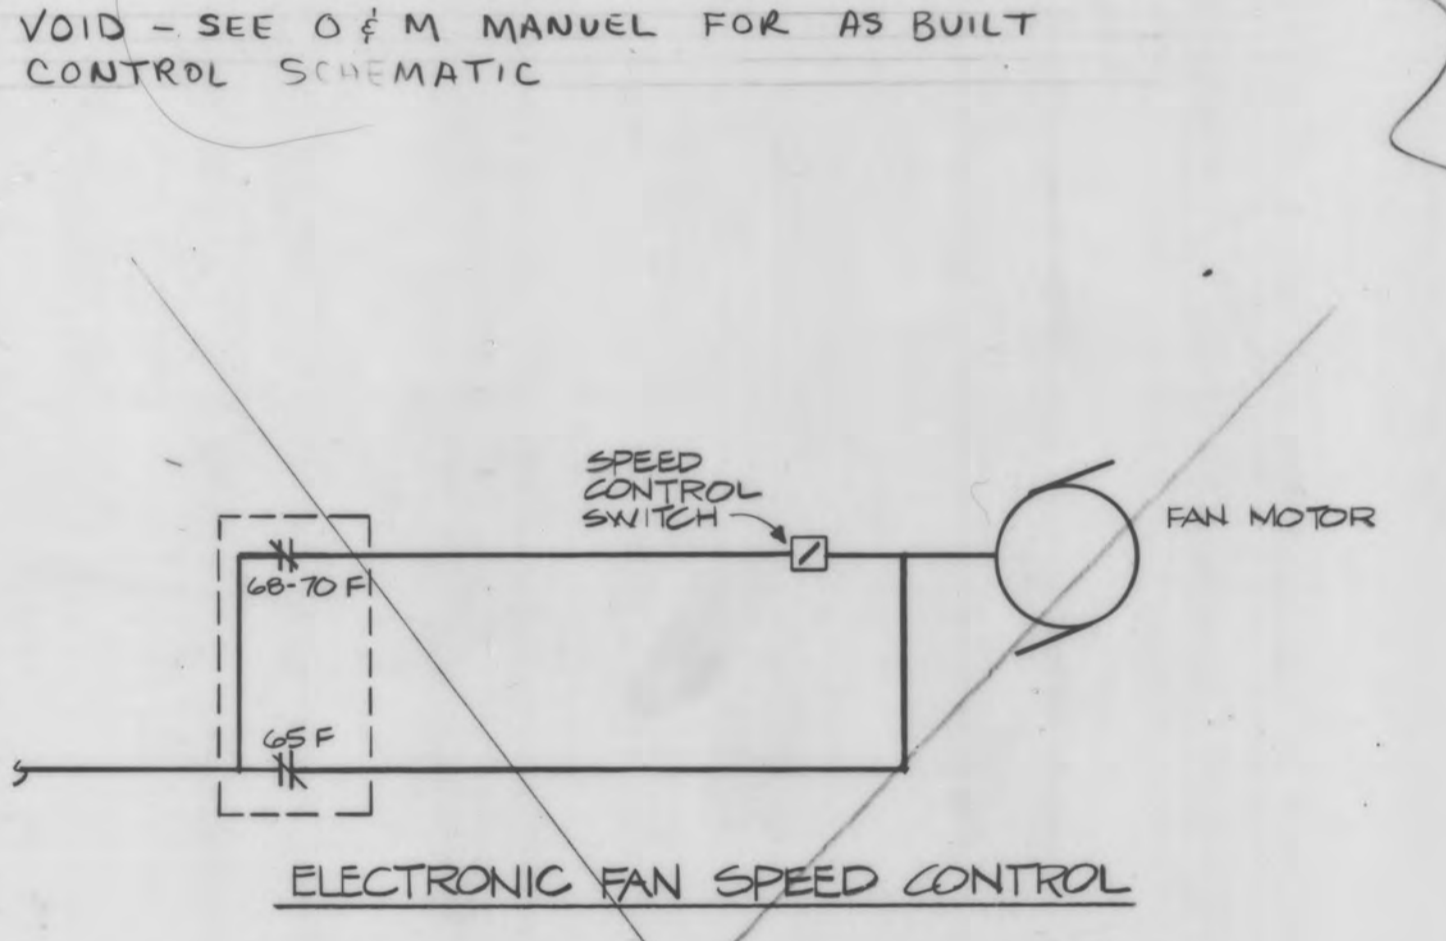

**5 M7 CUH-1, 2 & 3 CONTROL SCHEMATIC**  
NTS

VOID - SEE O & M MANUAL FOR AS BUILT CONTROL SCHEMATIC

AS BUILT 12-23-80



MICROFILMED DATE: 12/83  
MICROFILM NUMBER:



HVAC  
DETAILS  
REBID  
NO SCALE

SHT #

**M7**

OWN JWDCKD HAC  
DATE 2-7-80 PROJ #