




SECTION 1
1/2" = 1'-0"

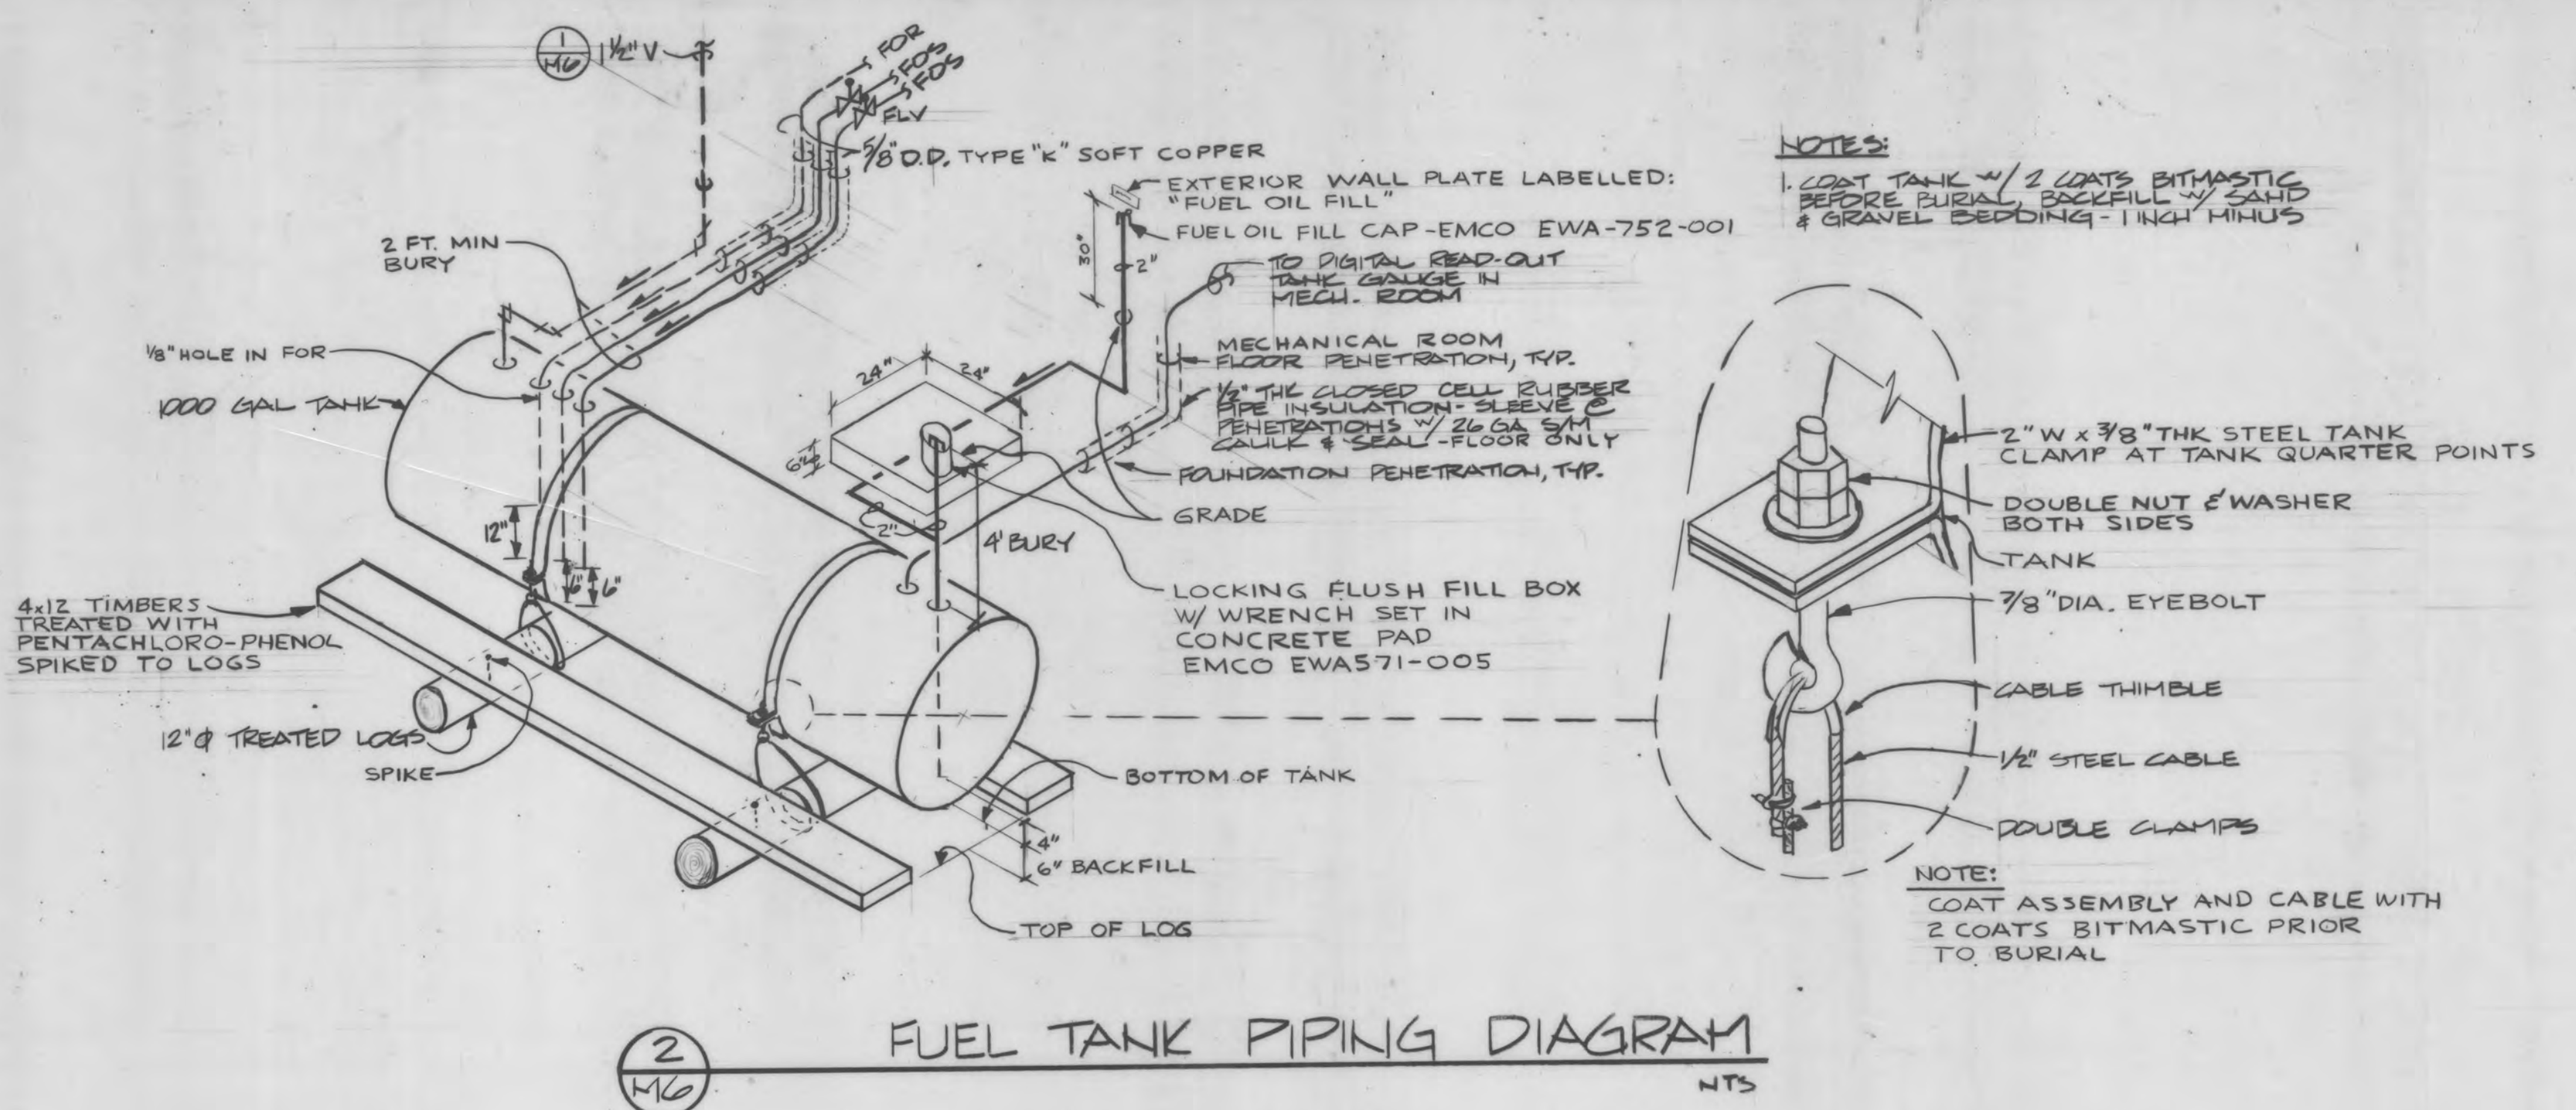


FUEL TANK PIPING DIAGRAM 2
NTS

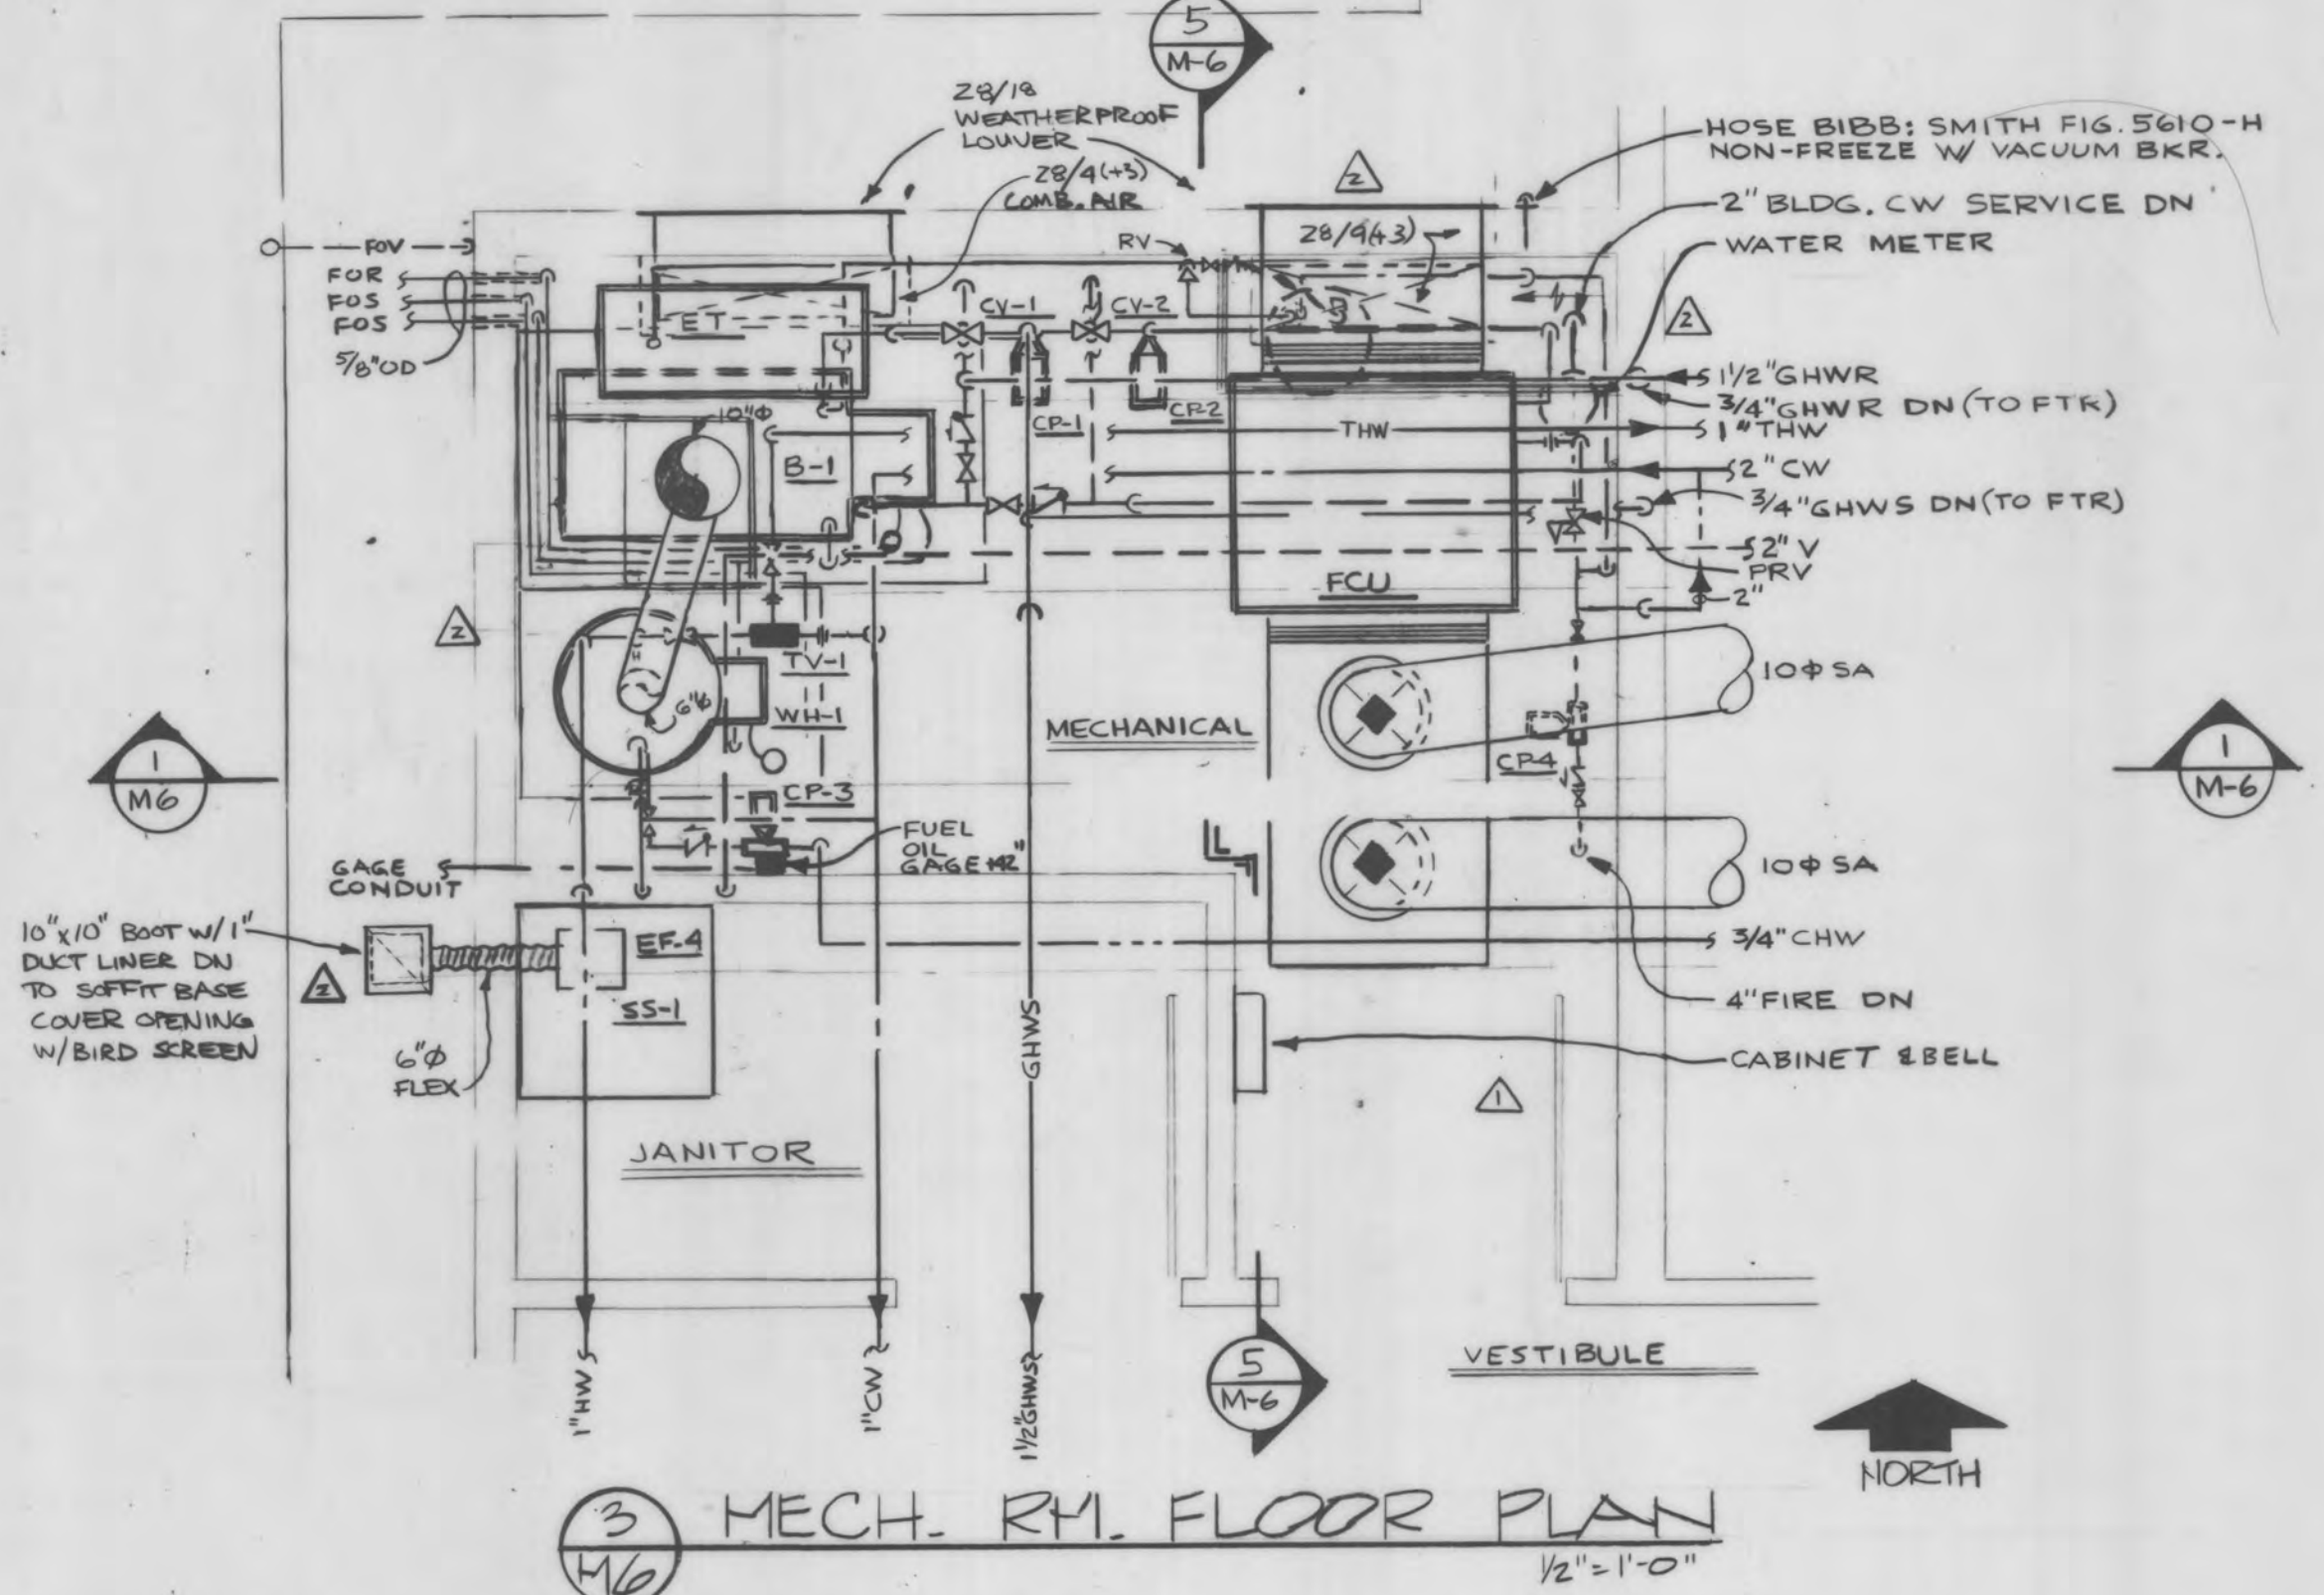


MECH. RM. FLOOR PLAN 3
1/2" = 1'-0"

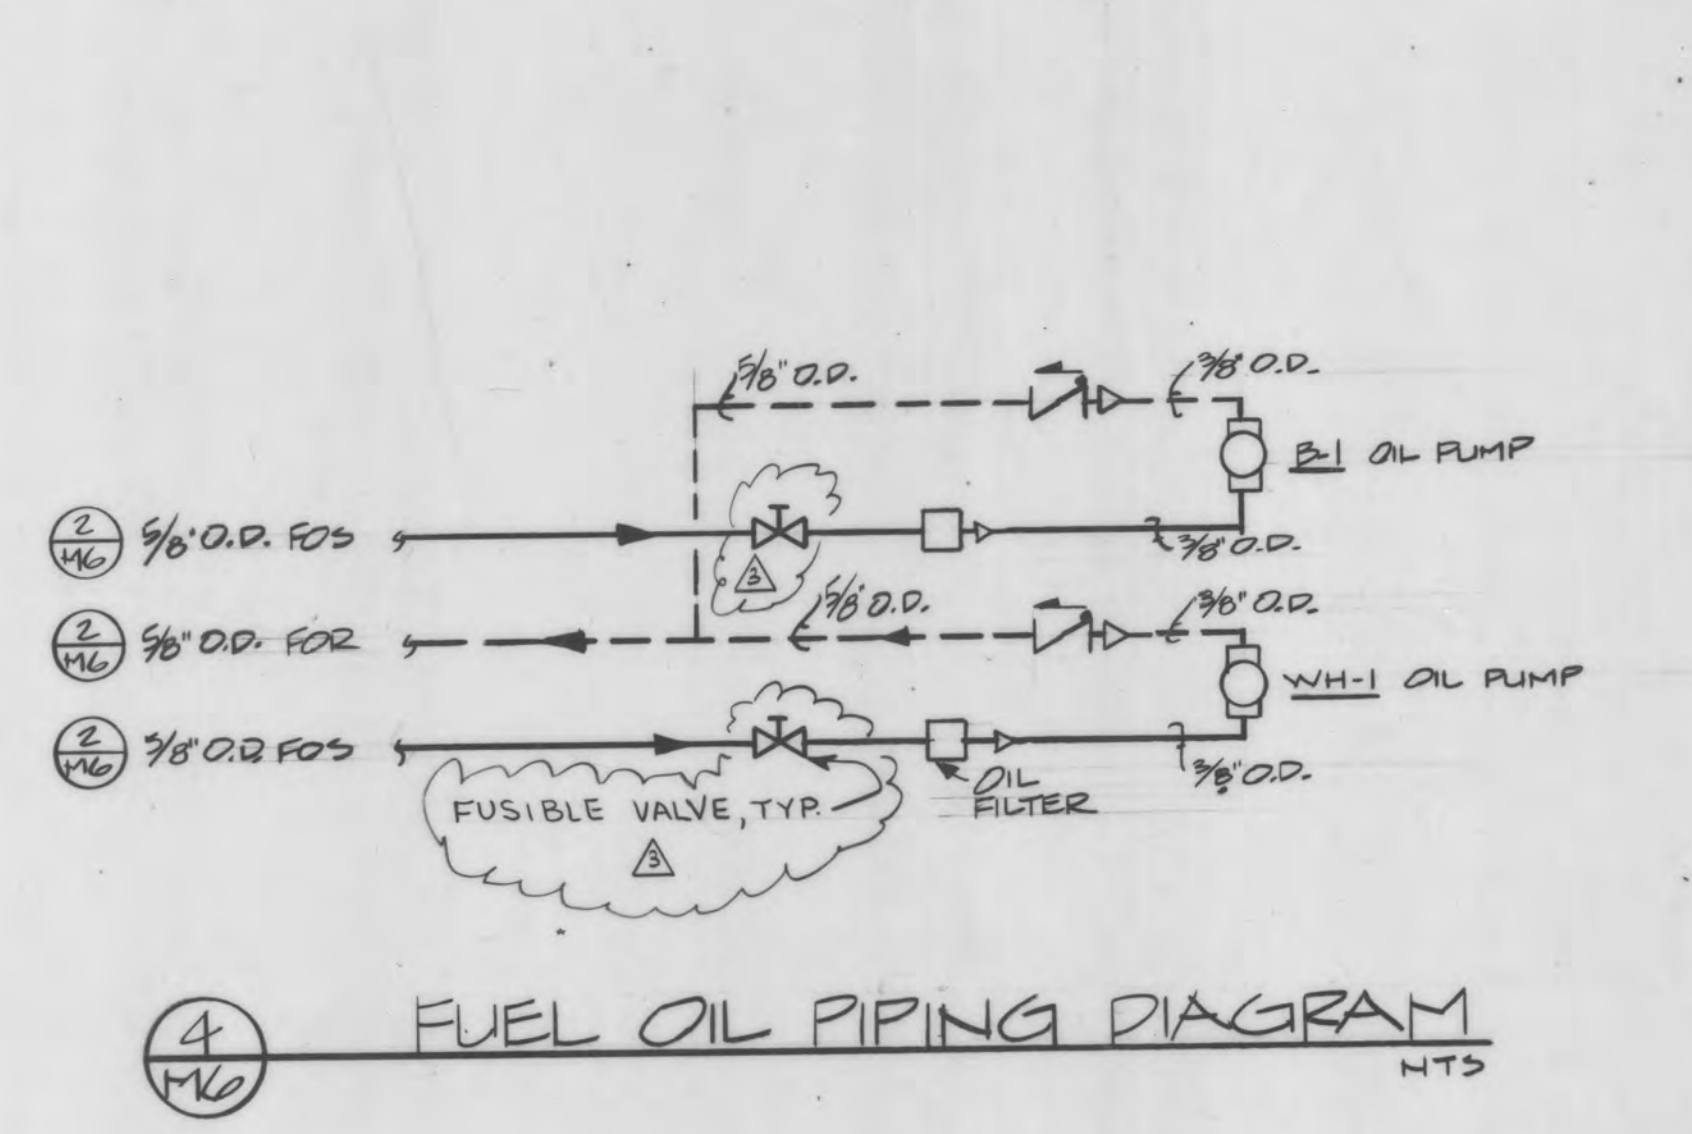

FUEL OIL PIPING DIAGRAM 4
NTS

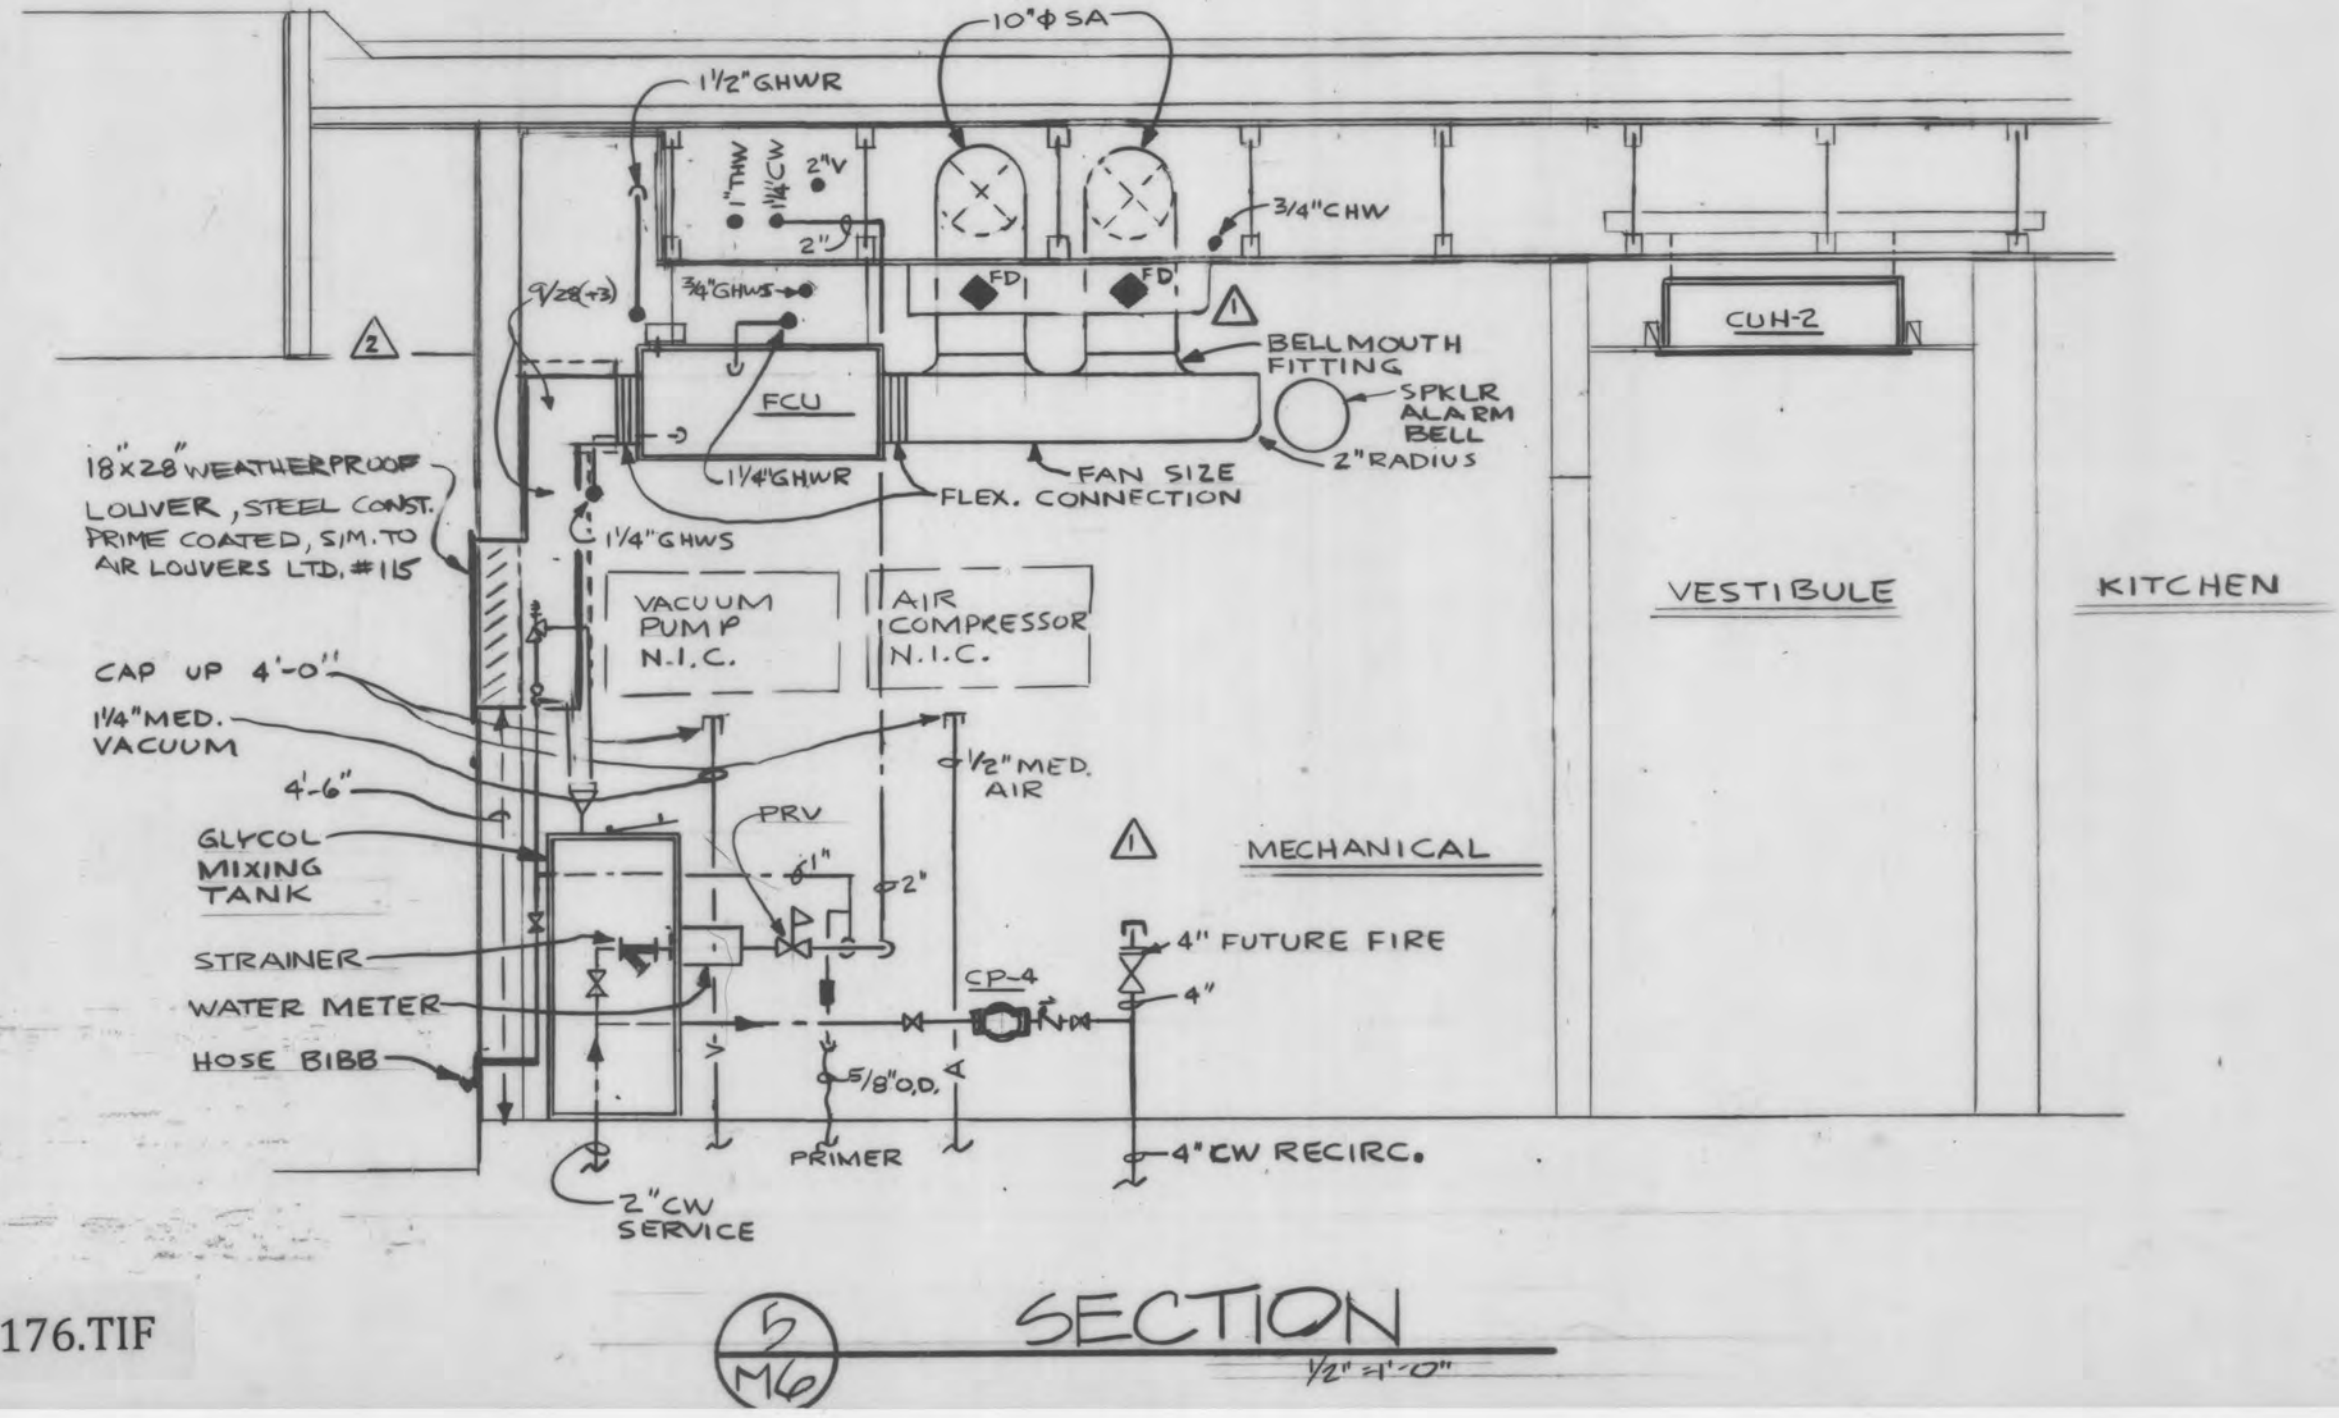

SECTION 5
1/2" = 1'-0"

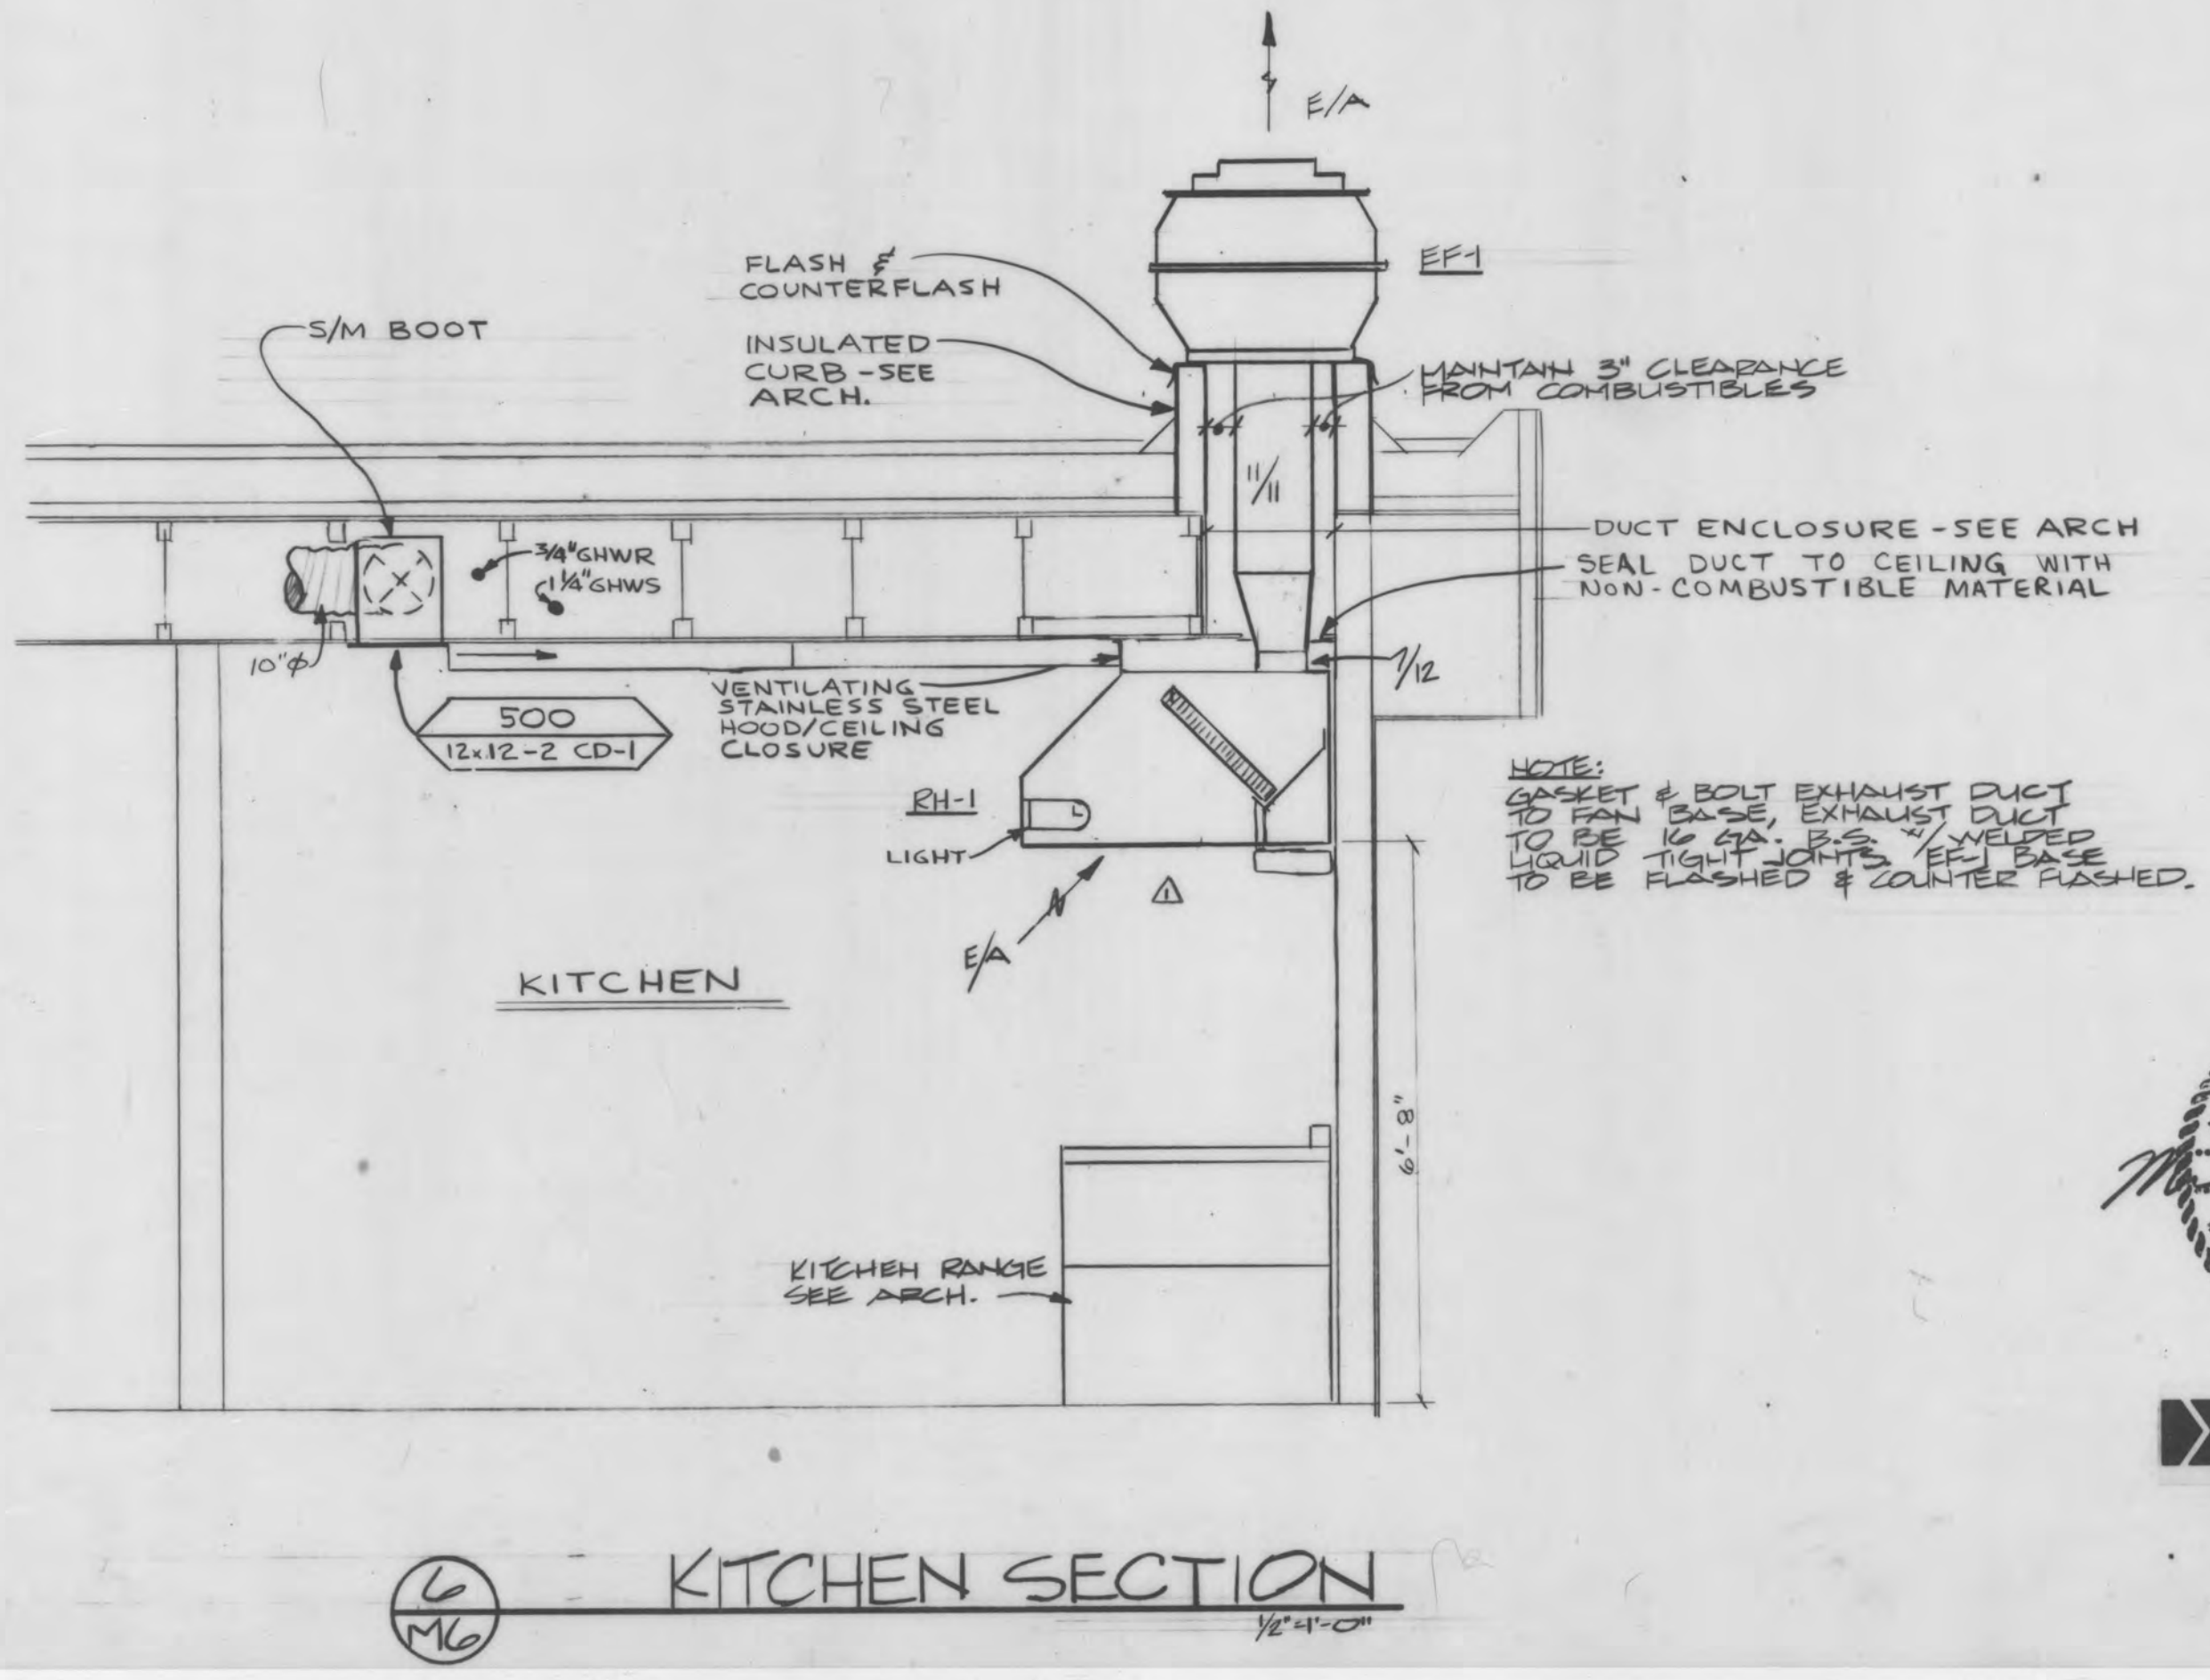

KITCHEN SECTION 6
1/2" = 1'-0"

JANET MATHESON ARCHITECT
P.O. BOX 81038
FAIRBANKS,
ALASKA 99708
(907) 452-4640

**CITY OF FAIRBANKS
SENIOR CITIZENS RECREATION
& NUTRITION CENTER**

AS BUILT 12-23-80
PROPOSED CHANGE ORDERS 7/23/80
APPENDIX #1 REVISIONS 3/7/80

**HVAC
DETAILS**
REPID
SCALE: AS SHOWN
SHT #

M6

DWN JWDCKO MAC
DATE: 1/83
C6.0.153



MICROFILMED
DATE: 2/83
MICROFILM NUMBER: