



SYM.	ITEM	WASTE	VENT	SUPPLIES
WC-1	WATER CLOSET	4"	2"	1/2" CW
U-1	URINAL	2"	1 1/2"	1" CW
L-1/2	LAVATORY	1 1/2"	1 1/4"	1/2" THW
SS-1	SERVICE SINK	3"	2"	3/8" H&CW
S-1	KITCHEN SINK	2"	1 1/2"	3/8" H&CW
S-2	CRAFTS SINK	2"	1 1/2"	1/2" H&CW
S-3	DENTAL SINK	1 1/2"	1 1/4"	1/2" H&CW
ENC-1	ELECT. WATER COOLER	1 1/2"	1 1/4"	1/2" CW
DW-1	DISHWASHER	2"	1 1/2"	3/8" H&CW
TP-1	TRAP PRIMER	—	—	1/2" CW
FD	FLOOR DRAIN	2"	—	—

JANET MATHESON ARCHITECT
 P.O. BOX 81038
 FAIRBANKS,
 ALASKA 99708
 (907) 452-4640


**CITY OF FAIRBANKS
 SENIOR CITIZENS RECREATION
 & NUTRITION CENTER**

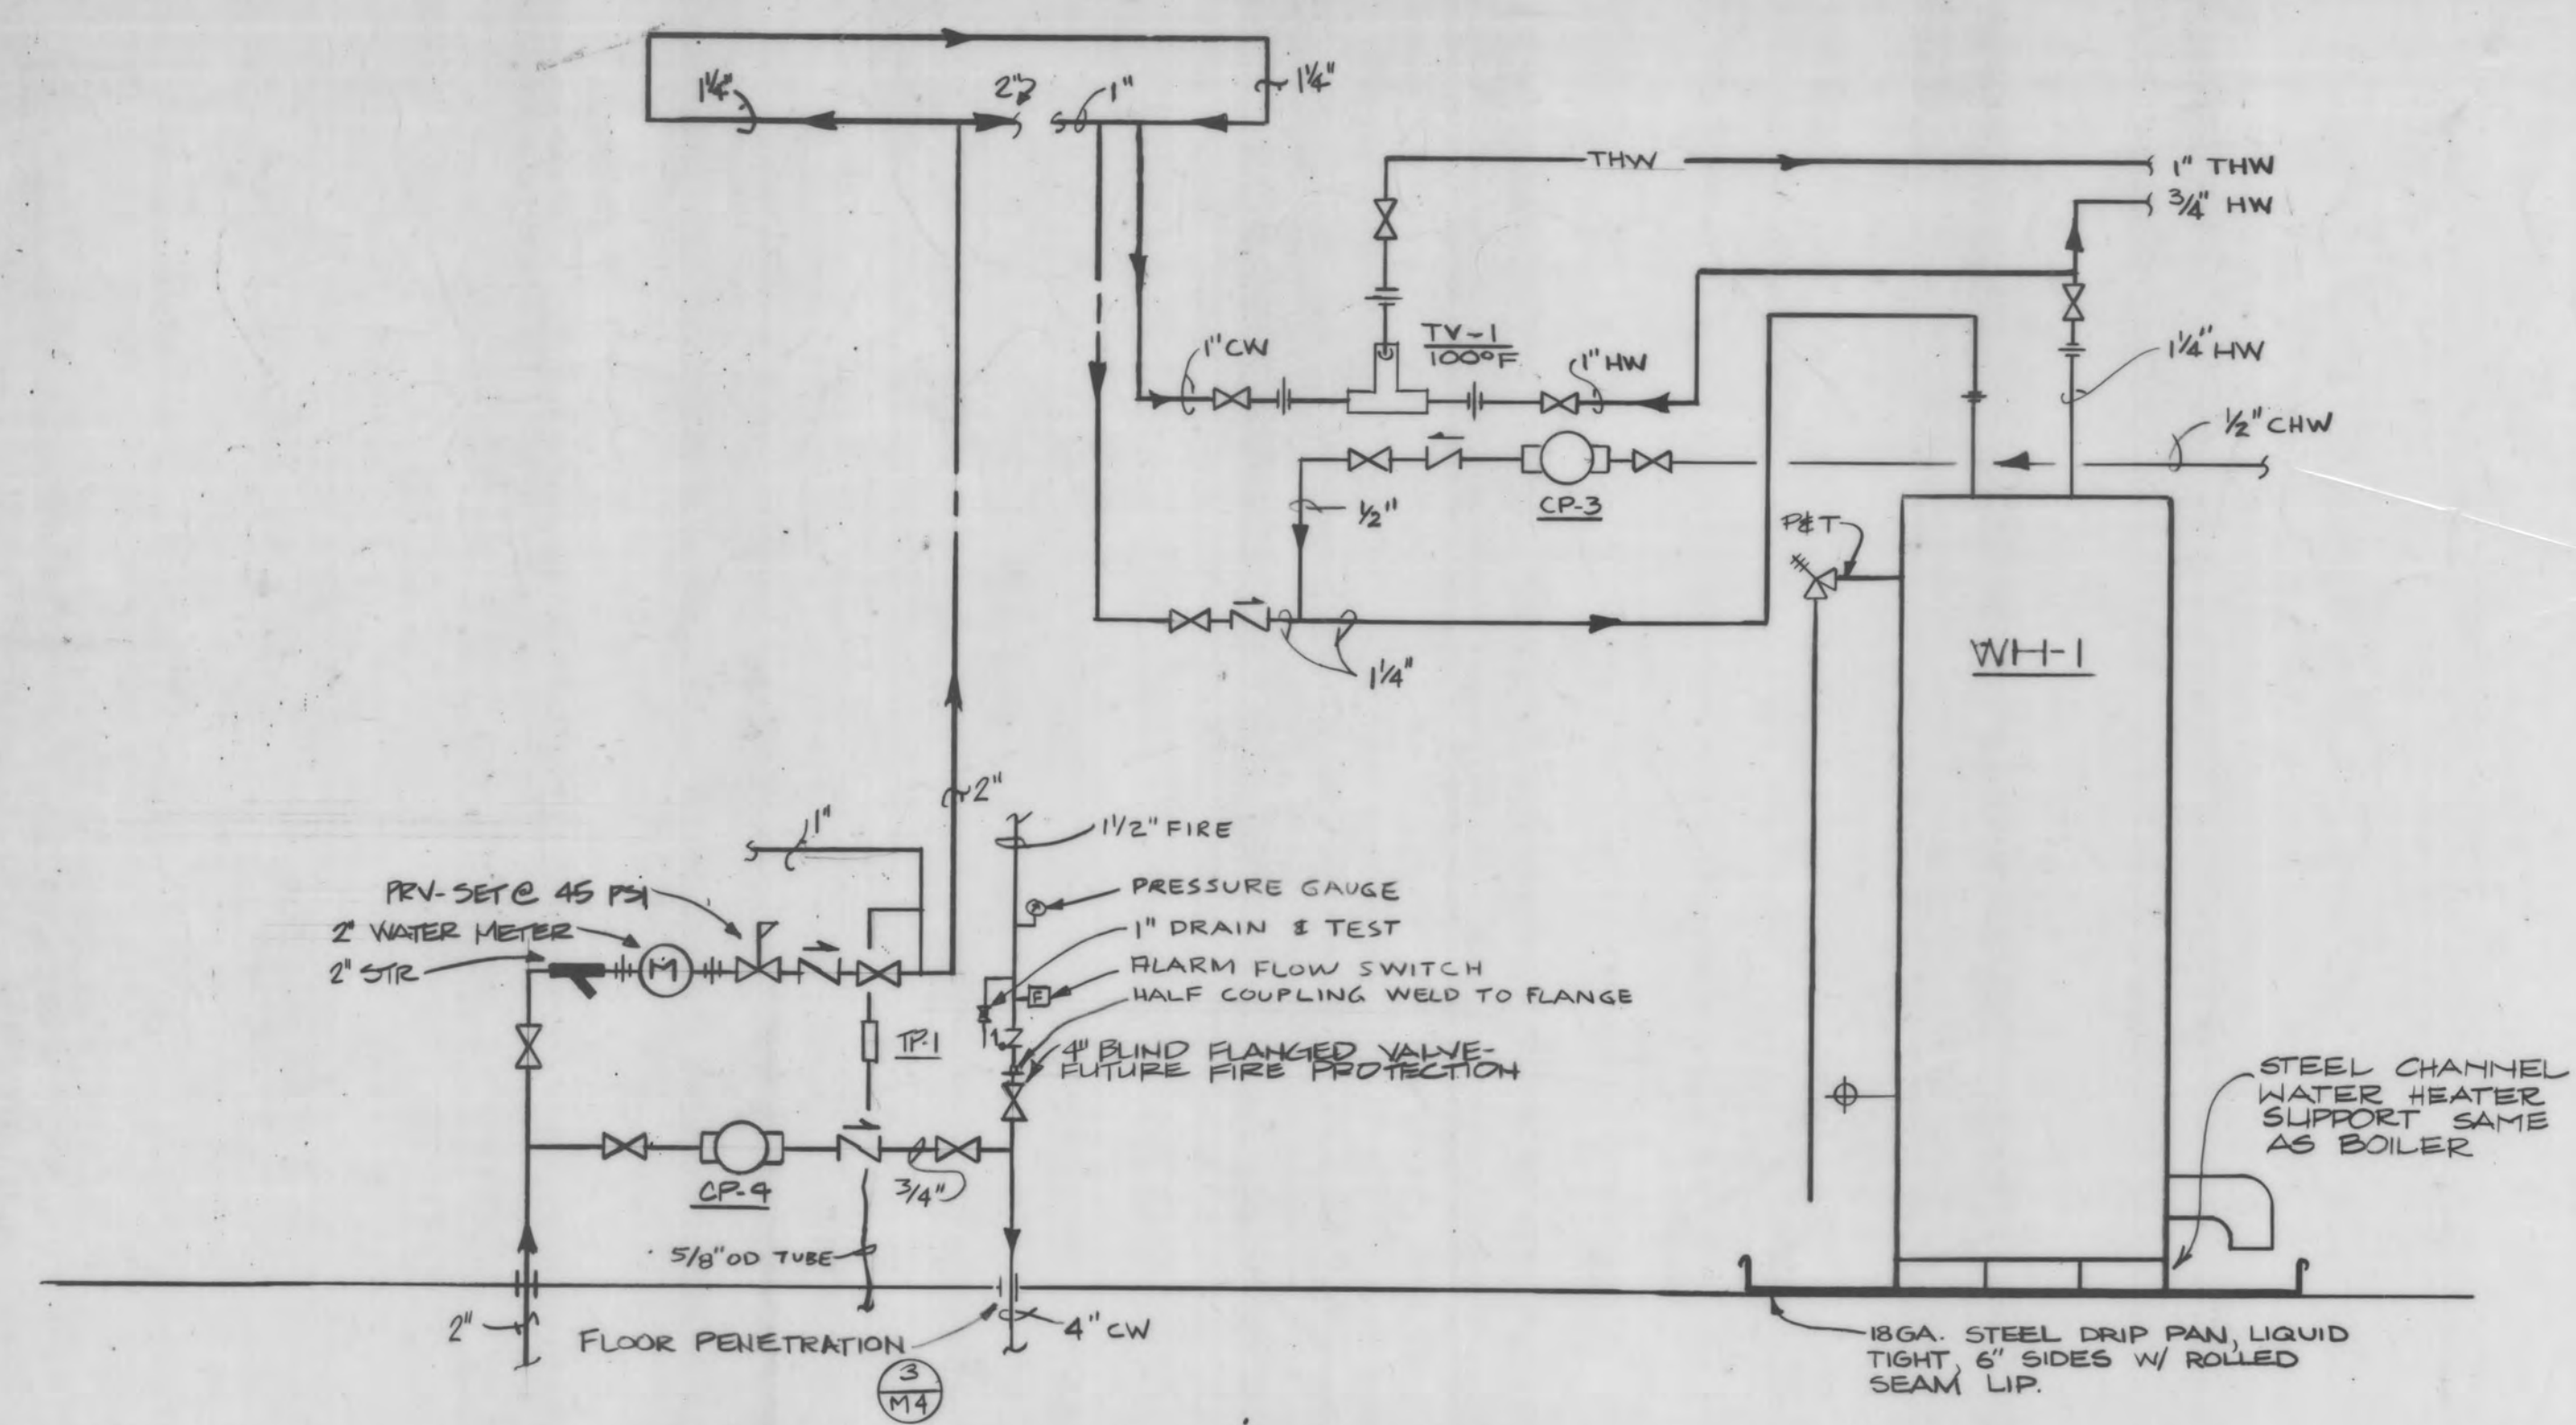


1 M4 DOMESTIC WATER FLOW DIAGRAM

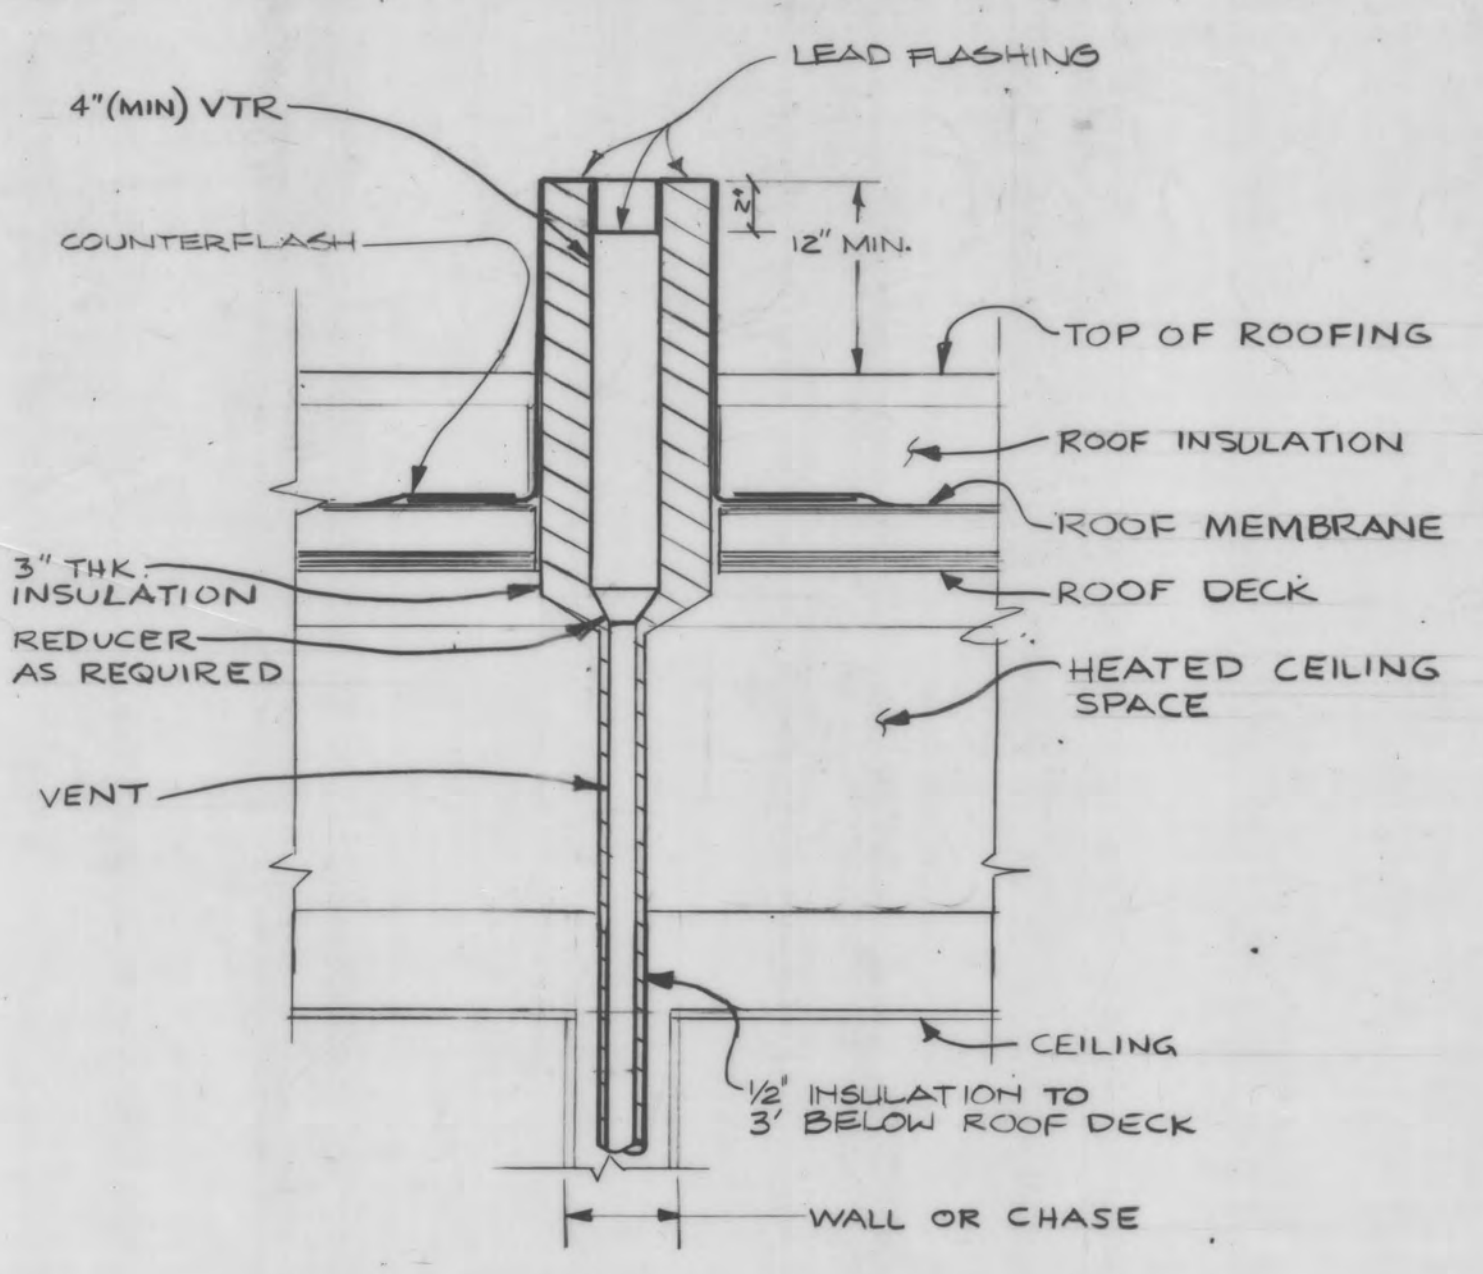


2 M4 VTR DETAIL

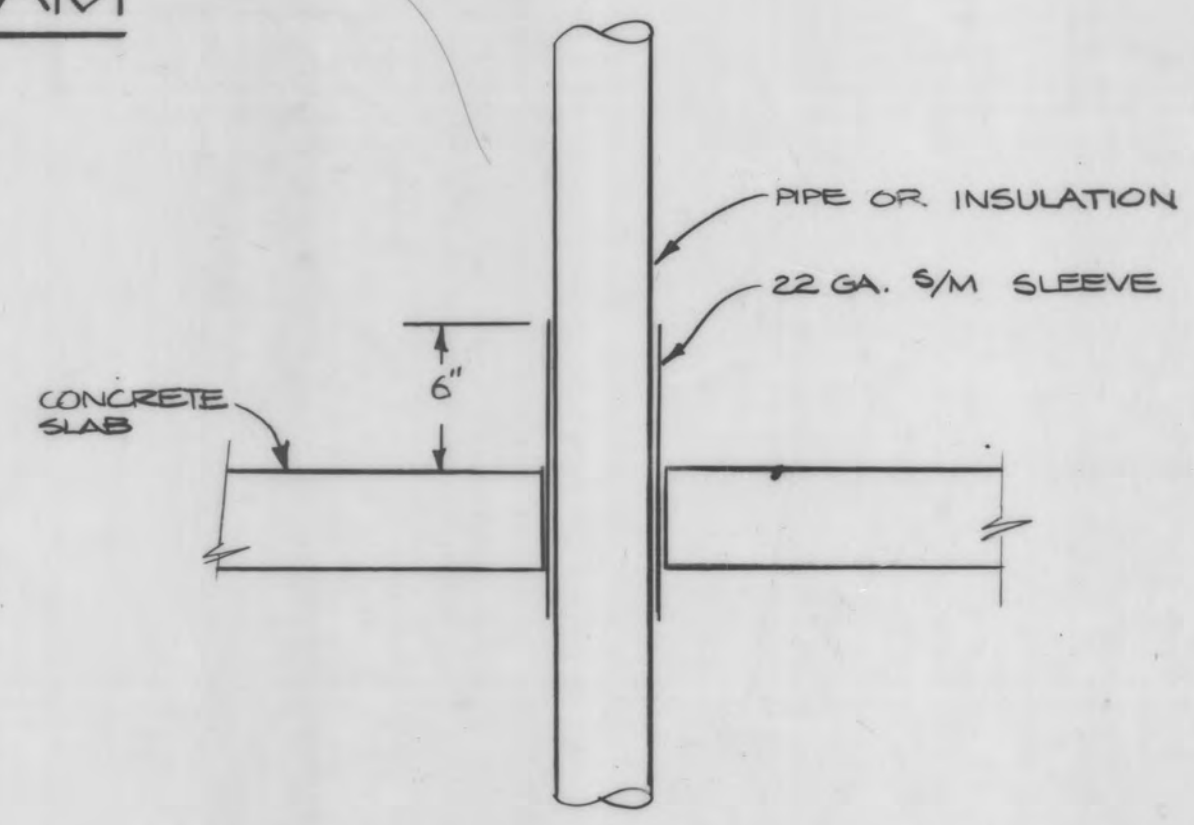

3 M4 FLOOR PENETRATION NTS

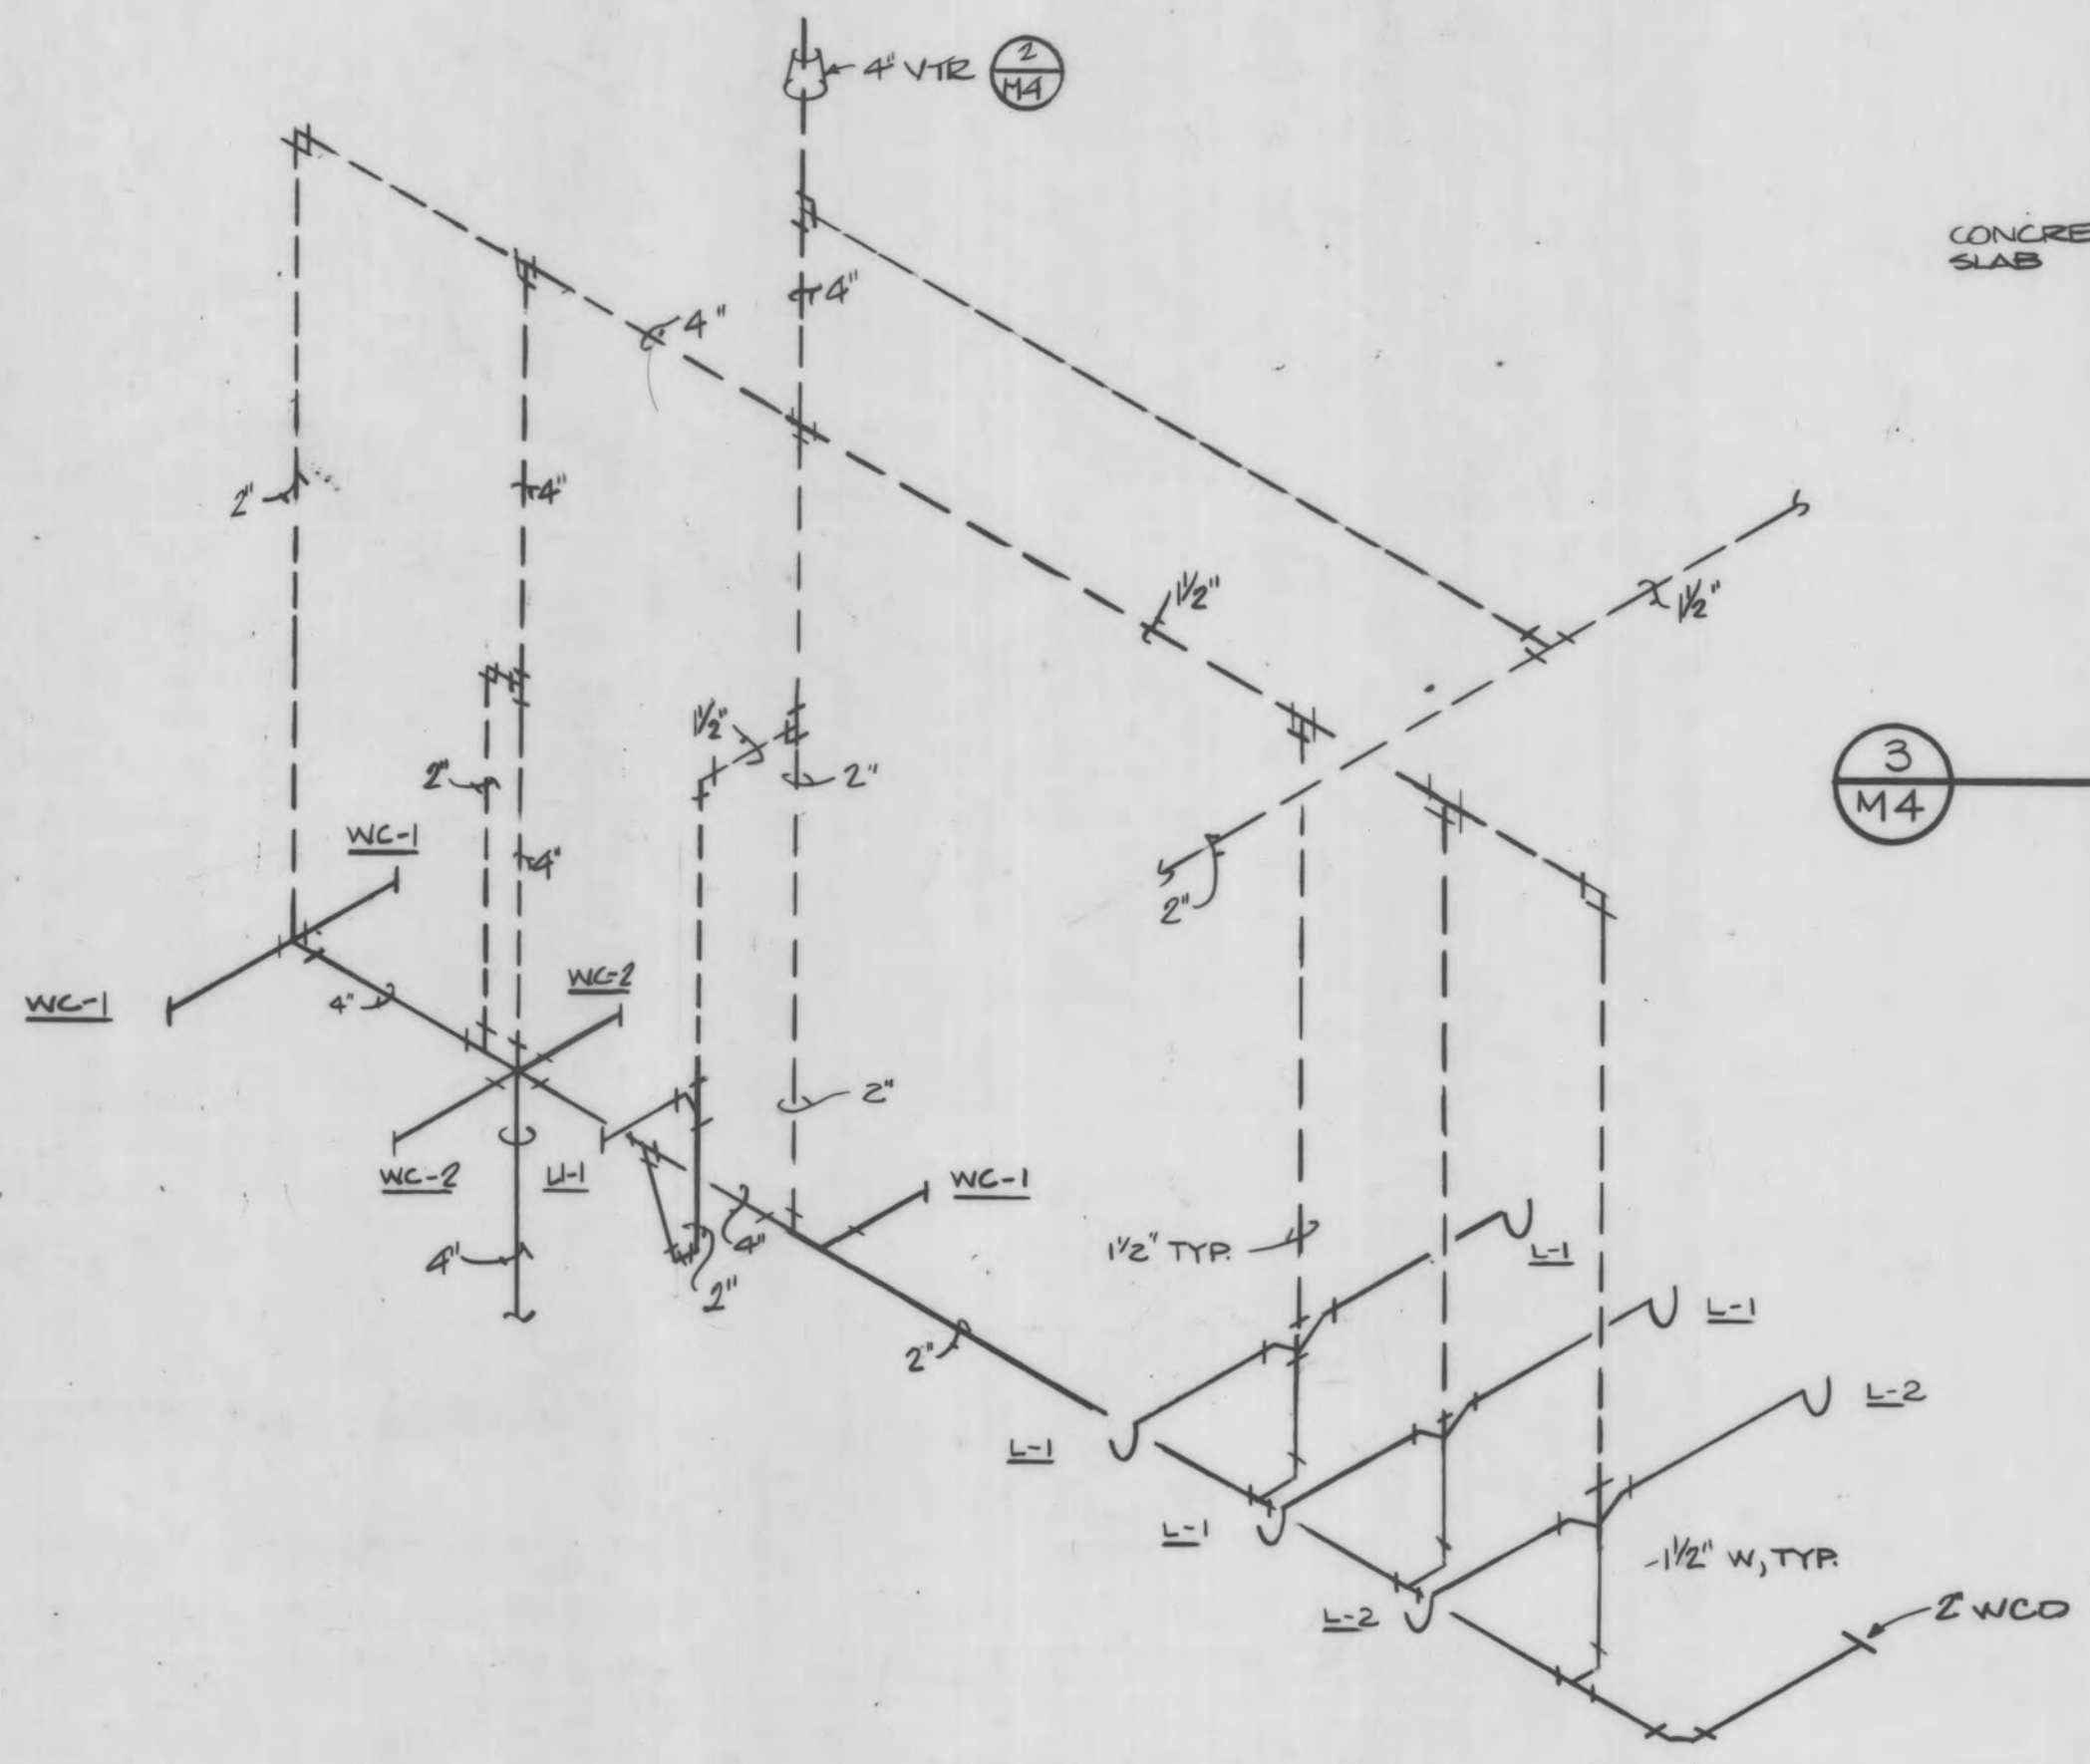

4 M4 WASTE & VENT RISER DIAGRAM

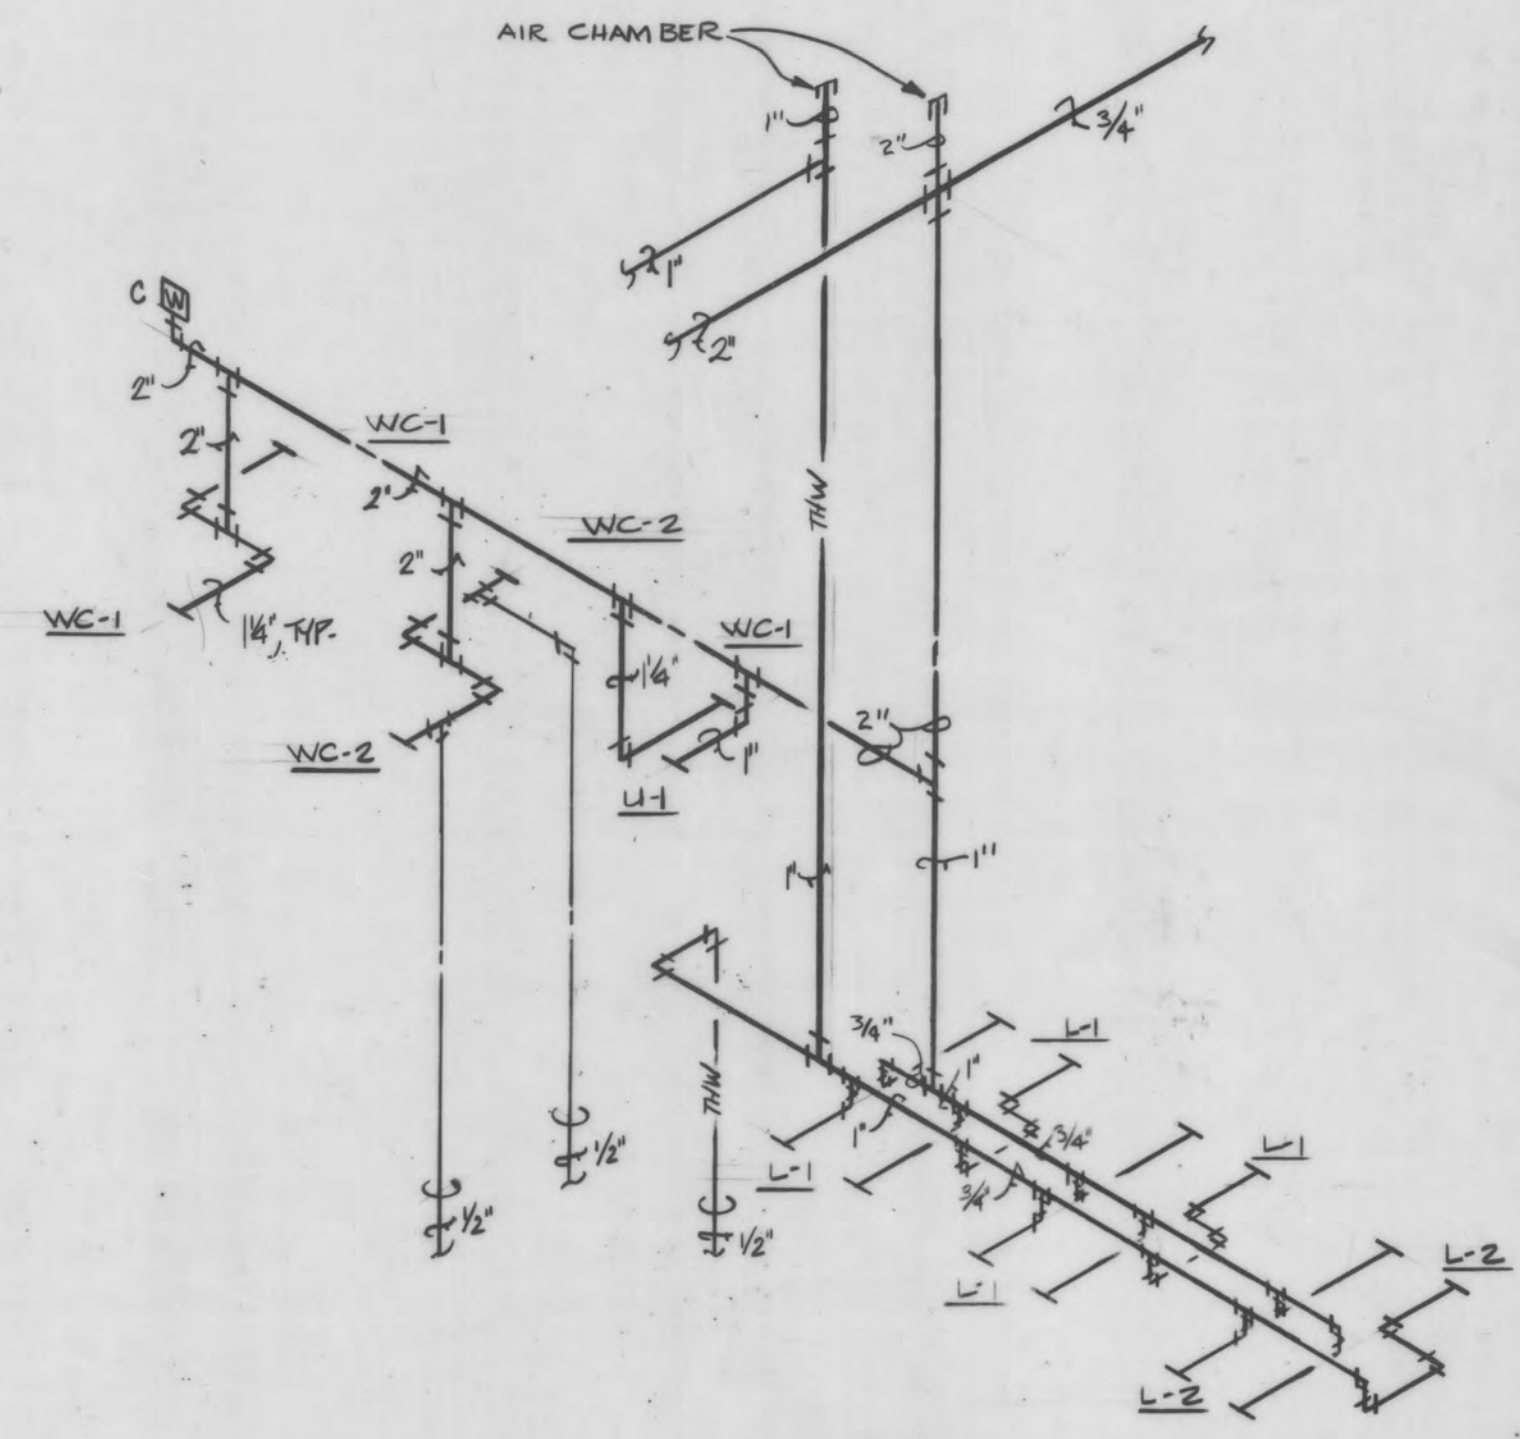

5 M4 DOMESTIC WATER RISER DIAGRAM

AS BUILT 12-23-80

PLUMBING DETAILS
 REBID
 NO SCALE

SHT #
M4
 DWN JWD CKD H&C
 DATE: 7-80 PROJ #:



Ellerbe

MICROFILMED
 DATE: 12/83
 MICROFILM NUMBER:

C6.0.155