


**JANET
MATHESON
ARCHITECT**

P.O. BOX 81038
FAIRBANKS,
ALASKA 99708
(907) 452-4640

**CITY OF FAIRBANKS
SENIOR CITIZENS RECREATION
& NUTRITION CENTER**

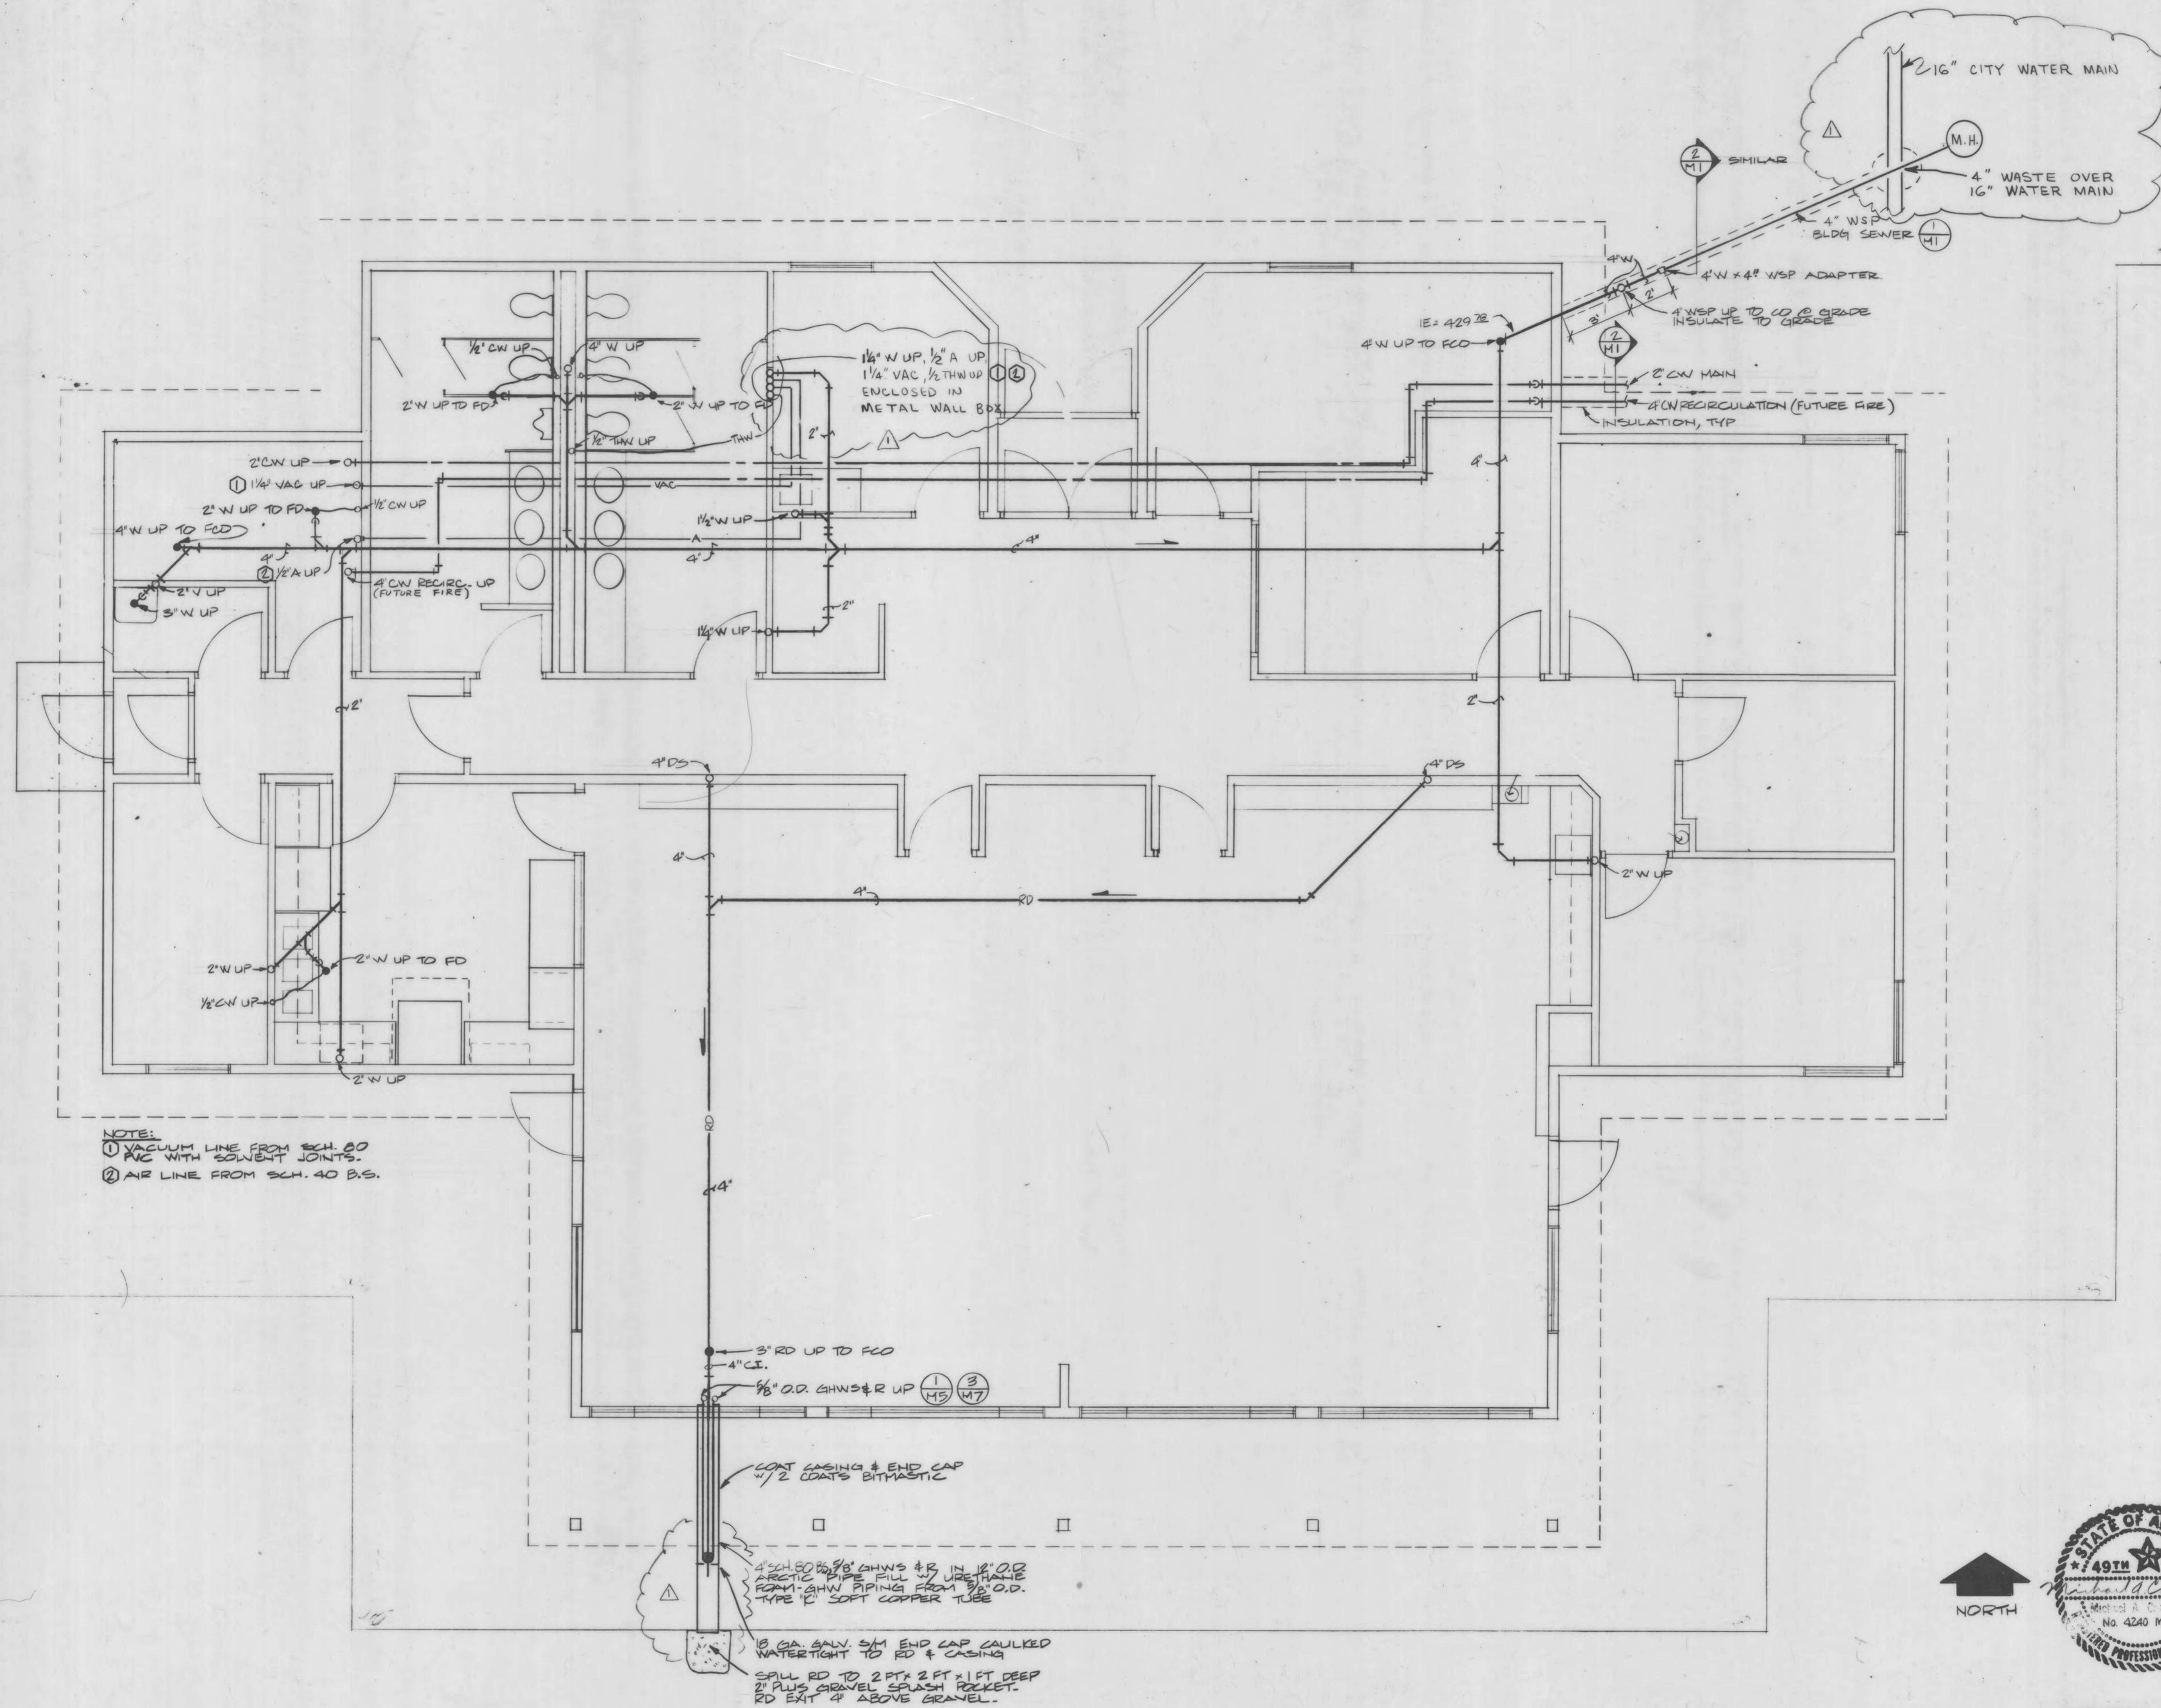

NOTE:
① VACUUM LINE FROM SCH. 80
X/C WITH SOLWELT JOINTS.
② AIR LINE FROM SCH. 40 B.S.

3\"/>

12-23-80

AS BUILT
PLUMBING
FOUNDATION PLAN
REBID
SCALE: 1/4\"/>

M2

DWN JWP CKD MAC
DATE 2-1-80 PROJ # 771

CG.0.157



Ellerbe
MICROFILMED
DATE: 12/83
MICROFILM NUMBER: