

FIRE HYDRANT  
ELEV. 426.22

JANET  
MATHESON  
ARCHITECT  
  
P.O. BOX 81038  
FAIRBANKS,  
ALASKA 99708  
(907) 452-4640

CITY OF FAIRBANKS  
SENIOR CITIZENS RECREATION  
& NUTRITION CENTER

12-23-80

AS BUILT

SCALE: AS SHOWN  
SHT #

M1  
REBID


OWN JWP CKD MAC  
DATE 2-7-80-ROJ #

C6.0.158




Ellerbe

MICROFILMED  
DATE: 12/83  
MICROFILM NUMBER:

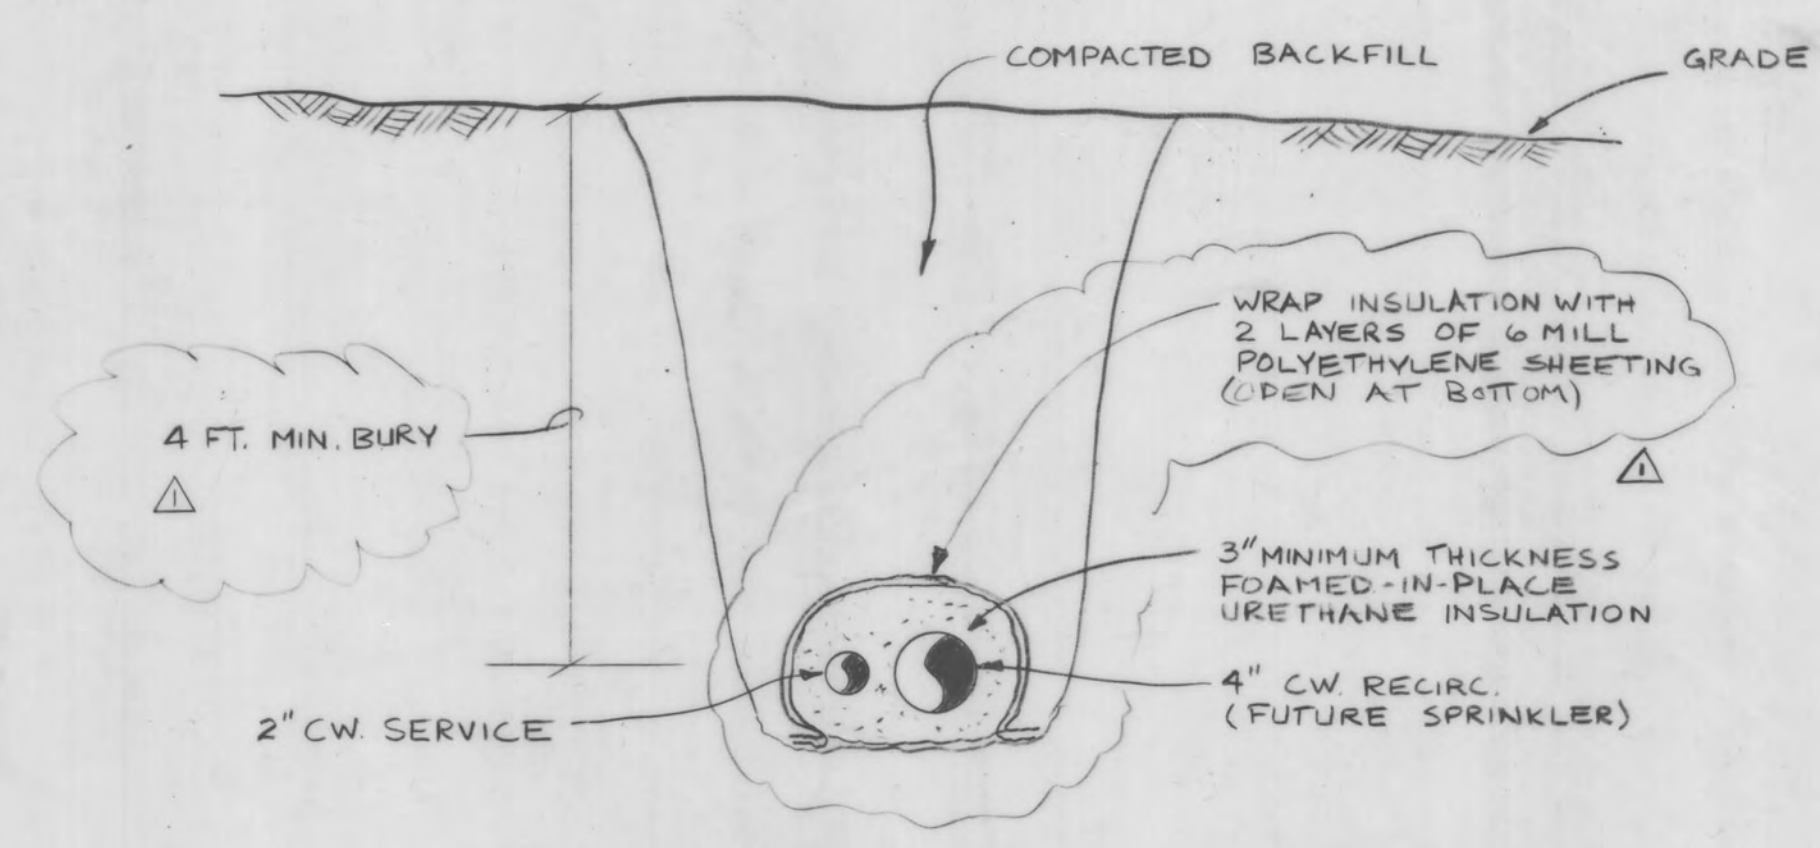

2 BLDG. WATER SERVICE SECTION  
M1 NTS.

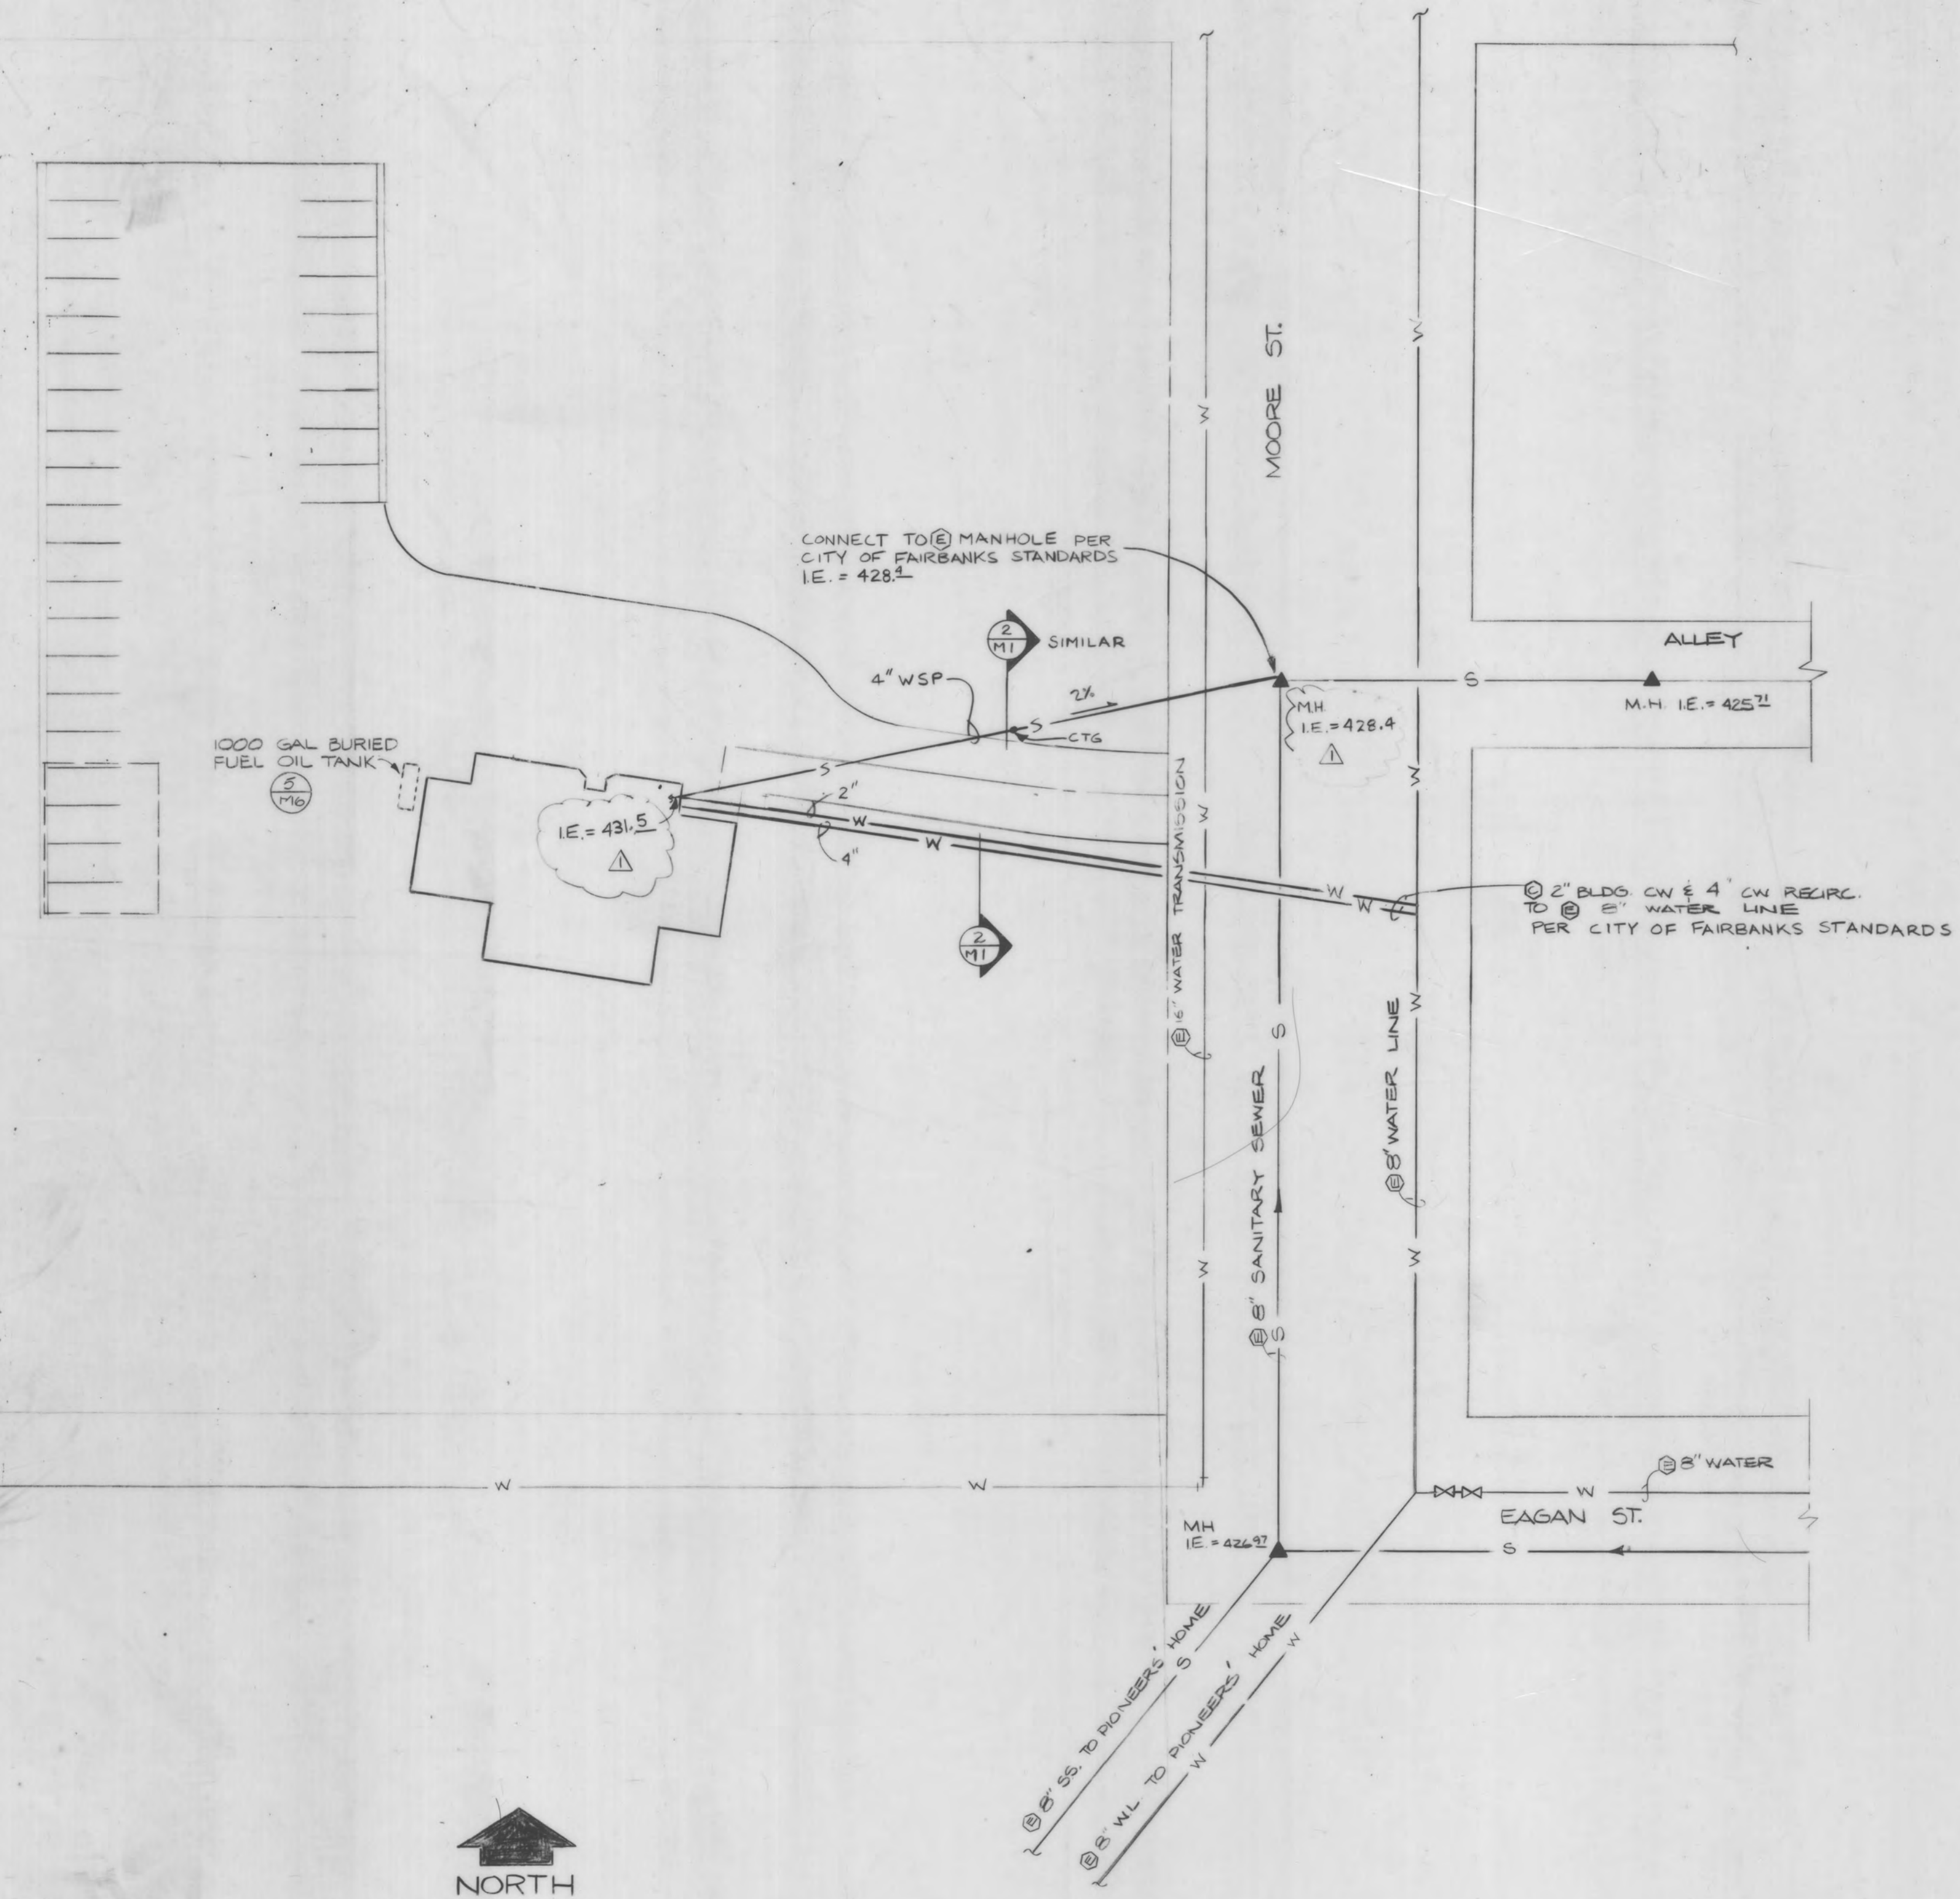

1 MECHANICAL SITE PLAN  
M1 SCALE: 1" = 30'