



**CITY OF FAIRBANKS
SENIOR CITIZENS RECREATION
& NUTRITION CENTER**

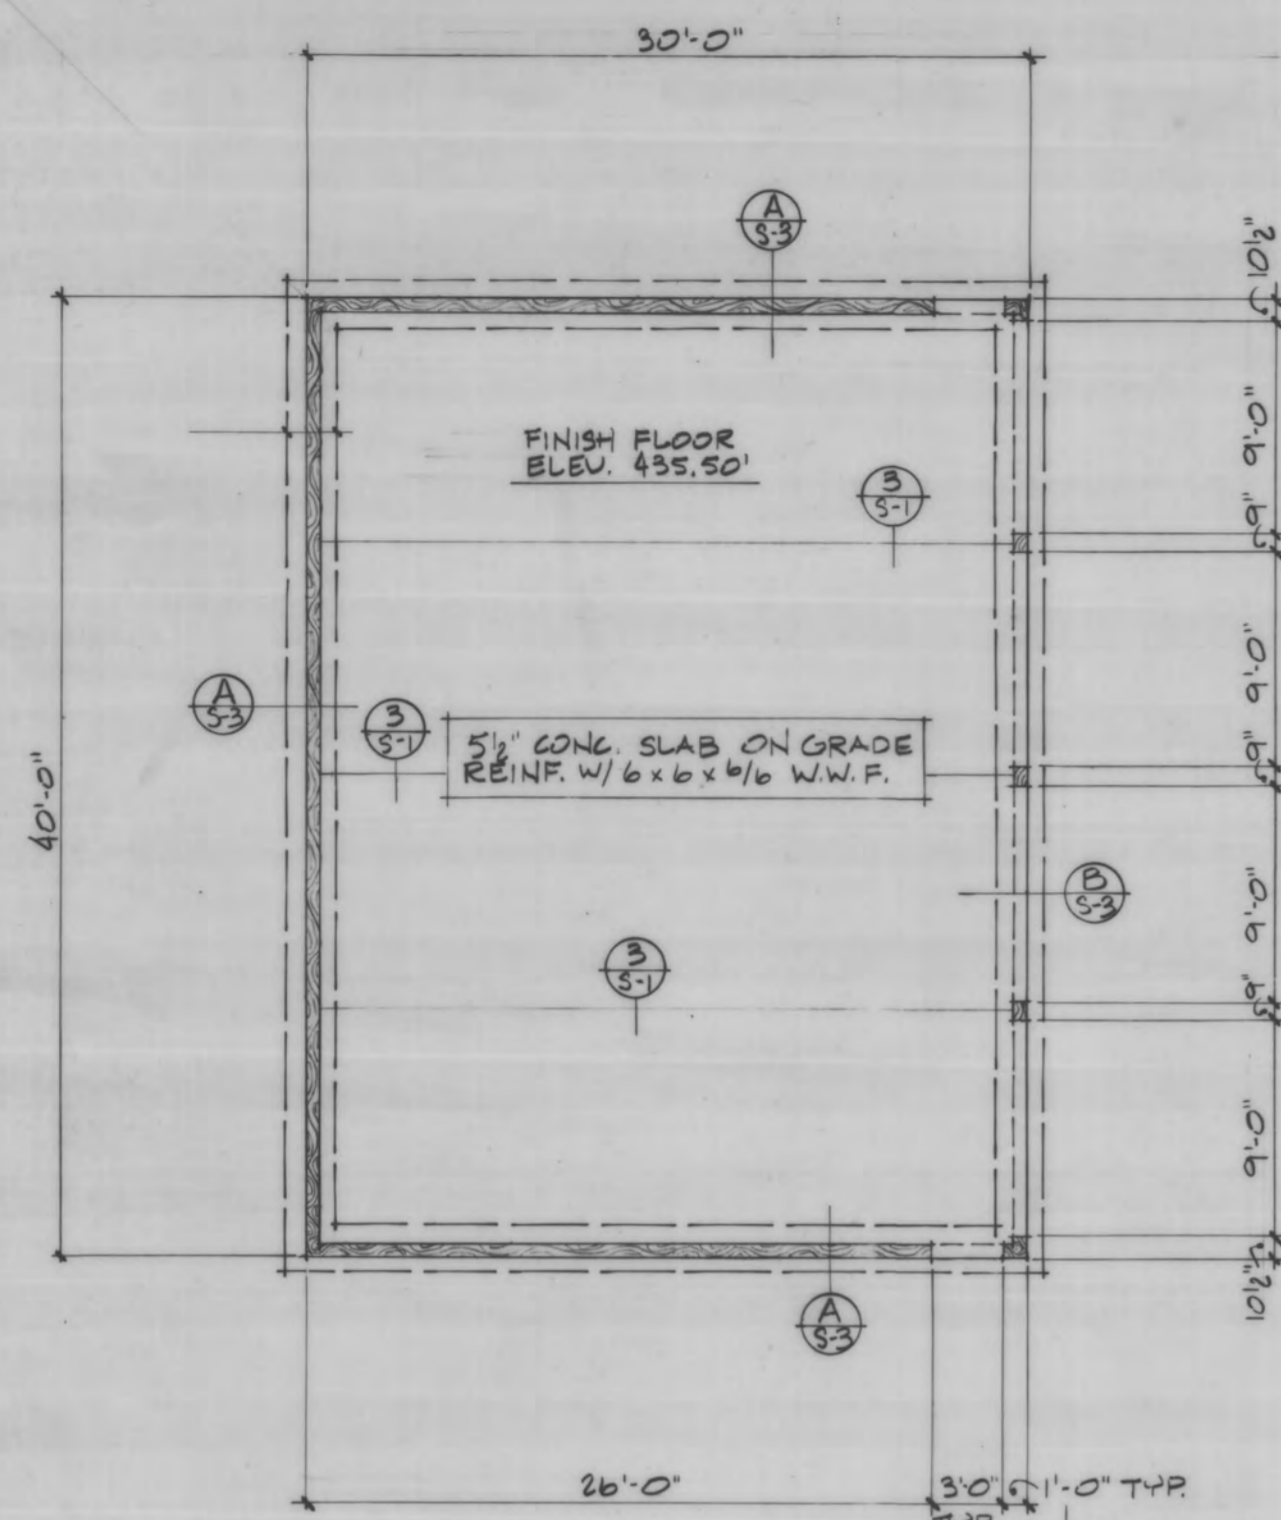


FOUNDATION PLAN
6" = 1'-0"

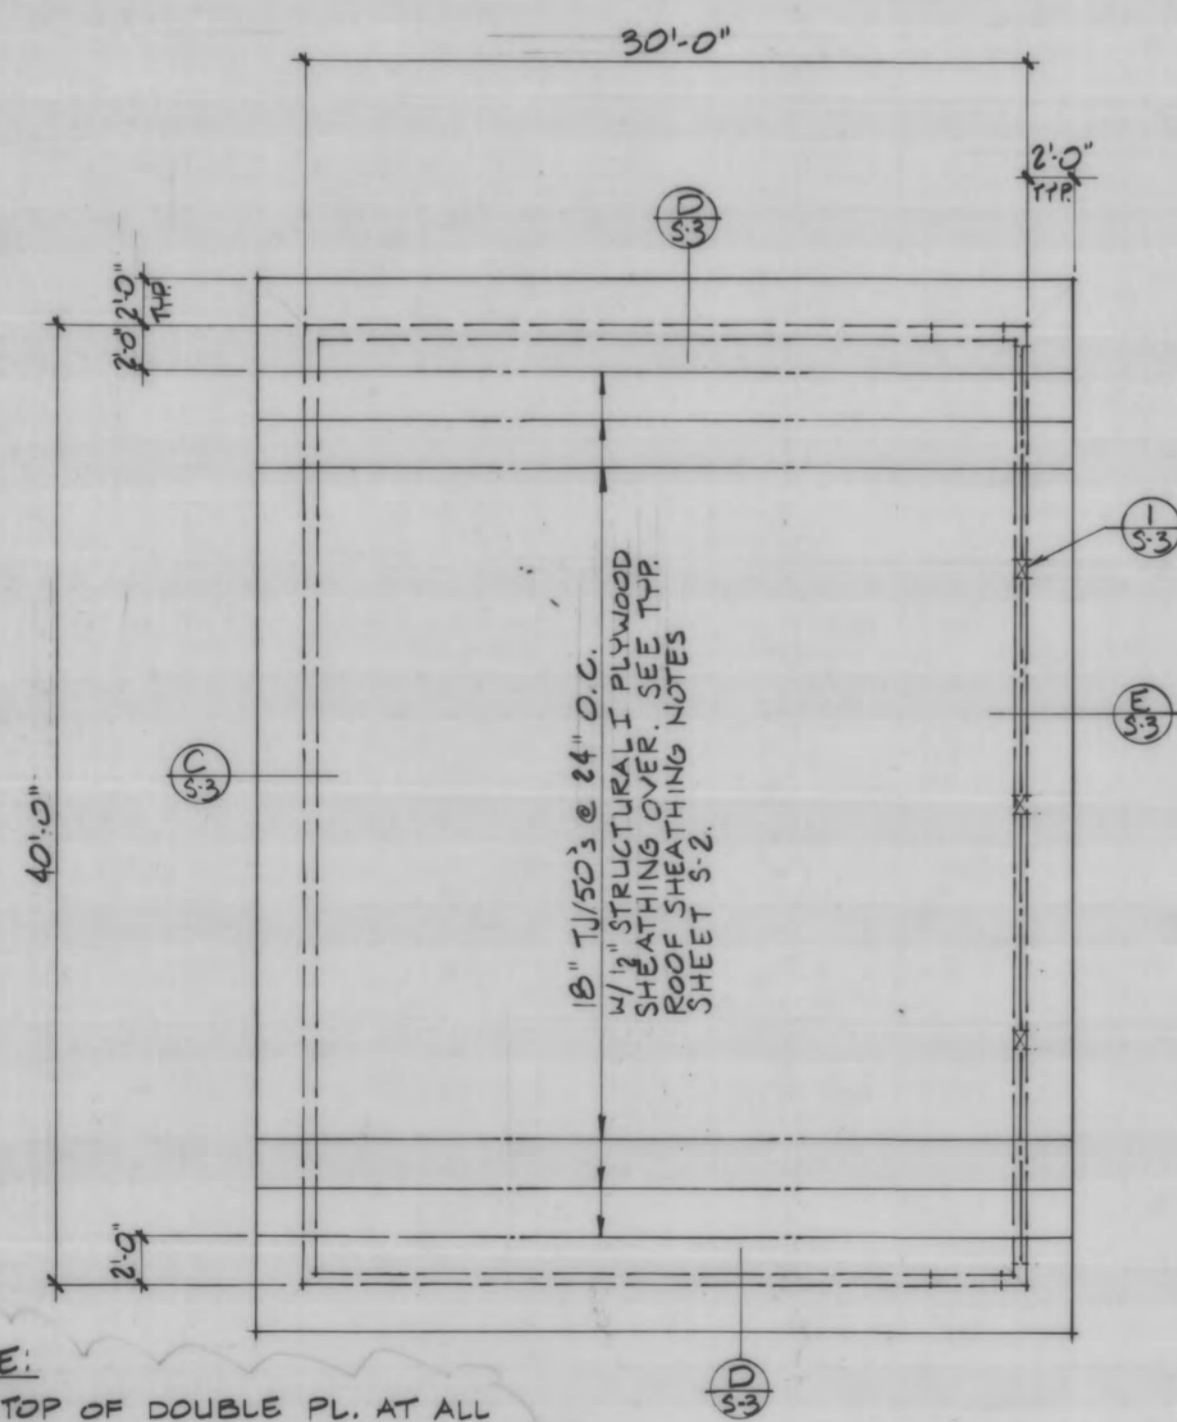


ROOF FRAMING PLAN
6" = 1'-0"


NOTE:
TYP TOP OF DOUBLE PL. AT ALL EXTERIOR WALLS EL. 12'-2 1/2" FROM FINISH SLAB.

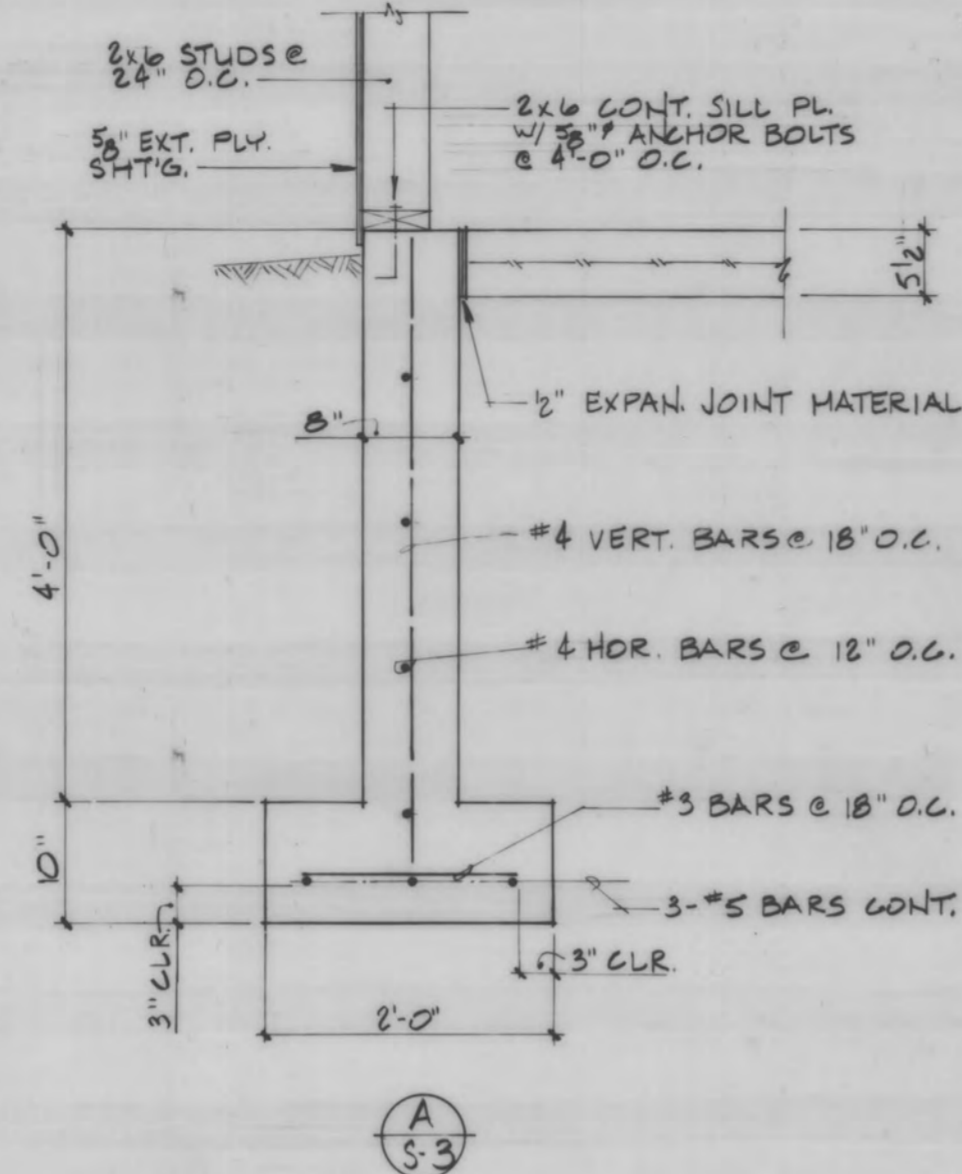


A
S-3

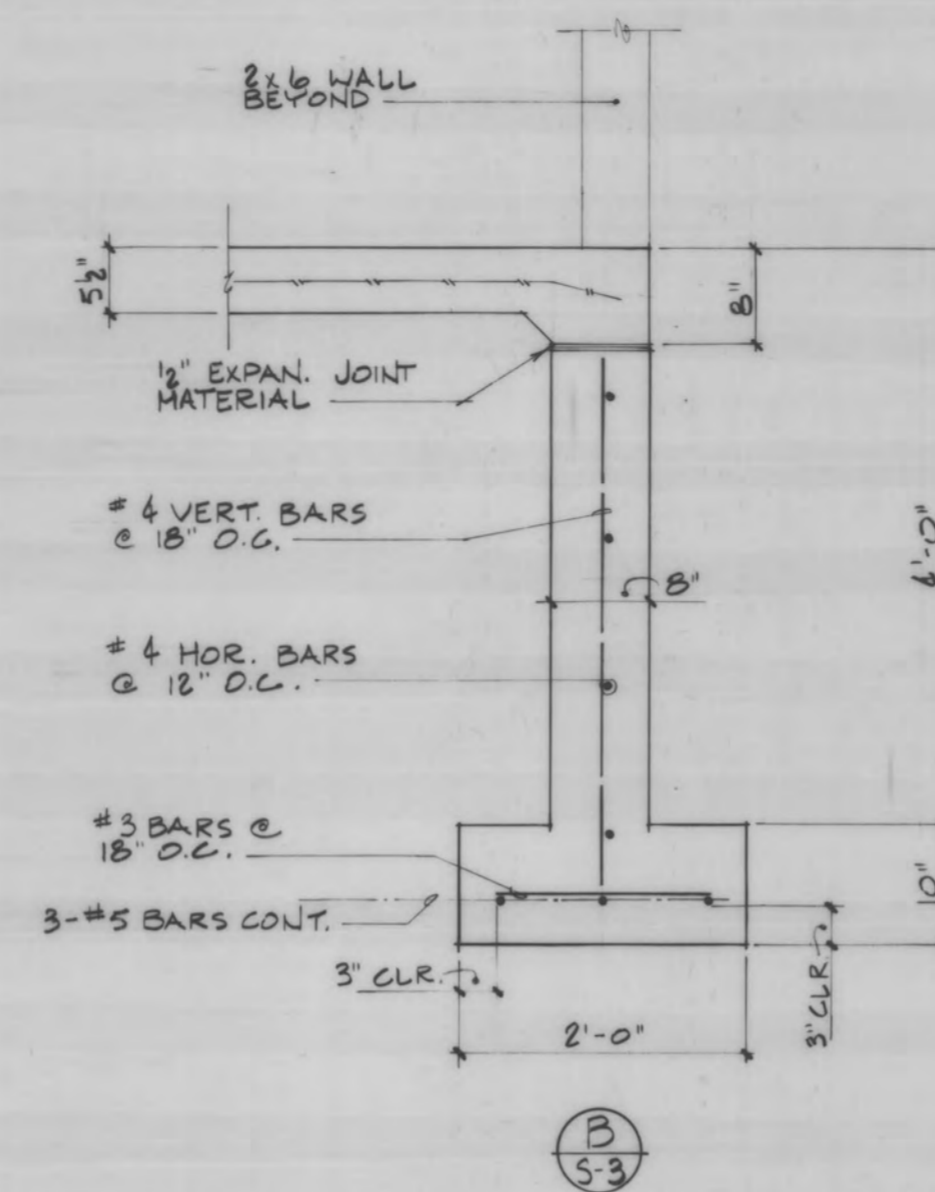


B
S-3

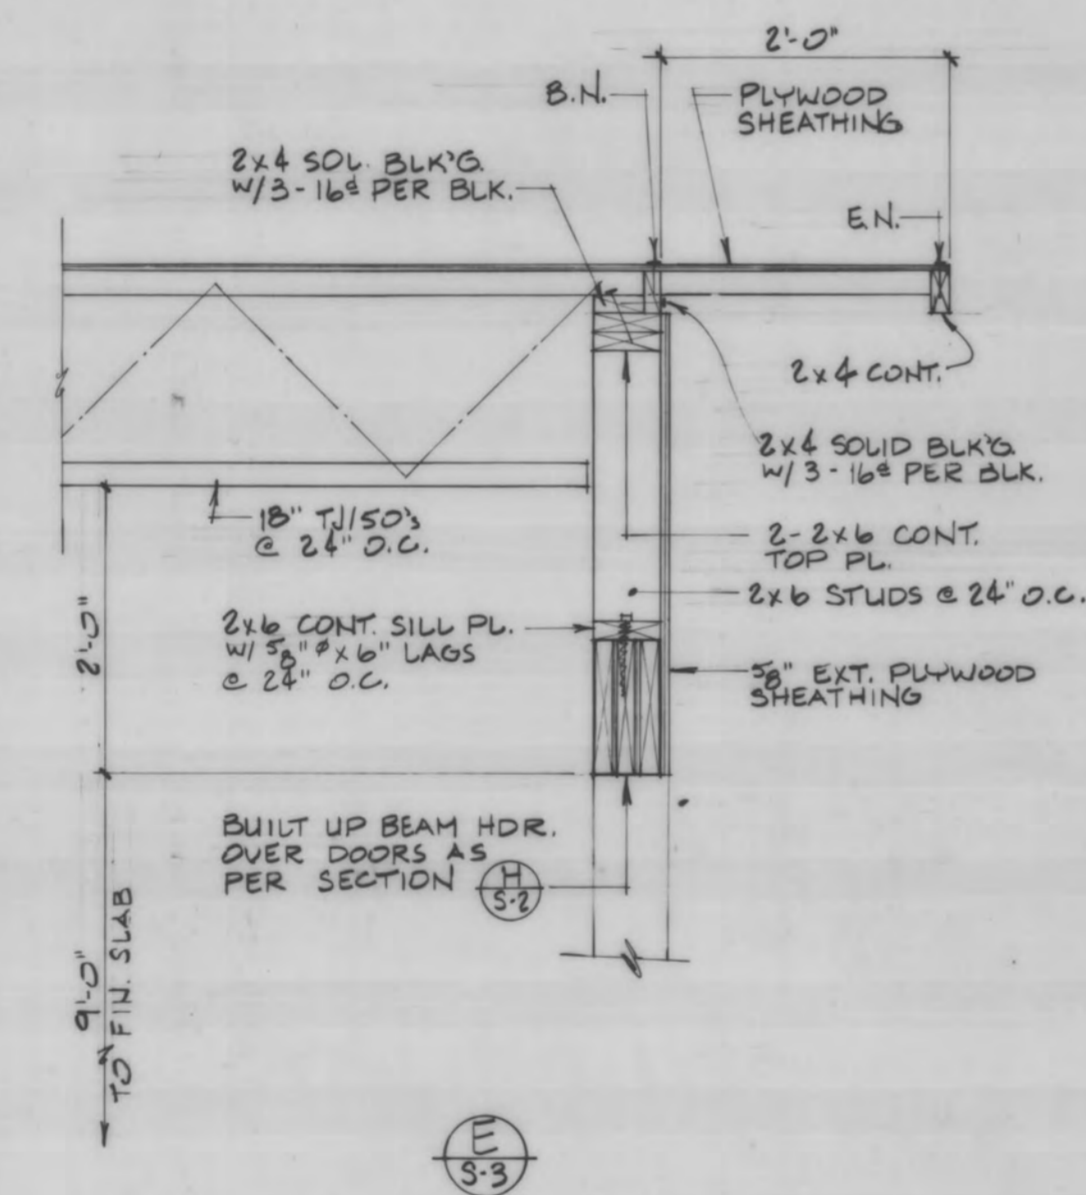


C
S-3

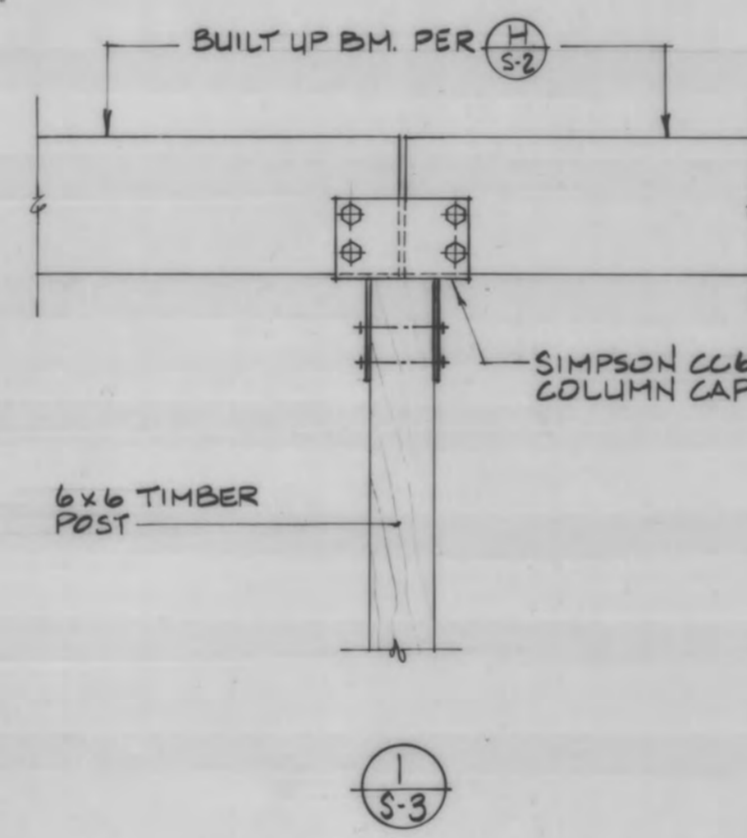

D
S-3

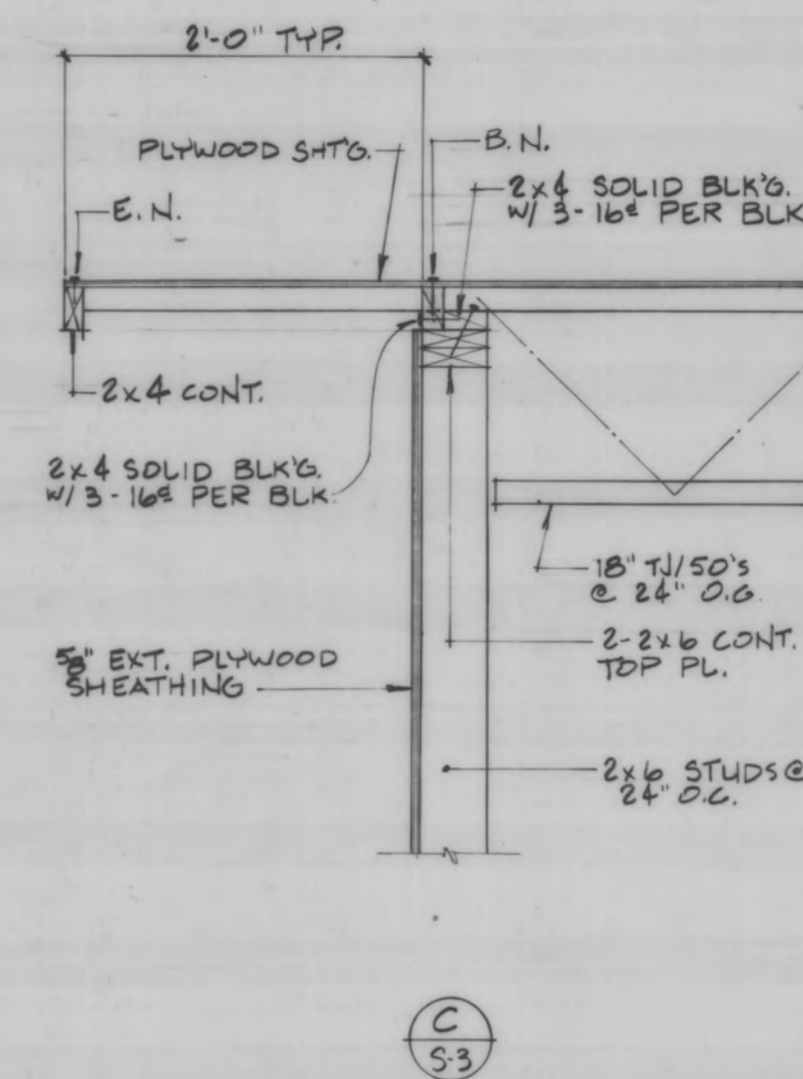

E
S-3

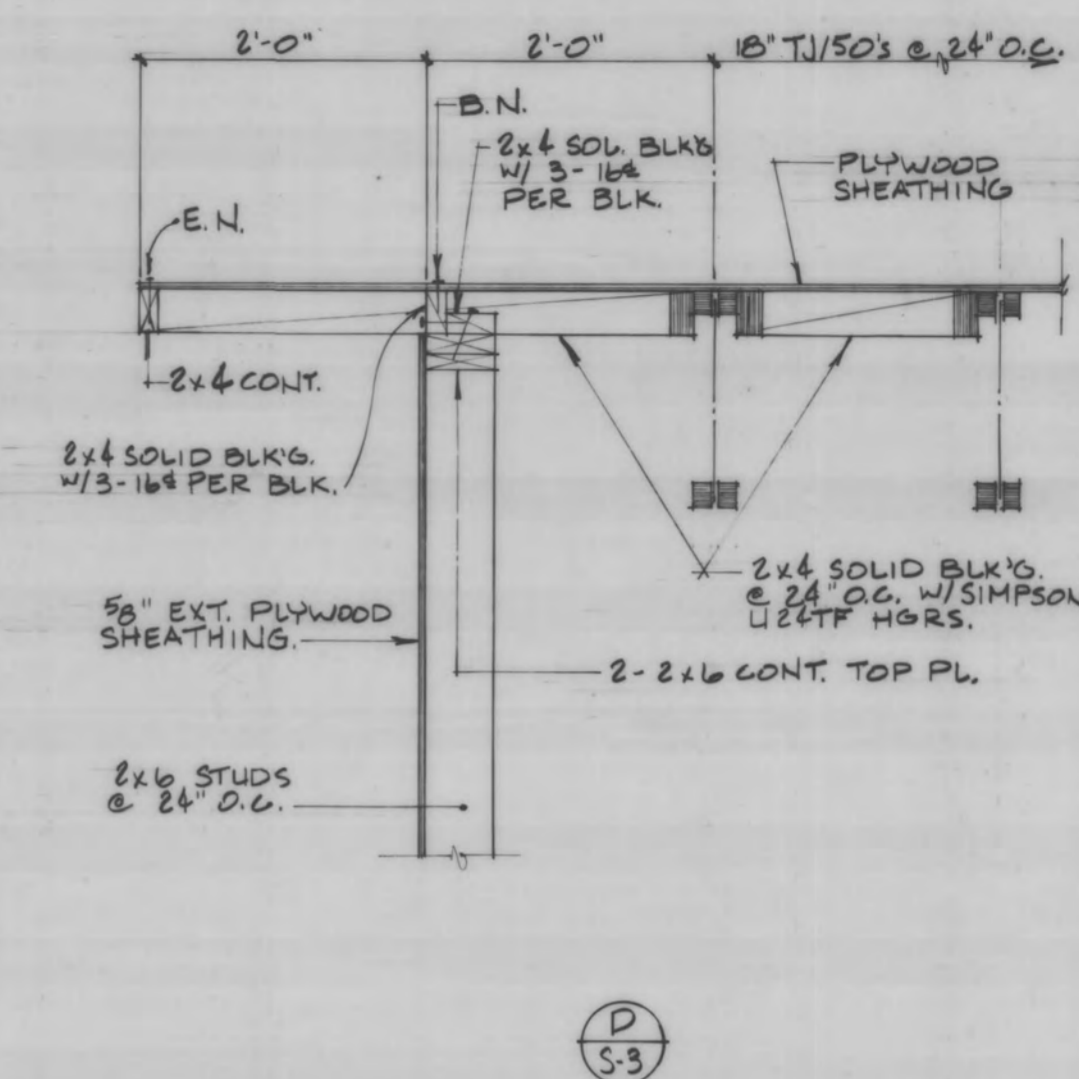

F
S-3

NOTE:
ALL SECTIONS AND DETAILS DRAWN @ 3/4" = 1'-0" UNLESS NOTED OTHERWISE.

"AS BUILT"
NO CHANGES REPORTED BY CONTRACTOR AND/OR ARCHITECT.
M. E. Herring 2/2/82

Bell, Herring and Associates
Engineering and Land Surveying
P. O. Box 73678, Fairbanks, AK 99707
(907) 452-5198

MICROFILMED
DATE: 12/83
MICROFILM NUMBER:

SHT #

S-3

OF 3

REBID

DWN LKH CKD JSC

DATE: 2-22-80 PROJ #

C6.0.159