




C. LEMARCHAND KENNEDY AND ASSOCIATES:
envirodesign
 ARCHITECTURE, PLANNING, ENERGY MANAGEMENT
 1327 KALAKAKET, FAIRBANKS, ALASKA 99701 (907) 479-3193

REVISIONS:
 PROJECT NO.
 DATE: JULY 2, 1986
 DRAWN: R-LJ
 CHECKED: RBB
 CONTENTS:
 DEMOLITION PLAN
 SCALE: AS SHOWN

CITY OF FAIRBANKS
 SENIOR CITIZENS RECREATION
 AND NUTRITION CENTER ADDITION

DRAWING NO.
E4

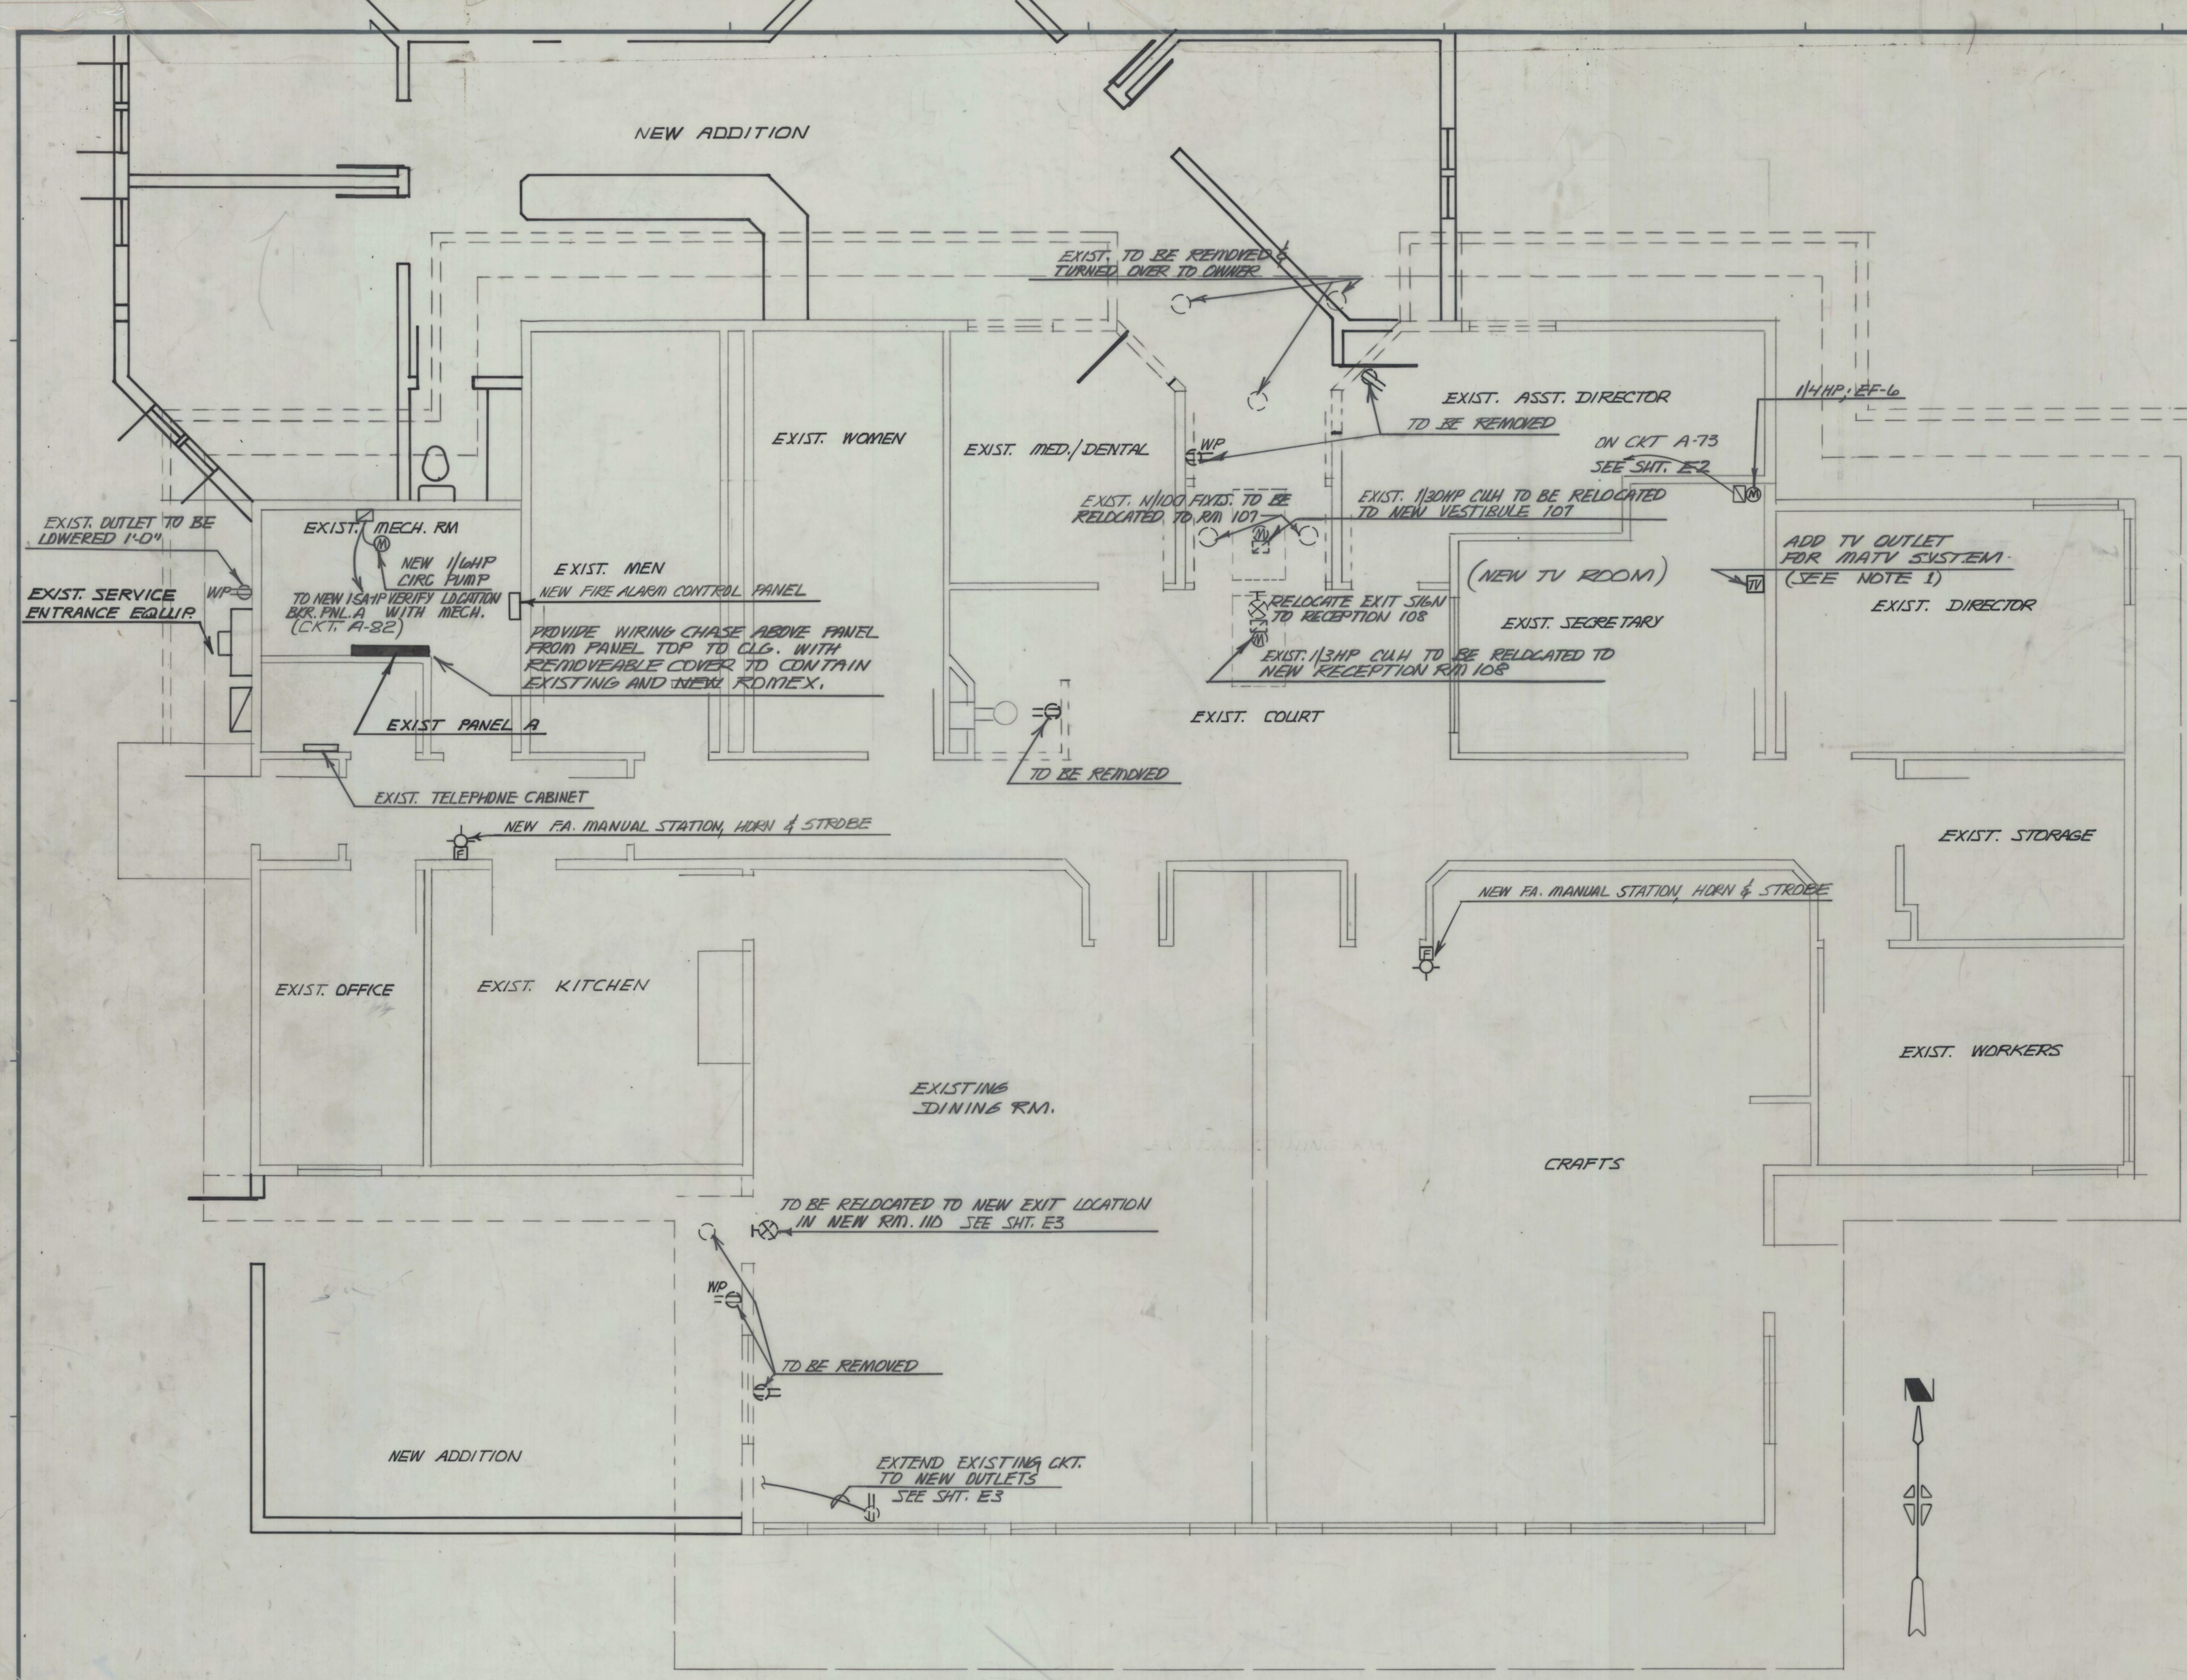

ELECTRICAL DEMOLITION PLAN
 SCALE 1/4" = 1'-0"

DASH LINES INDICATE EXIST. ITEMS TO BE REMOVED.

RECORD DRAWING
 THIS RECORD DRAWING HAS BEEN PREPARED FROM INFORMATION FURNISHED BY THE CONSTRUCTION CONTRACTOR AND THE ACCURACY AND COMPLETENESS OF SUCH INFORMATION IS NOT GUARANTEED.
 LAKE & BOSWELL, CONSULTING ELECTRICAL ENGINEERS, INC.



ENG7939.TIF

F8 10.027