



C. LEMARCHAND KENNEDY AND ASSOCIATES:
envirodesign
 ARCHITECTURE, PLANNING, ENERGY MANAGEMENT
 1327 KALAKAKE T, FAIRBANKS, ALASKA 99701 (907) 479-3193

REVISIONS:


PROJECT NO.
 DATE: 6/30/06
 DRAWN: WJU
 CHECKED: RC

CONTENTS:
 DETAILS


SCALE:

CITY OF FAIRBANKS
 SENIOR CITIZENS RECREATION
 & NUTRITION CENTER
 ADDITION

DRAWING NO.
S3
 OF 3

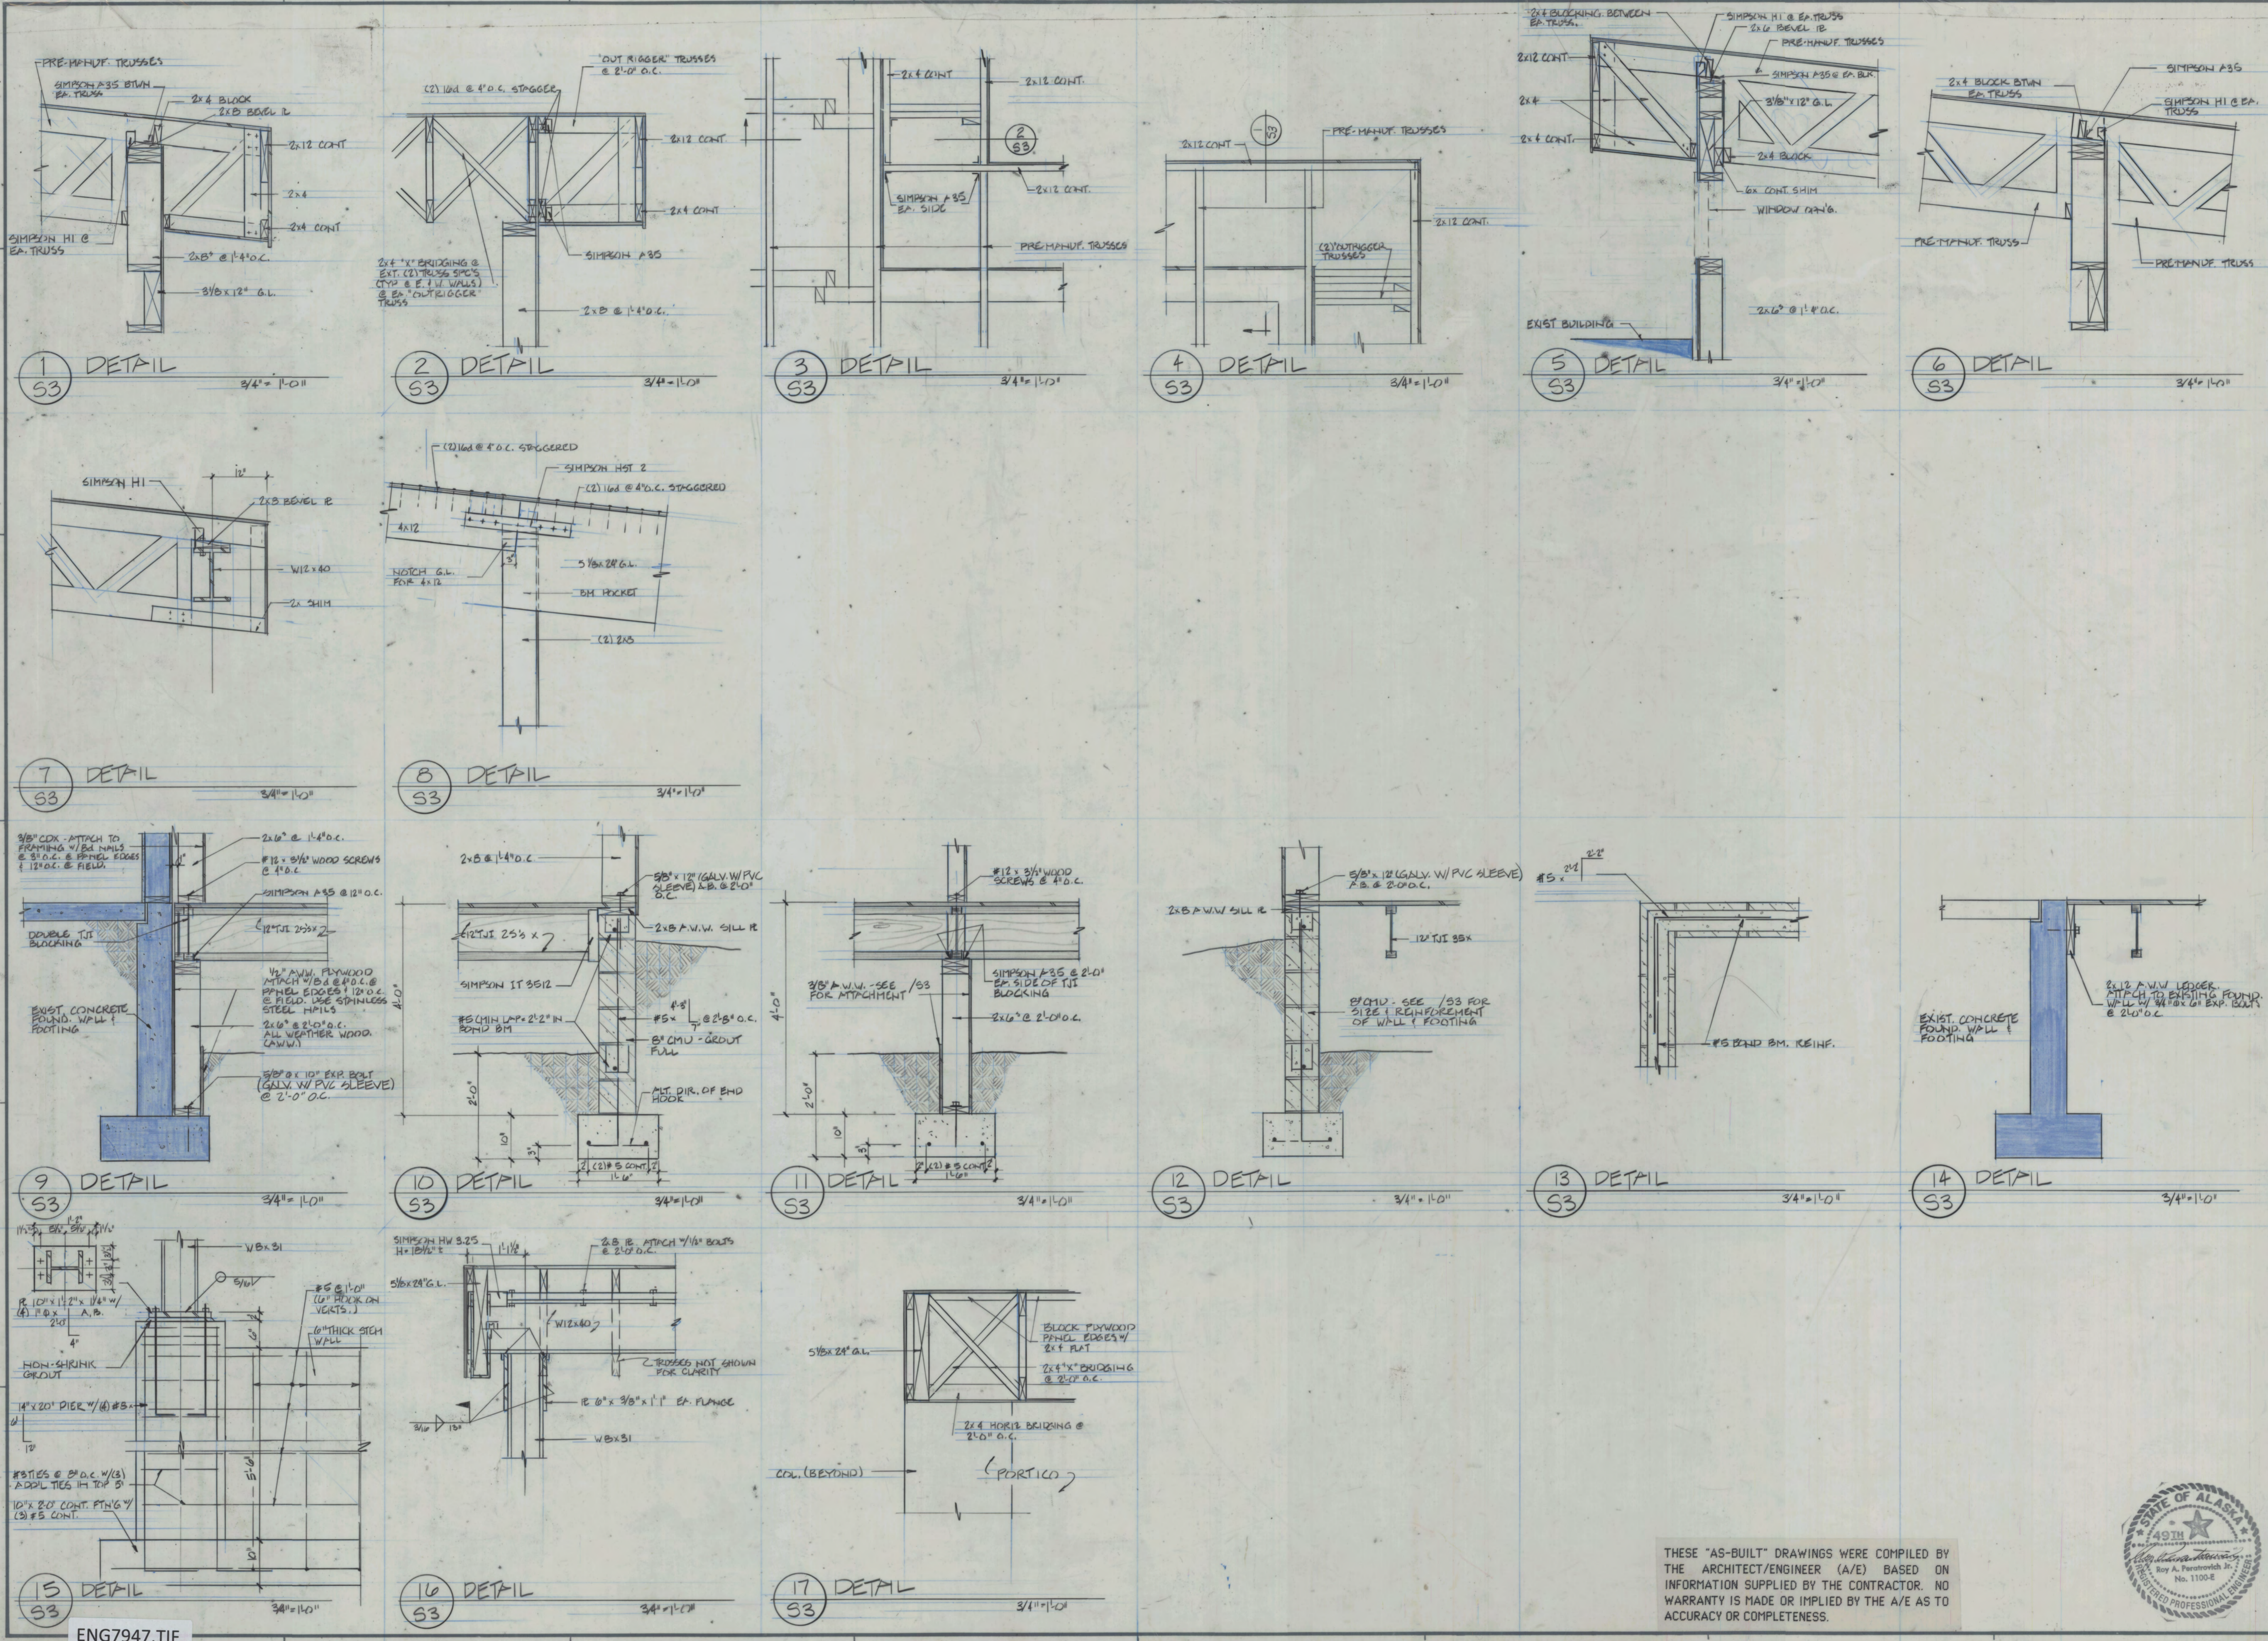

THESE "AS-BUILT" DRAWINGS WERE COMPILED BY THE ARCHITECT/ENGINEER (A/E) BASED ON INFORMATION SUPPLIED BY THE CONTRACTOR. NO WARRANTY IS MADE OR IMPLIED BY THE A/E AS TO ACCURACY OR COMPLETENESS.

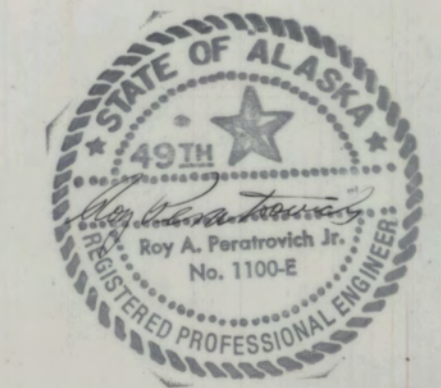

F8.0.035 36079