



C. LEMARCHAND KENNEDY AND ASSOCIATES:
envirodesign
 ARCHITECTURE, PLANNING, ENERGY MANAGEMENT
 1327 KALAKAKET, FAIRBANKS, ALASKA 99701 (907) 479-3193

REVISIONS:

PROJECT NO.
 DATE: 6/30/86
 DRAWN: W/JW
 CHECKED: RC



CONTENTS:
 ROOF FRAMING PLAN
 TYP. HEADER DETAIL
 TYP. ROOF DIAPHR. TYP. S.W. DETAILS SCALE

CITY OF FAIRBANKS
 SENIOR CITIZENS RECREATION & NUTRITION CENTER
 ADDITION

DRAWING NO.

S2




OF 3

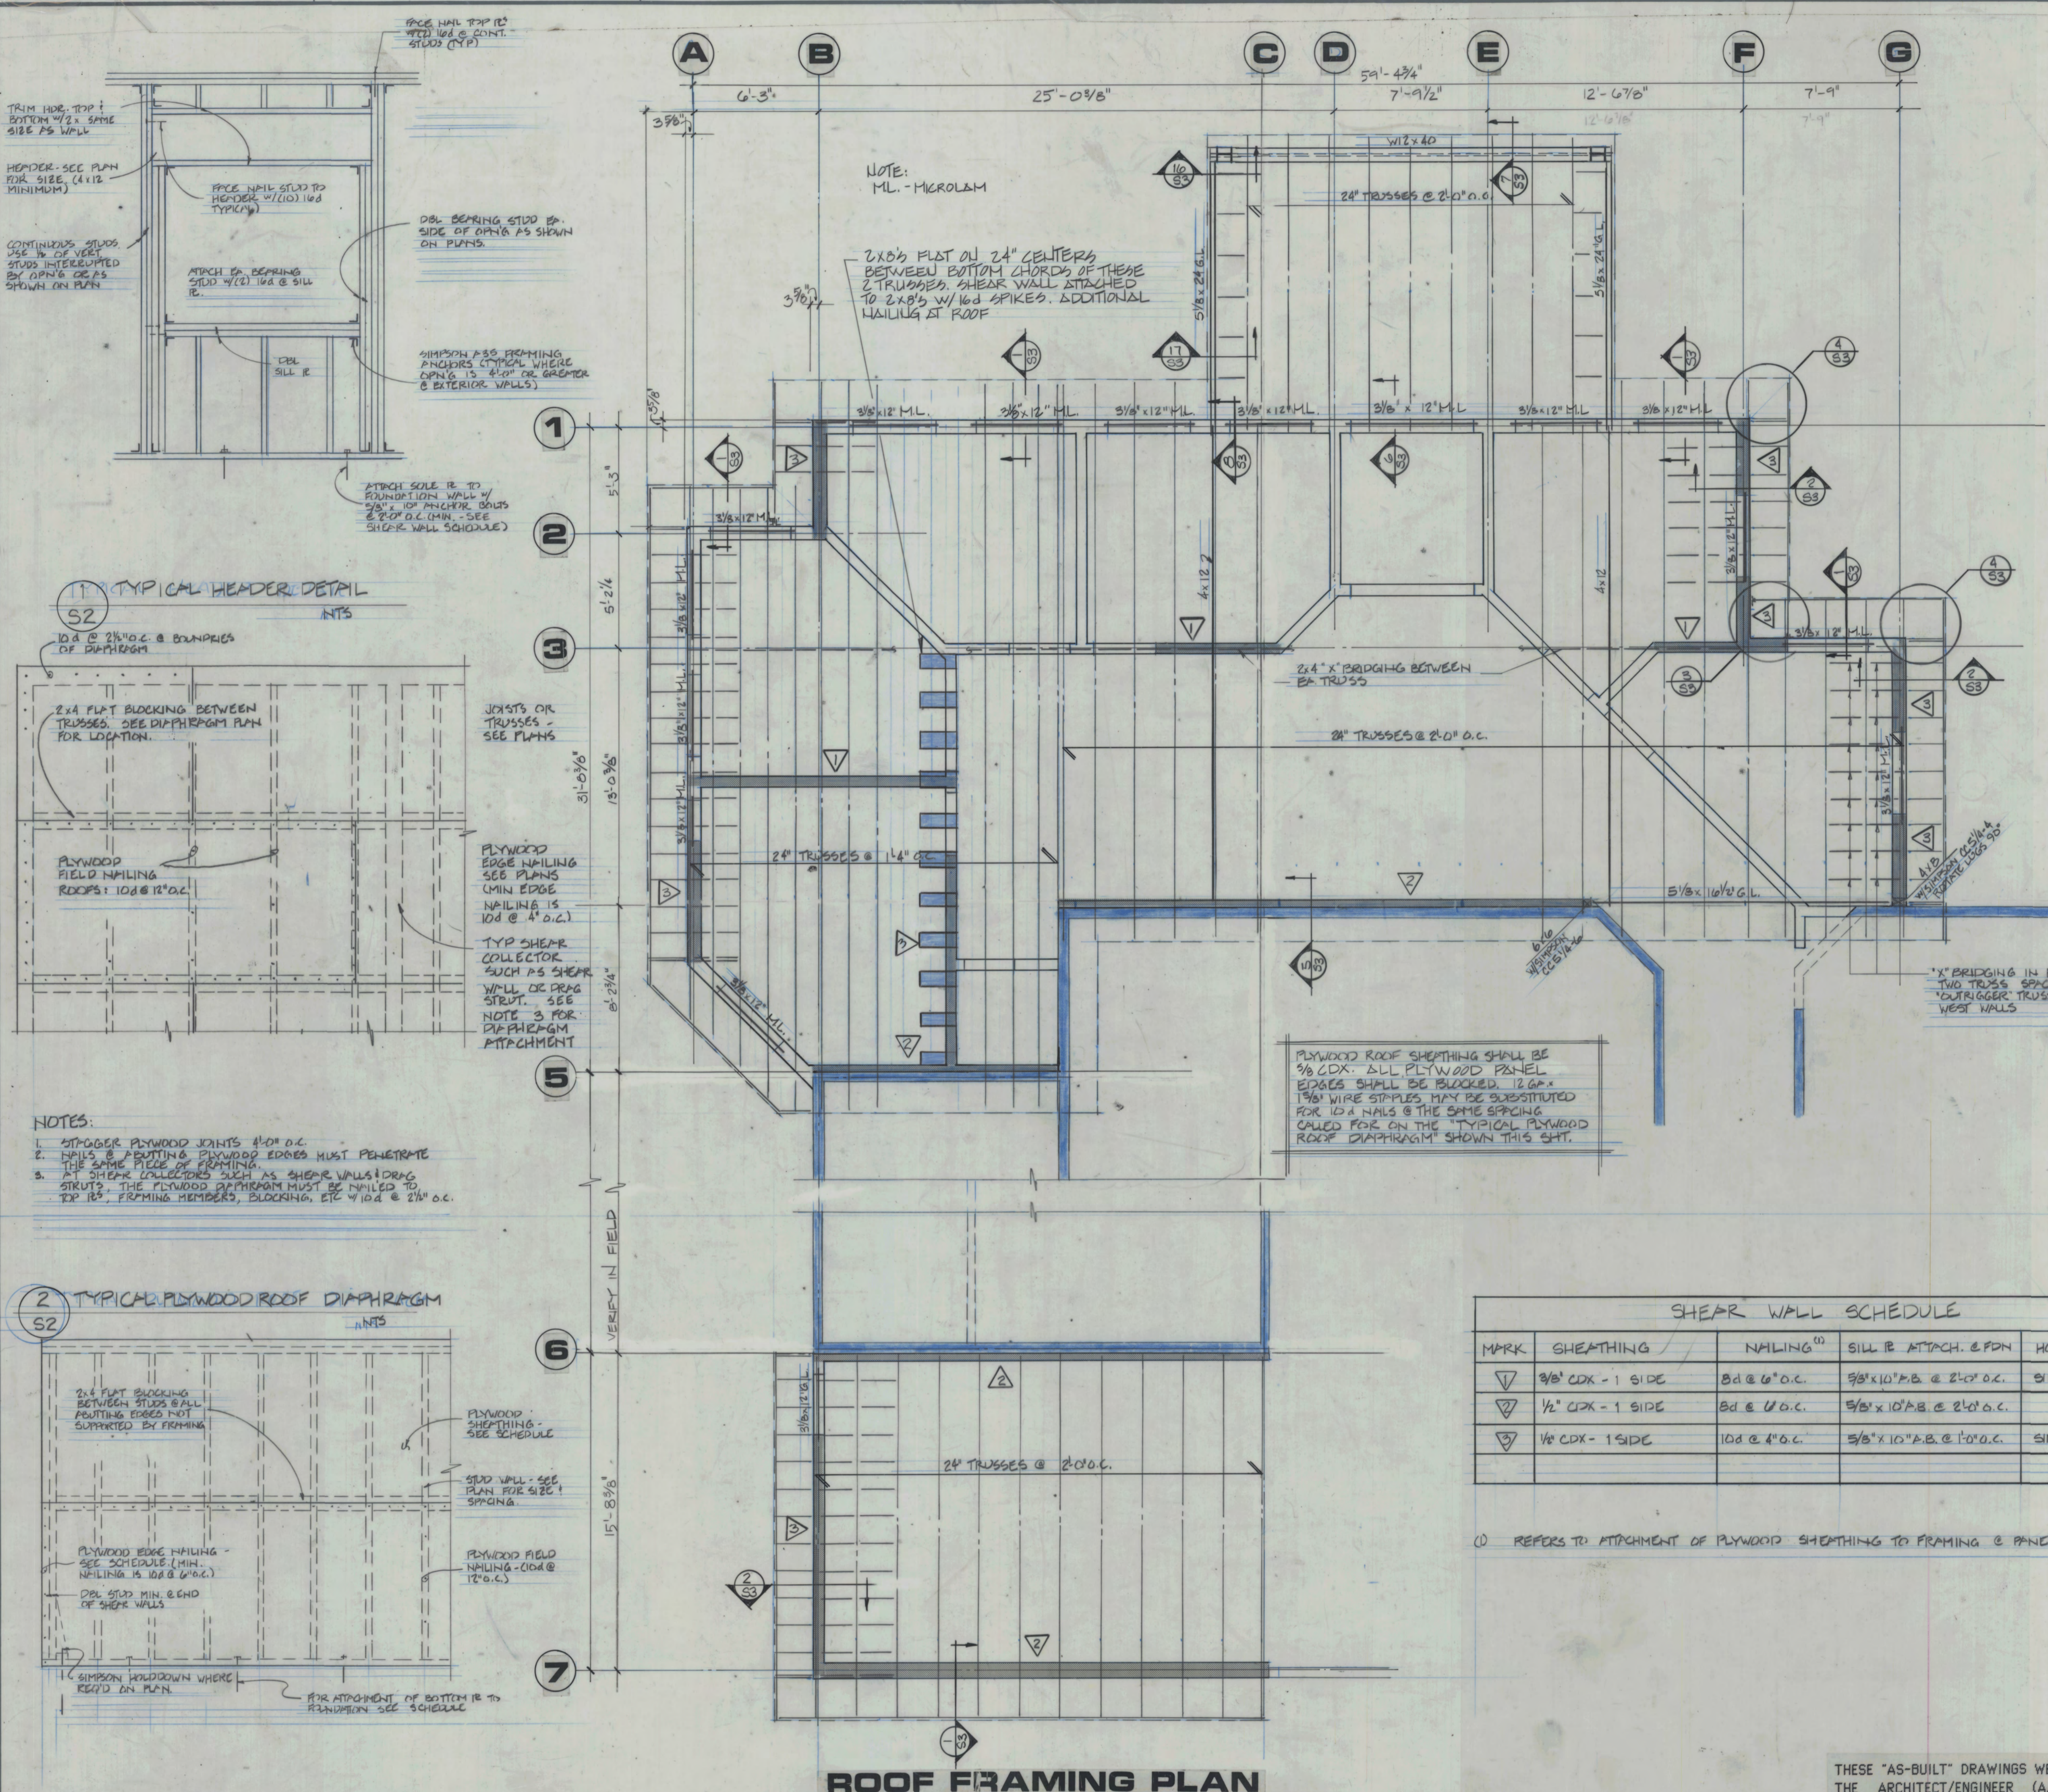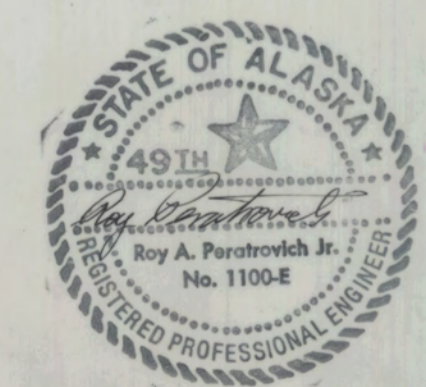

SHEAR WALL SCHEDULE

MARK	SHEATHING	NAILING ⁽¹⁾	SILL IR ATTACH. & FDN	HOLDDOWN
▽	5/8" CDX - 1 SIDE	8d @ 6" O.C.	5/8" x 10" P.B. @ 24" O.C.	SIMPSON HD-2
▽	1/2" CDX - 1 SIDE	8d @ 4" O.C.	5/8" x 10" P.B. @ 24" O.C.	
▽	1/2" CDX - 1 SIDE	10d @ 4" O.C.	5/8" x 10" P.B. @ 12" O.C.	SIMPSON HD-7

(1) REFERS TO ATTACHMENT OF PLYWOOD SHEATHING TO FRAMING & PANEL POINTS.

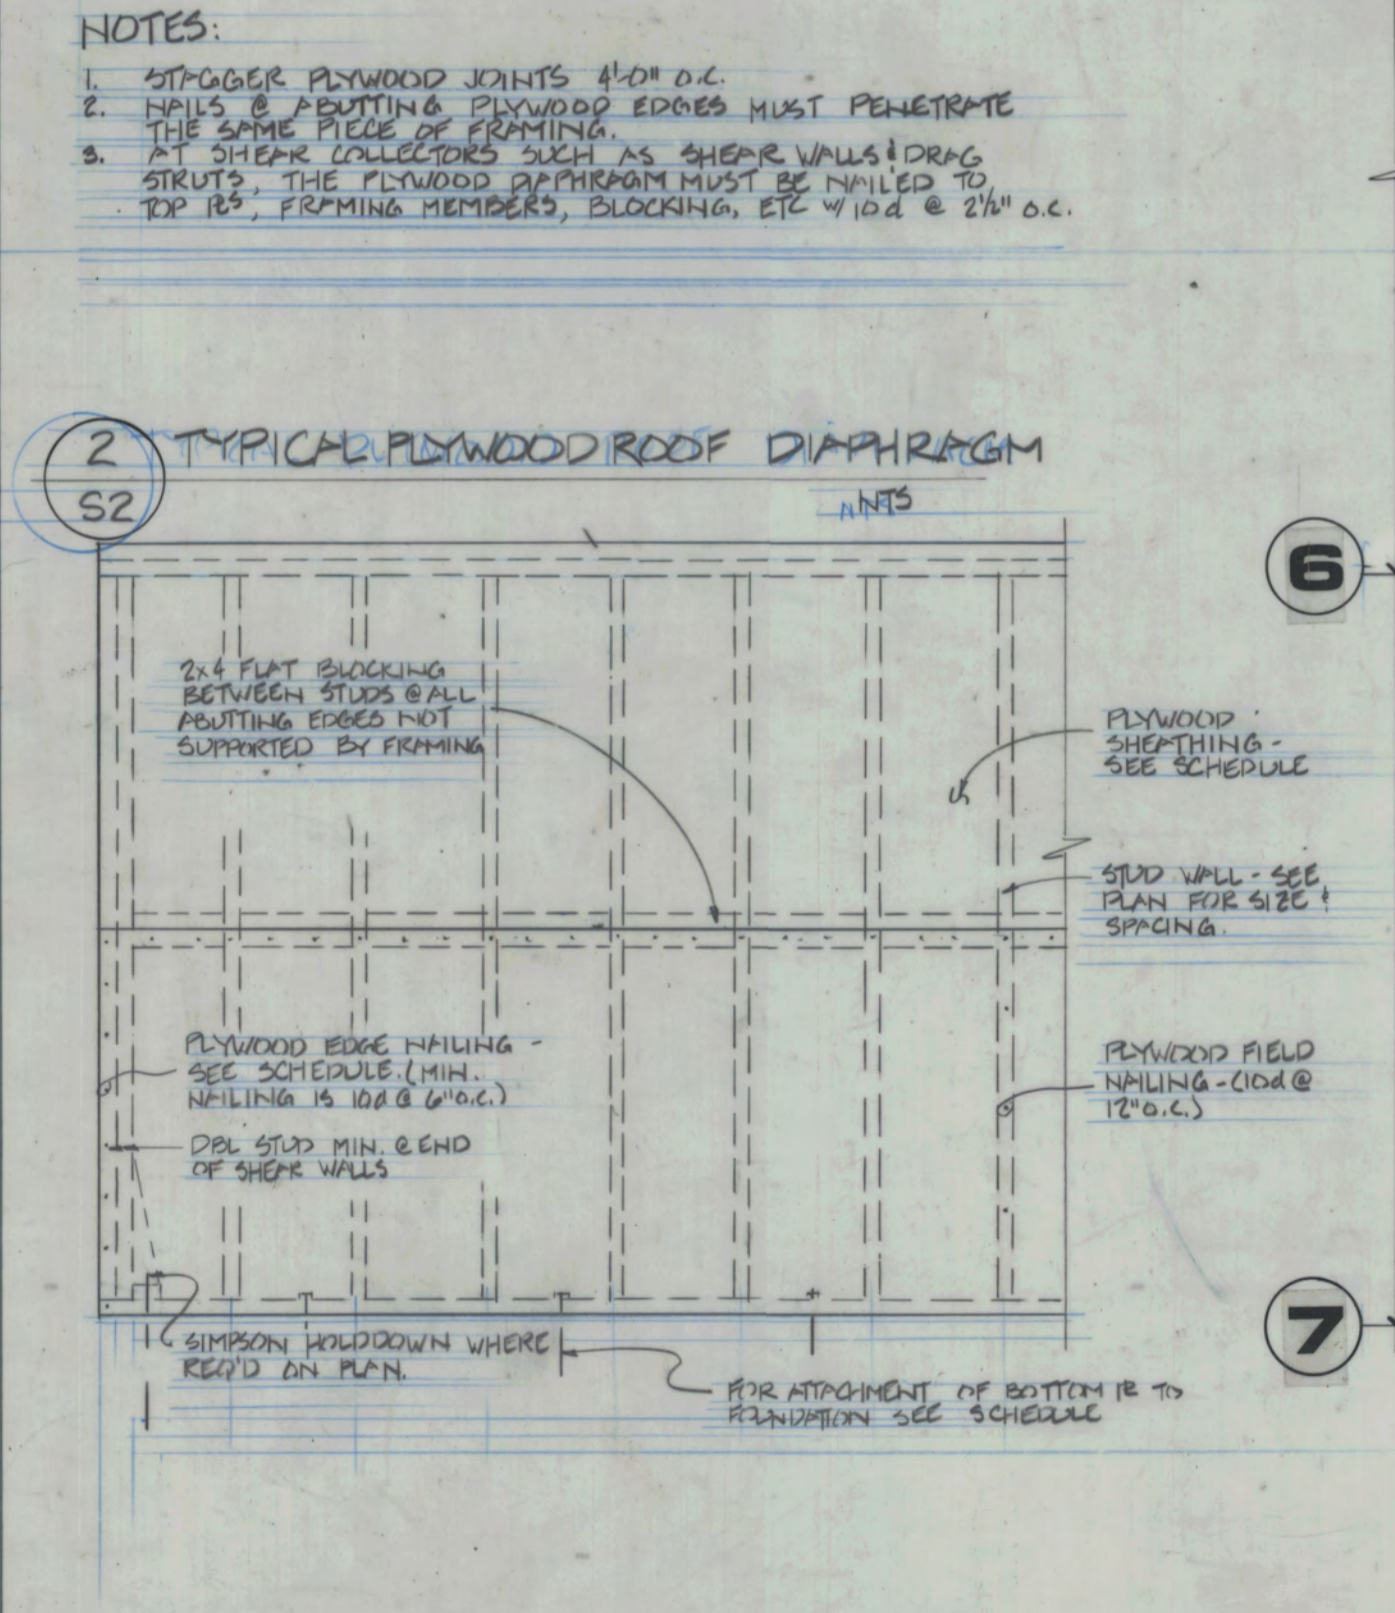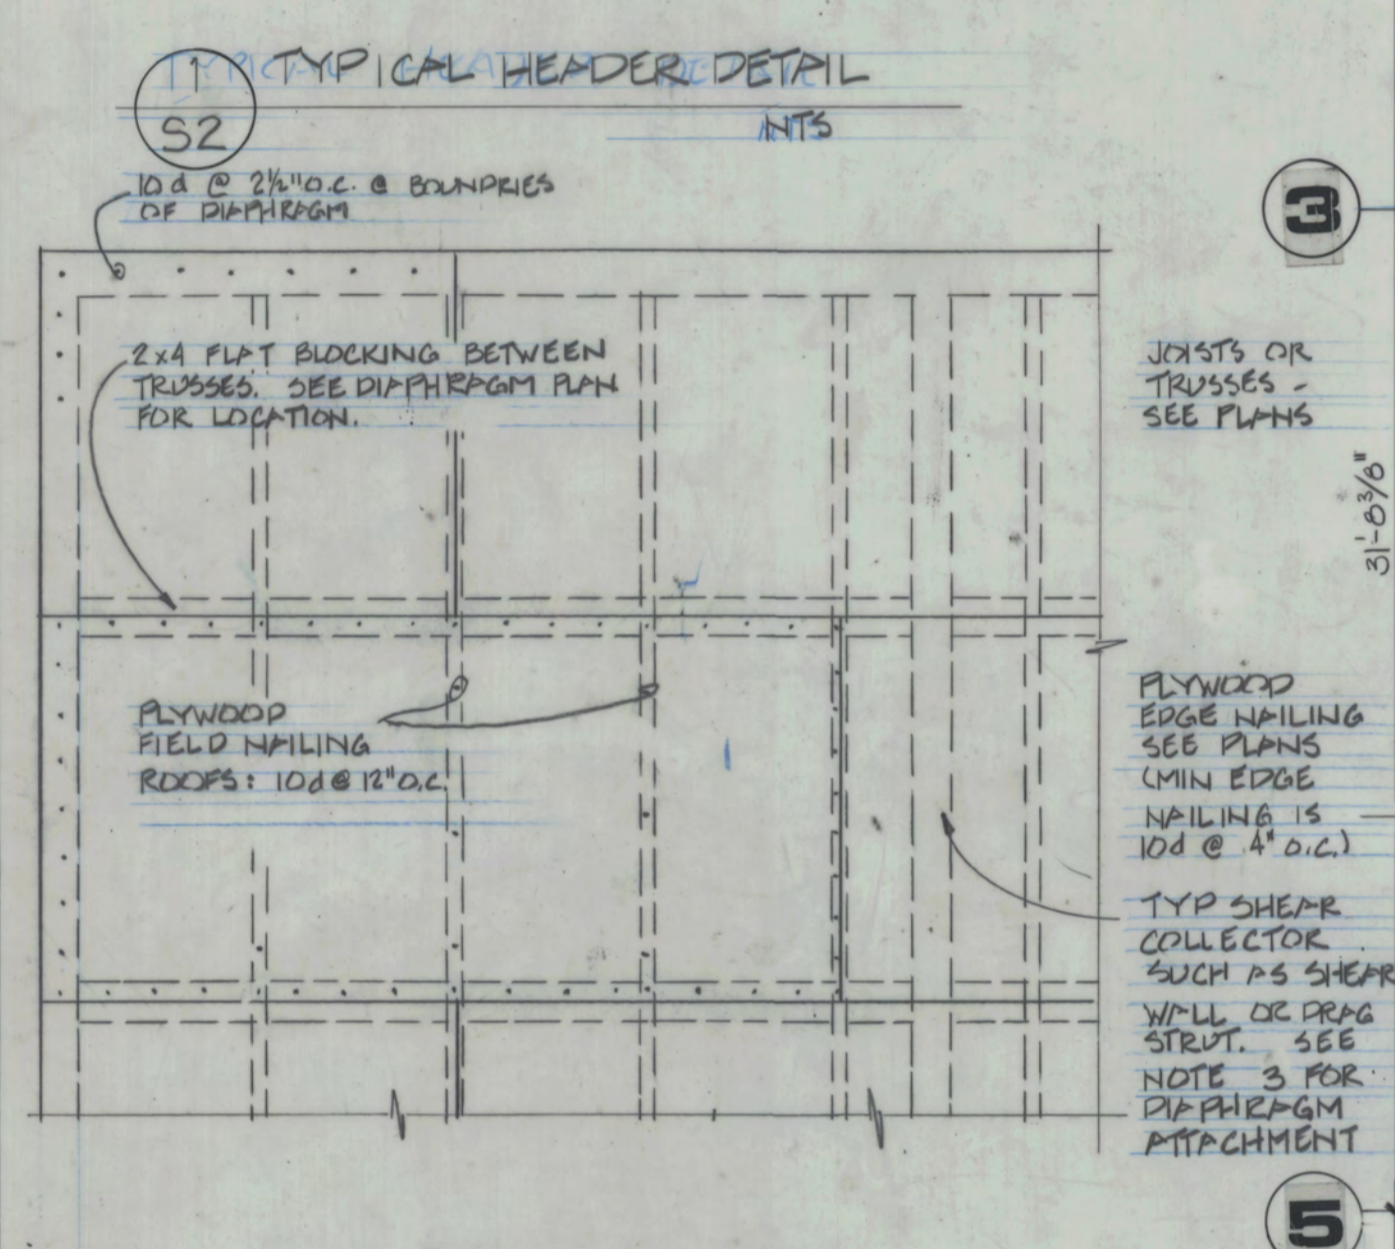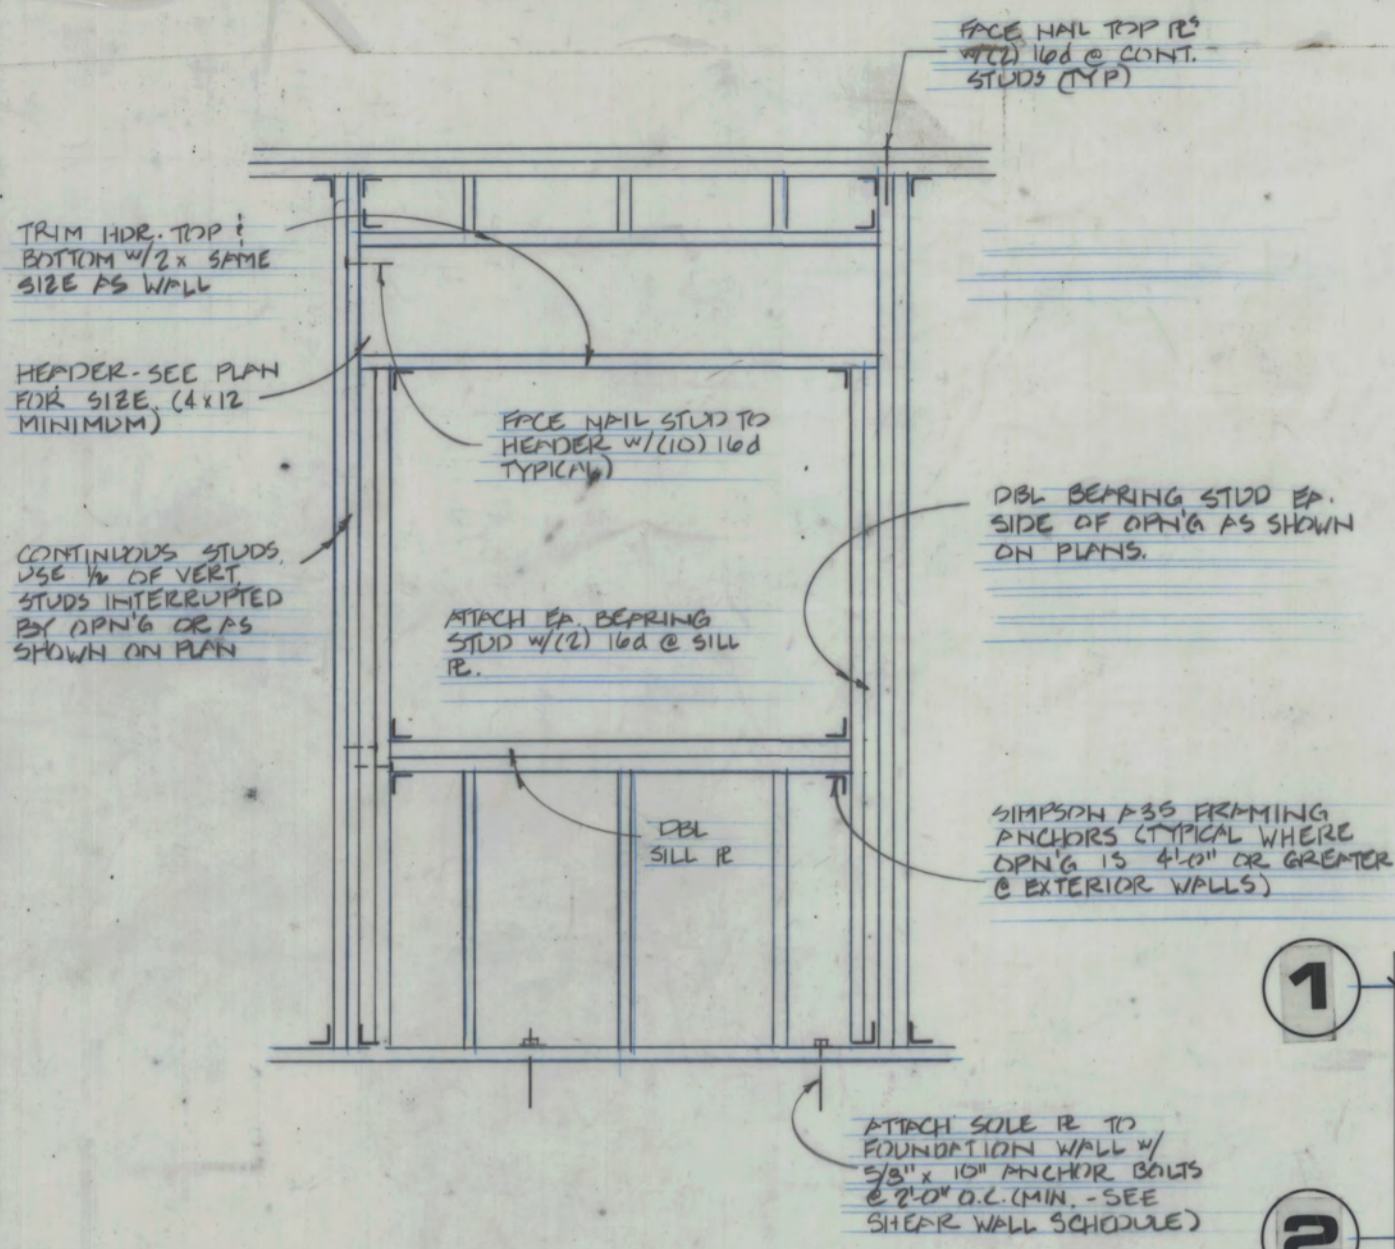

ENG7948.TIF

THESE "AS-BUILT" DRAWINGS WERE COMPILED BY THE ARCHITECT/ENGINEER (A/E) BASED ON INFORMATION SUPPLIED BY THE CONTRACTOR. NO WARRANTY IS MADE OR IMPLIED BY THE A/E AS TO ACCURACY OR COMPLETENESS.

F8.0.032 36029