



C. LEMARCHAND KENNEDY AND ASSOCIATES:  
**enviro**ndesign  
 ARCHITECTURE, PLANNING, ENERGY MANAGEMENT  
 1327 KALAKAKET, FAIRBANKS, ALASKA 99701 (907) 479-3193

REVISIONS:

PROJECT NO.  
 B-02  
 DATE: 6-30-86  
 DRAWN: JMB  
 CHECKED:

CONTENTS:  
 RM 101, 102  
 103, 104  
 INTERIOR  
 ELEVATIONS  
 SCALE: 1/4" = 1'-0"






DRAWING NO.

A7

THESE "AS-BUILT" DRAWINGS WERE COMPILED BY THE ARCHITECT/ENGINEER (A/E) BASED ON INFORMATION SUPPLIED BY THE CONTRACTOR. NO WARRANTY IS MADE OR IMPLIED BY THE A/E AS TO ACCURACY OR COMPLETENESS.

F8-0.049

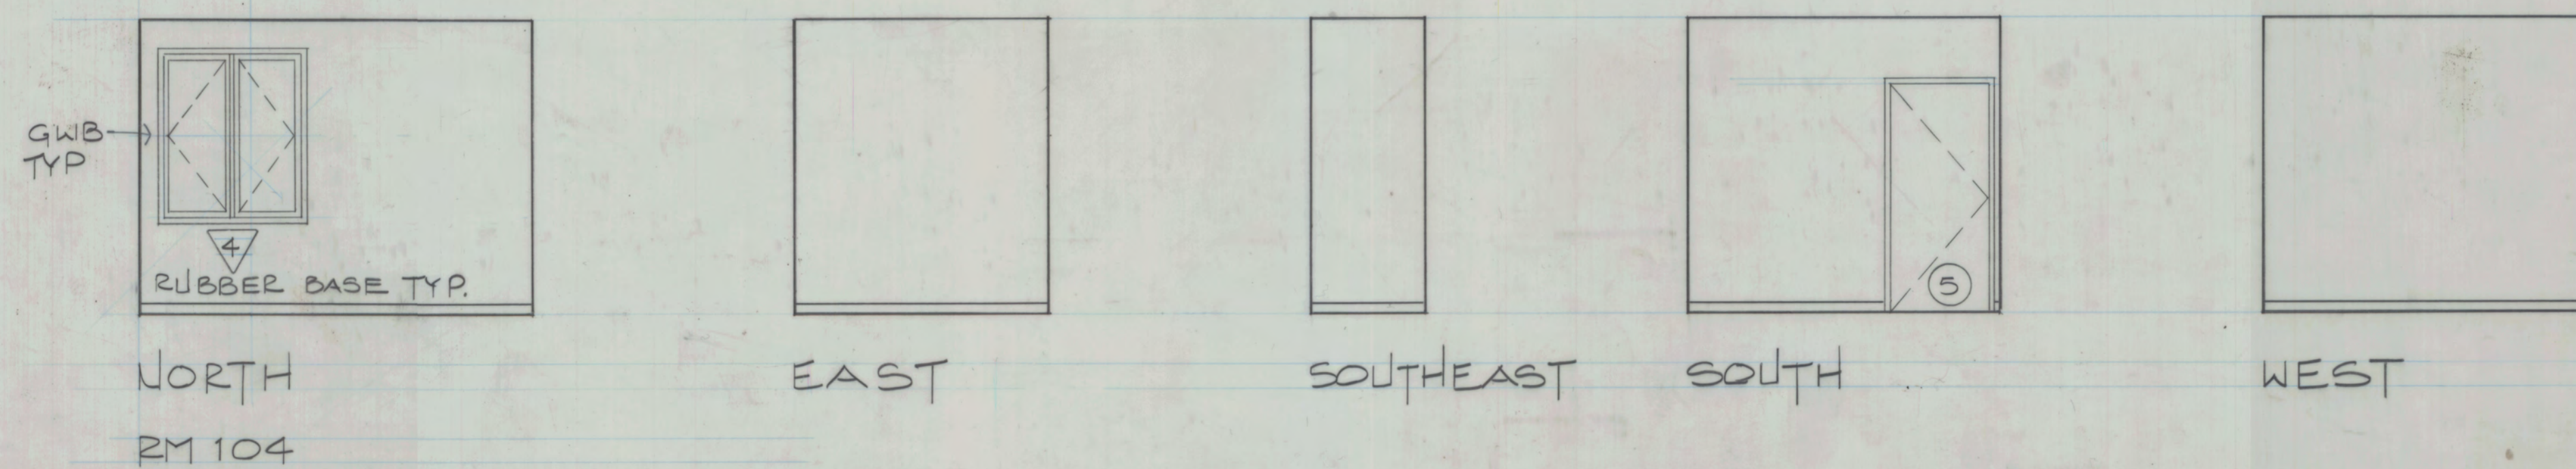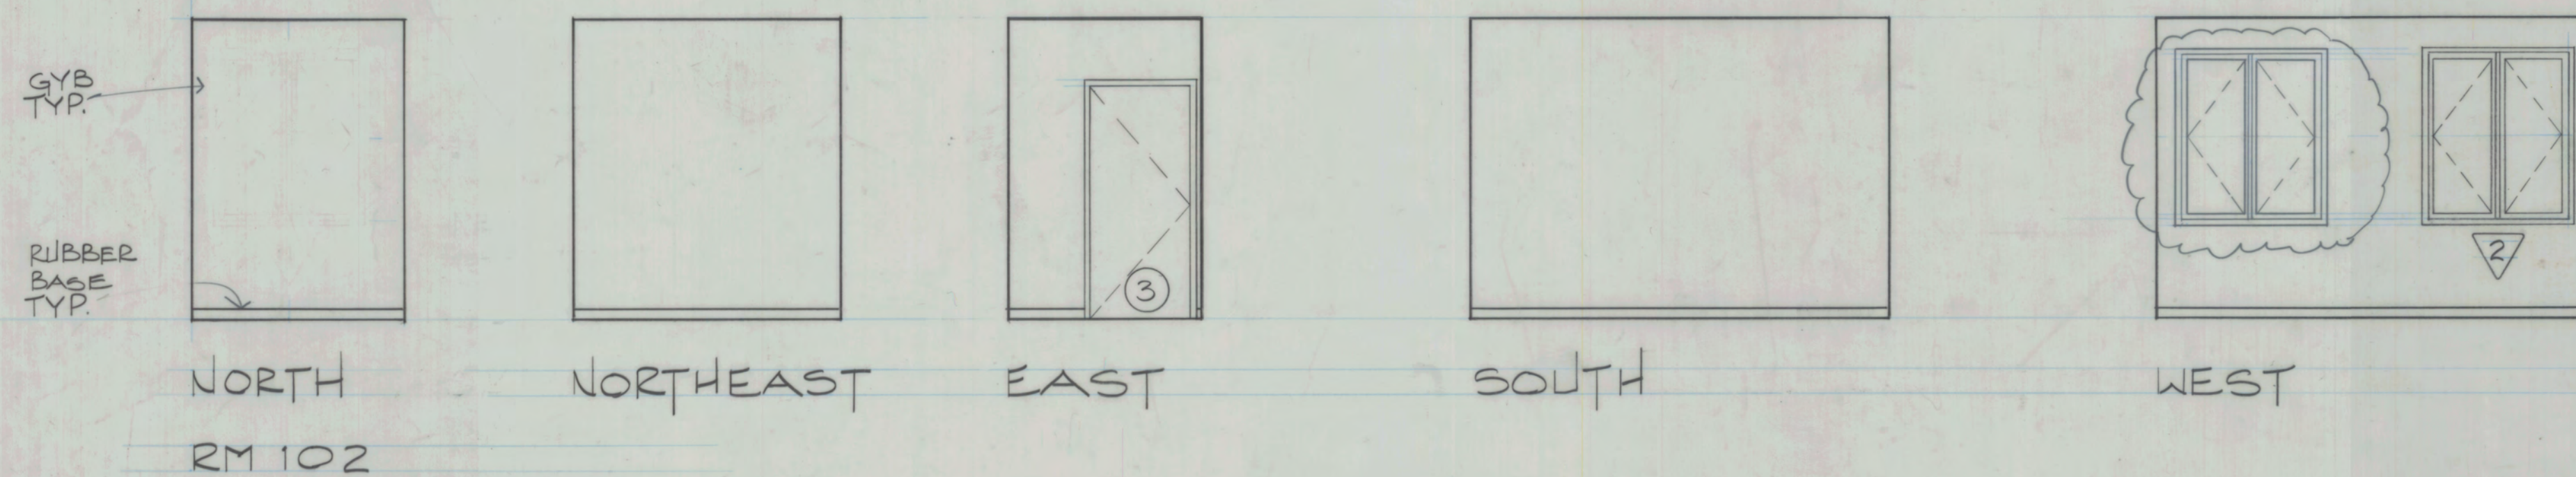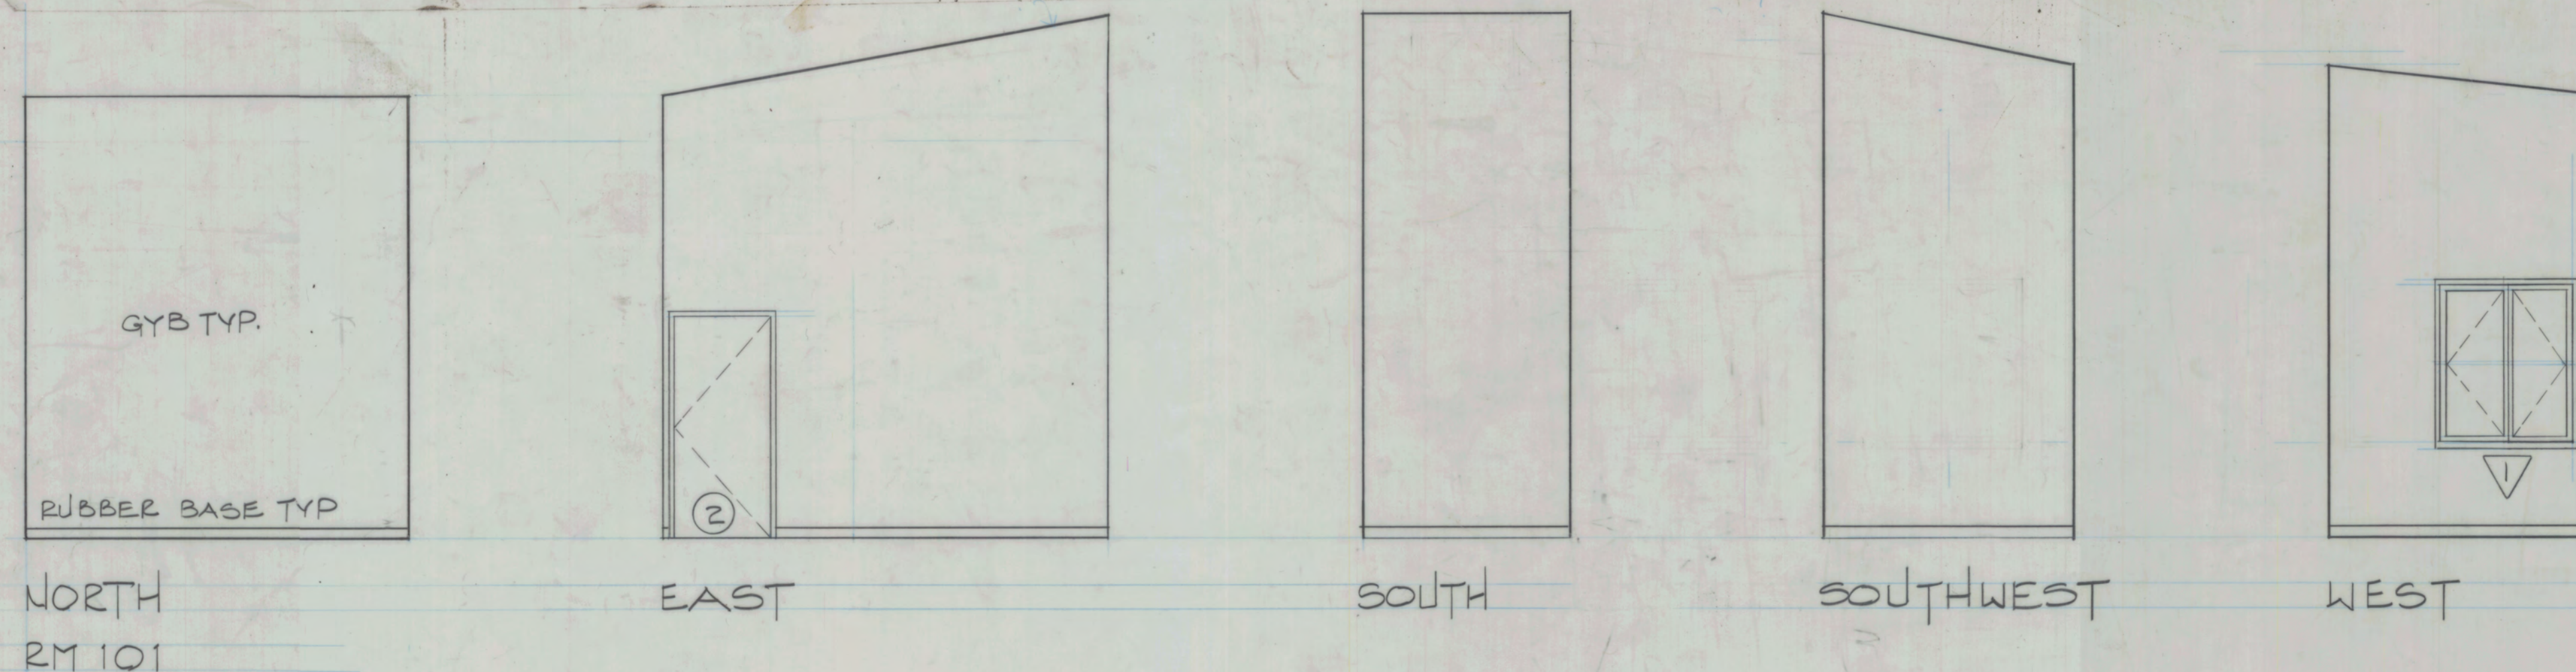

ENG7952.TIF