



C. LEMARCHAND KENNEDY AND ASSOCIATES:  
**enviro**ndesign  
 ARCHITECTURE, PLANNING, ENERGY MANAGEMENT  
 1327 KALAKAKET, FAIRBANKS, ALASKA 99701 (907) 479-3193


REVISIONS:

PROJECT NO. 8602

DATE: 6-30-86  
 DRAWN: JH, JMB  
 CHECKED:


CONTENTS:  
 DINING, KITCHEN  
 PLAN

SCALE: 1/4" = 1'-0"

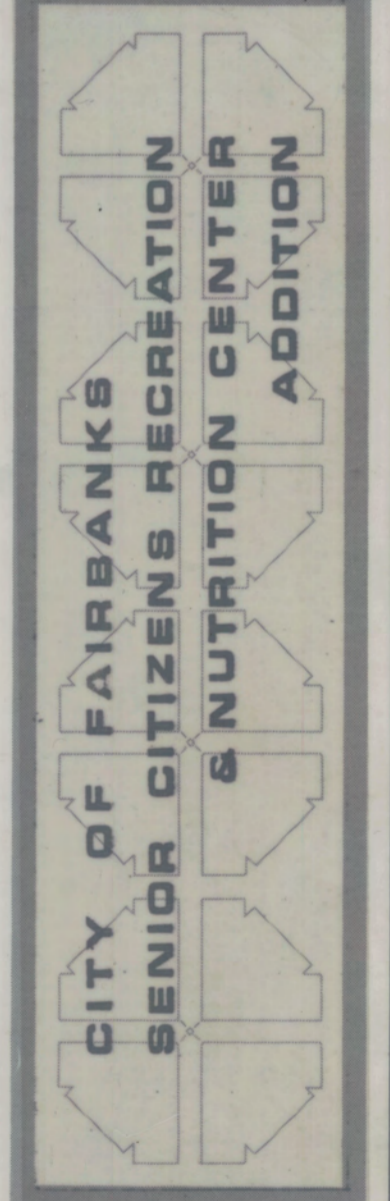

DRAWING NO.

A3

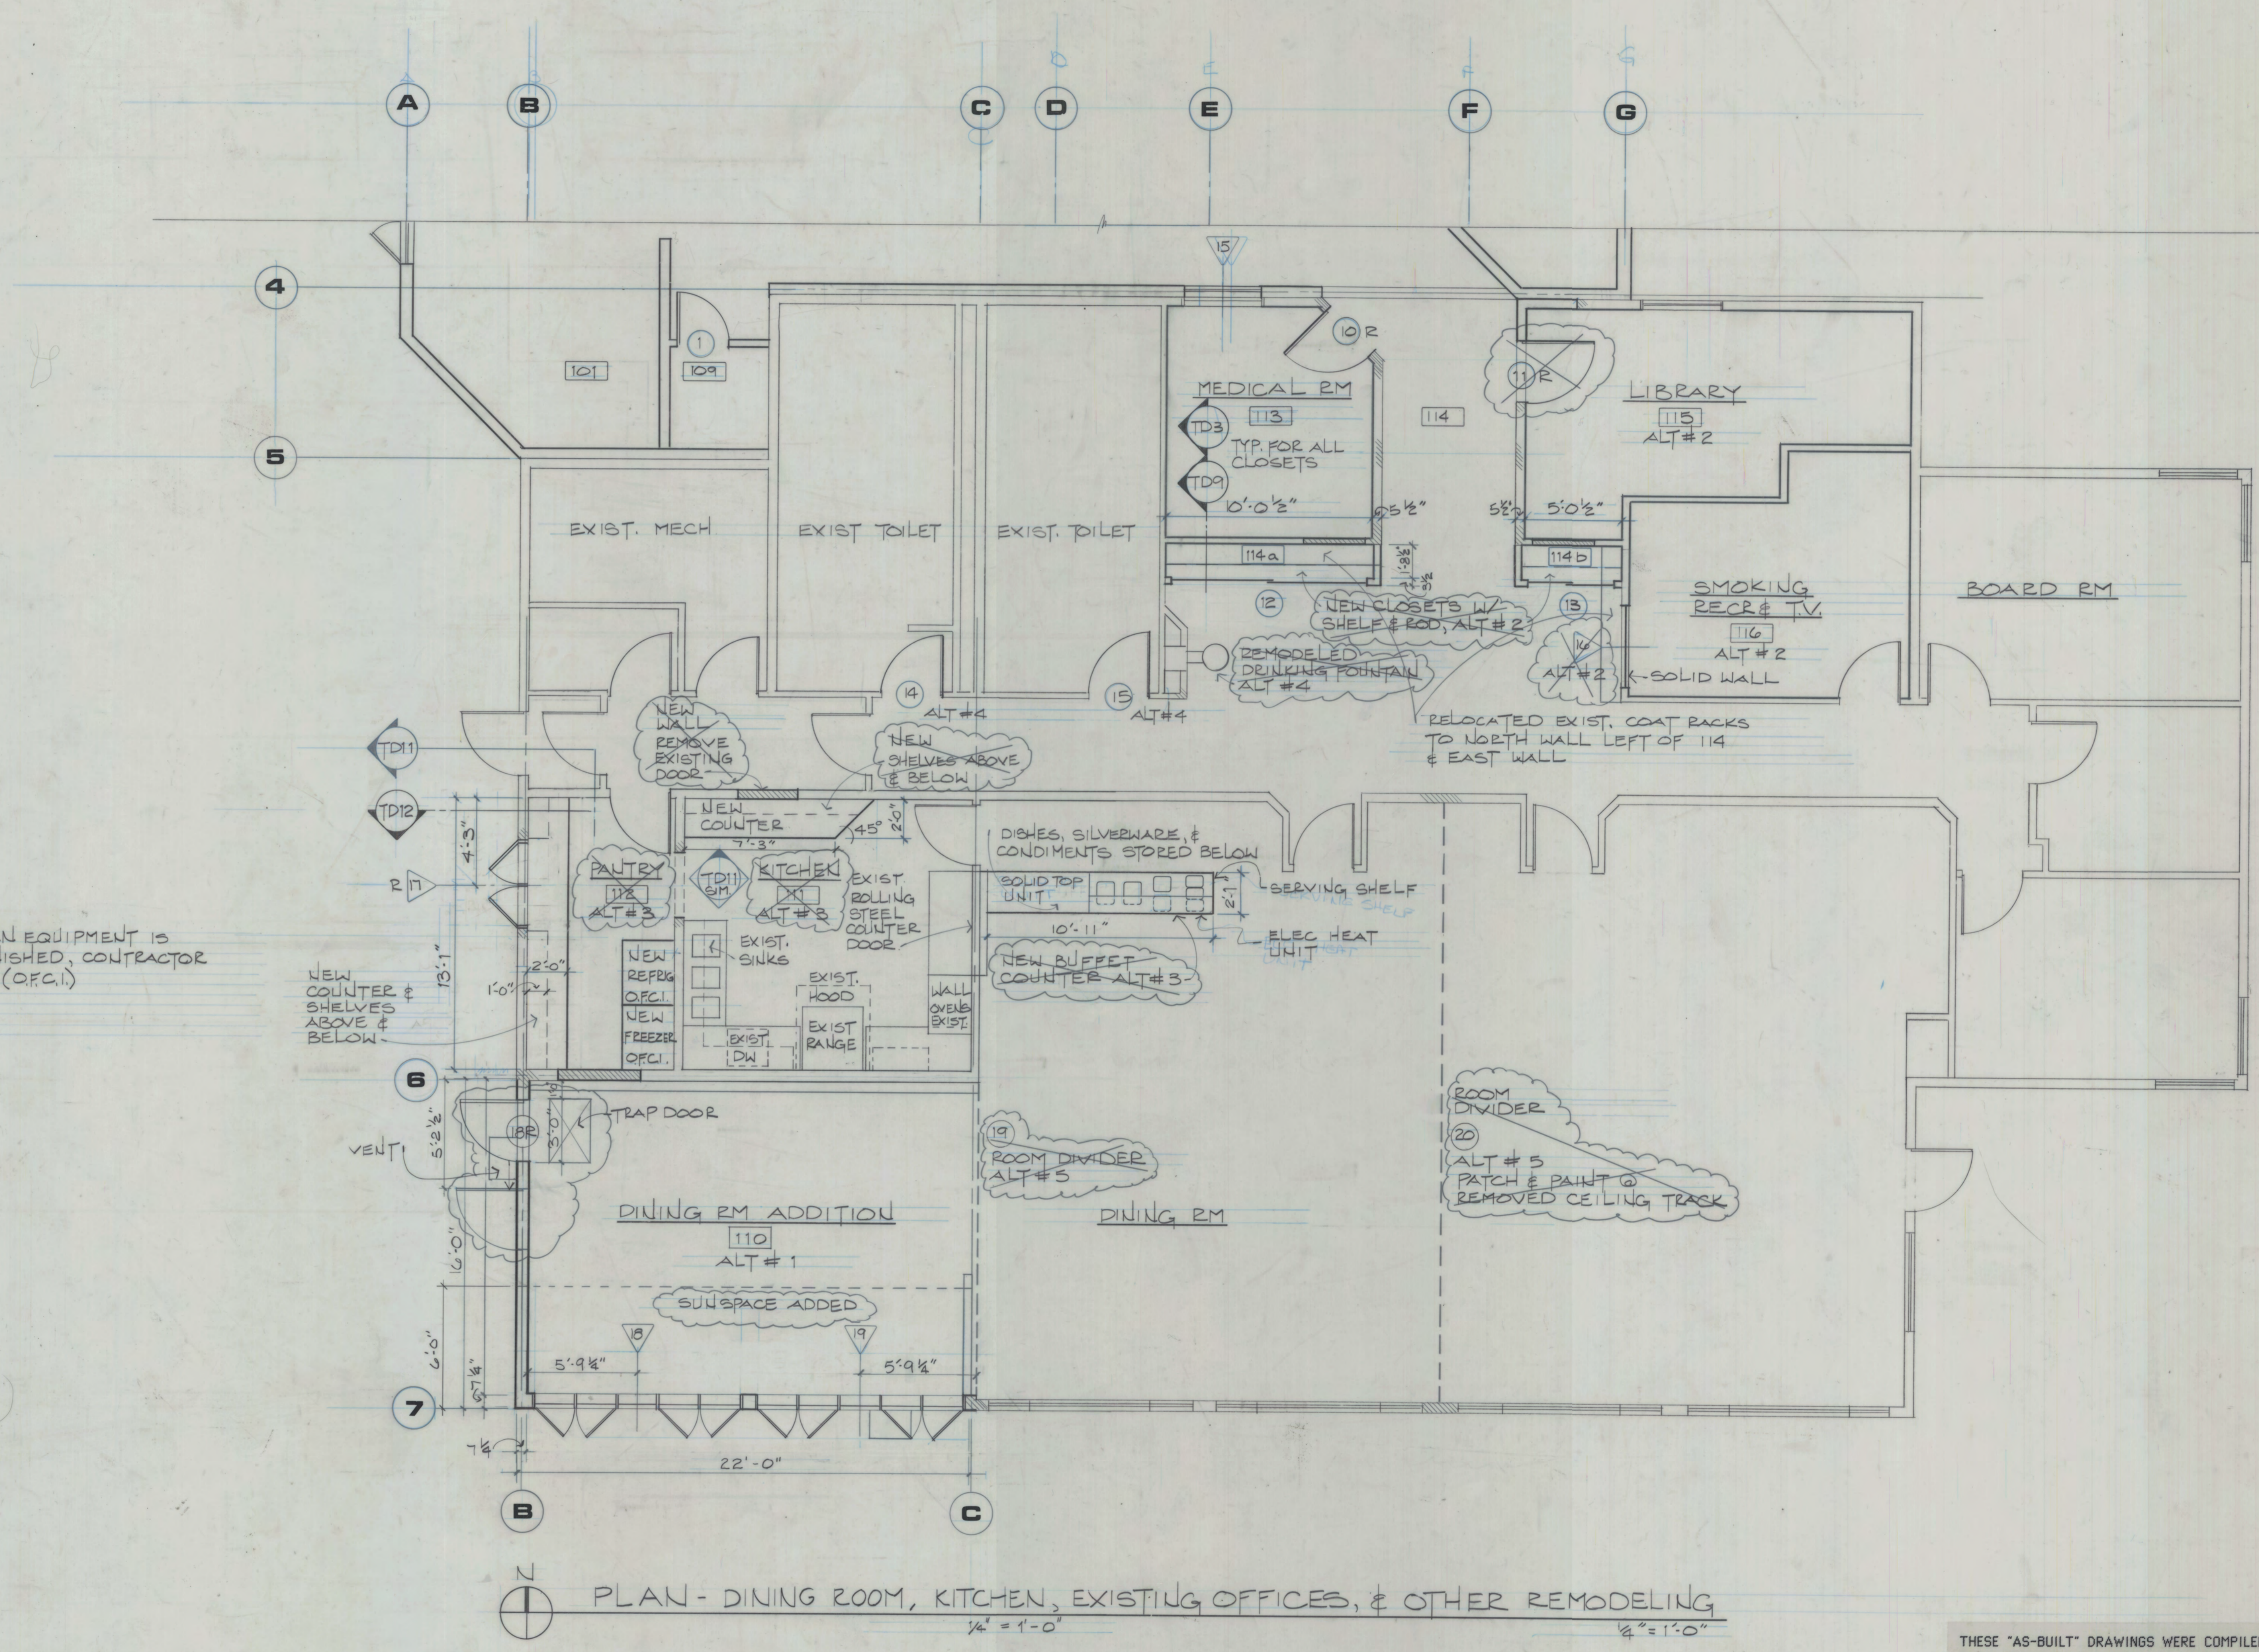

NOTE:  
 NEW KITCHEN EQUIPMENT IS  
 OWNER FURNISHED, CONTRACTOR  
 INSTALLED. (O.F.C.I.)

PLAN - DINING ROOM, KITCHEN, EXISTING OFFICES, & OTHER REMODELING  
 1/4" = 1'-0"      1/2" = 1'-0"

ENG7956.TIF

THESE "AS-BUILT" DRAWINGS WERE COMPILED BY THE ARCHITECT/ENGINEER (A/E) BASED ON INFORMATION SUPPLIED BY THE CONTRACTOR. NO WARRANTY IS MADE OR IMPLIED BY THE A/E AS TO ACCURACY OR COMPLETENESS.

F8.0.044