



C. LEMARCHAND KENNEDY AND ASSOCIATES:
environdesign
 ARCHITECTURE, PLANNING, ENERGY MANAGEMENT
 1327 KALAKAKET, FAIRBANKS, ALASKA 99701 (907) 479-3193

REVISIONS:

PROJECT NO.
 8602
 DATE: 6.30.86
 DRAWN: JMB, WH
 CHECKED:

CONTENTS:
 FLOOR PLAN


SCALE: INDICATED



DRAWING NO.


A2

THESE "AS-BUILT" DRAWINGS WERE COMPILED BY THE ARCHITECT/ENGINEER (A/E) BASED ON INFORMATION SUPPLIED BY THE CONTRACTOR. NO WARRANTY IS MADE OR IMPLIED BY THE A/E AS TO ACCURACY OR COMPLETENESS.

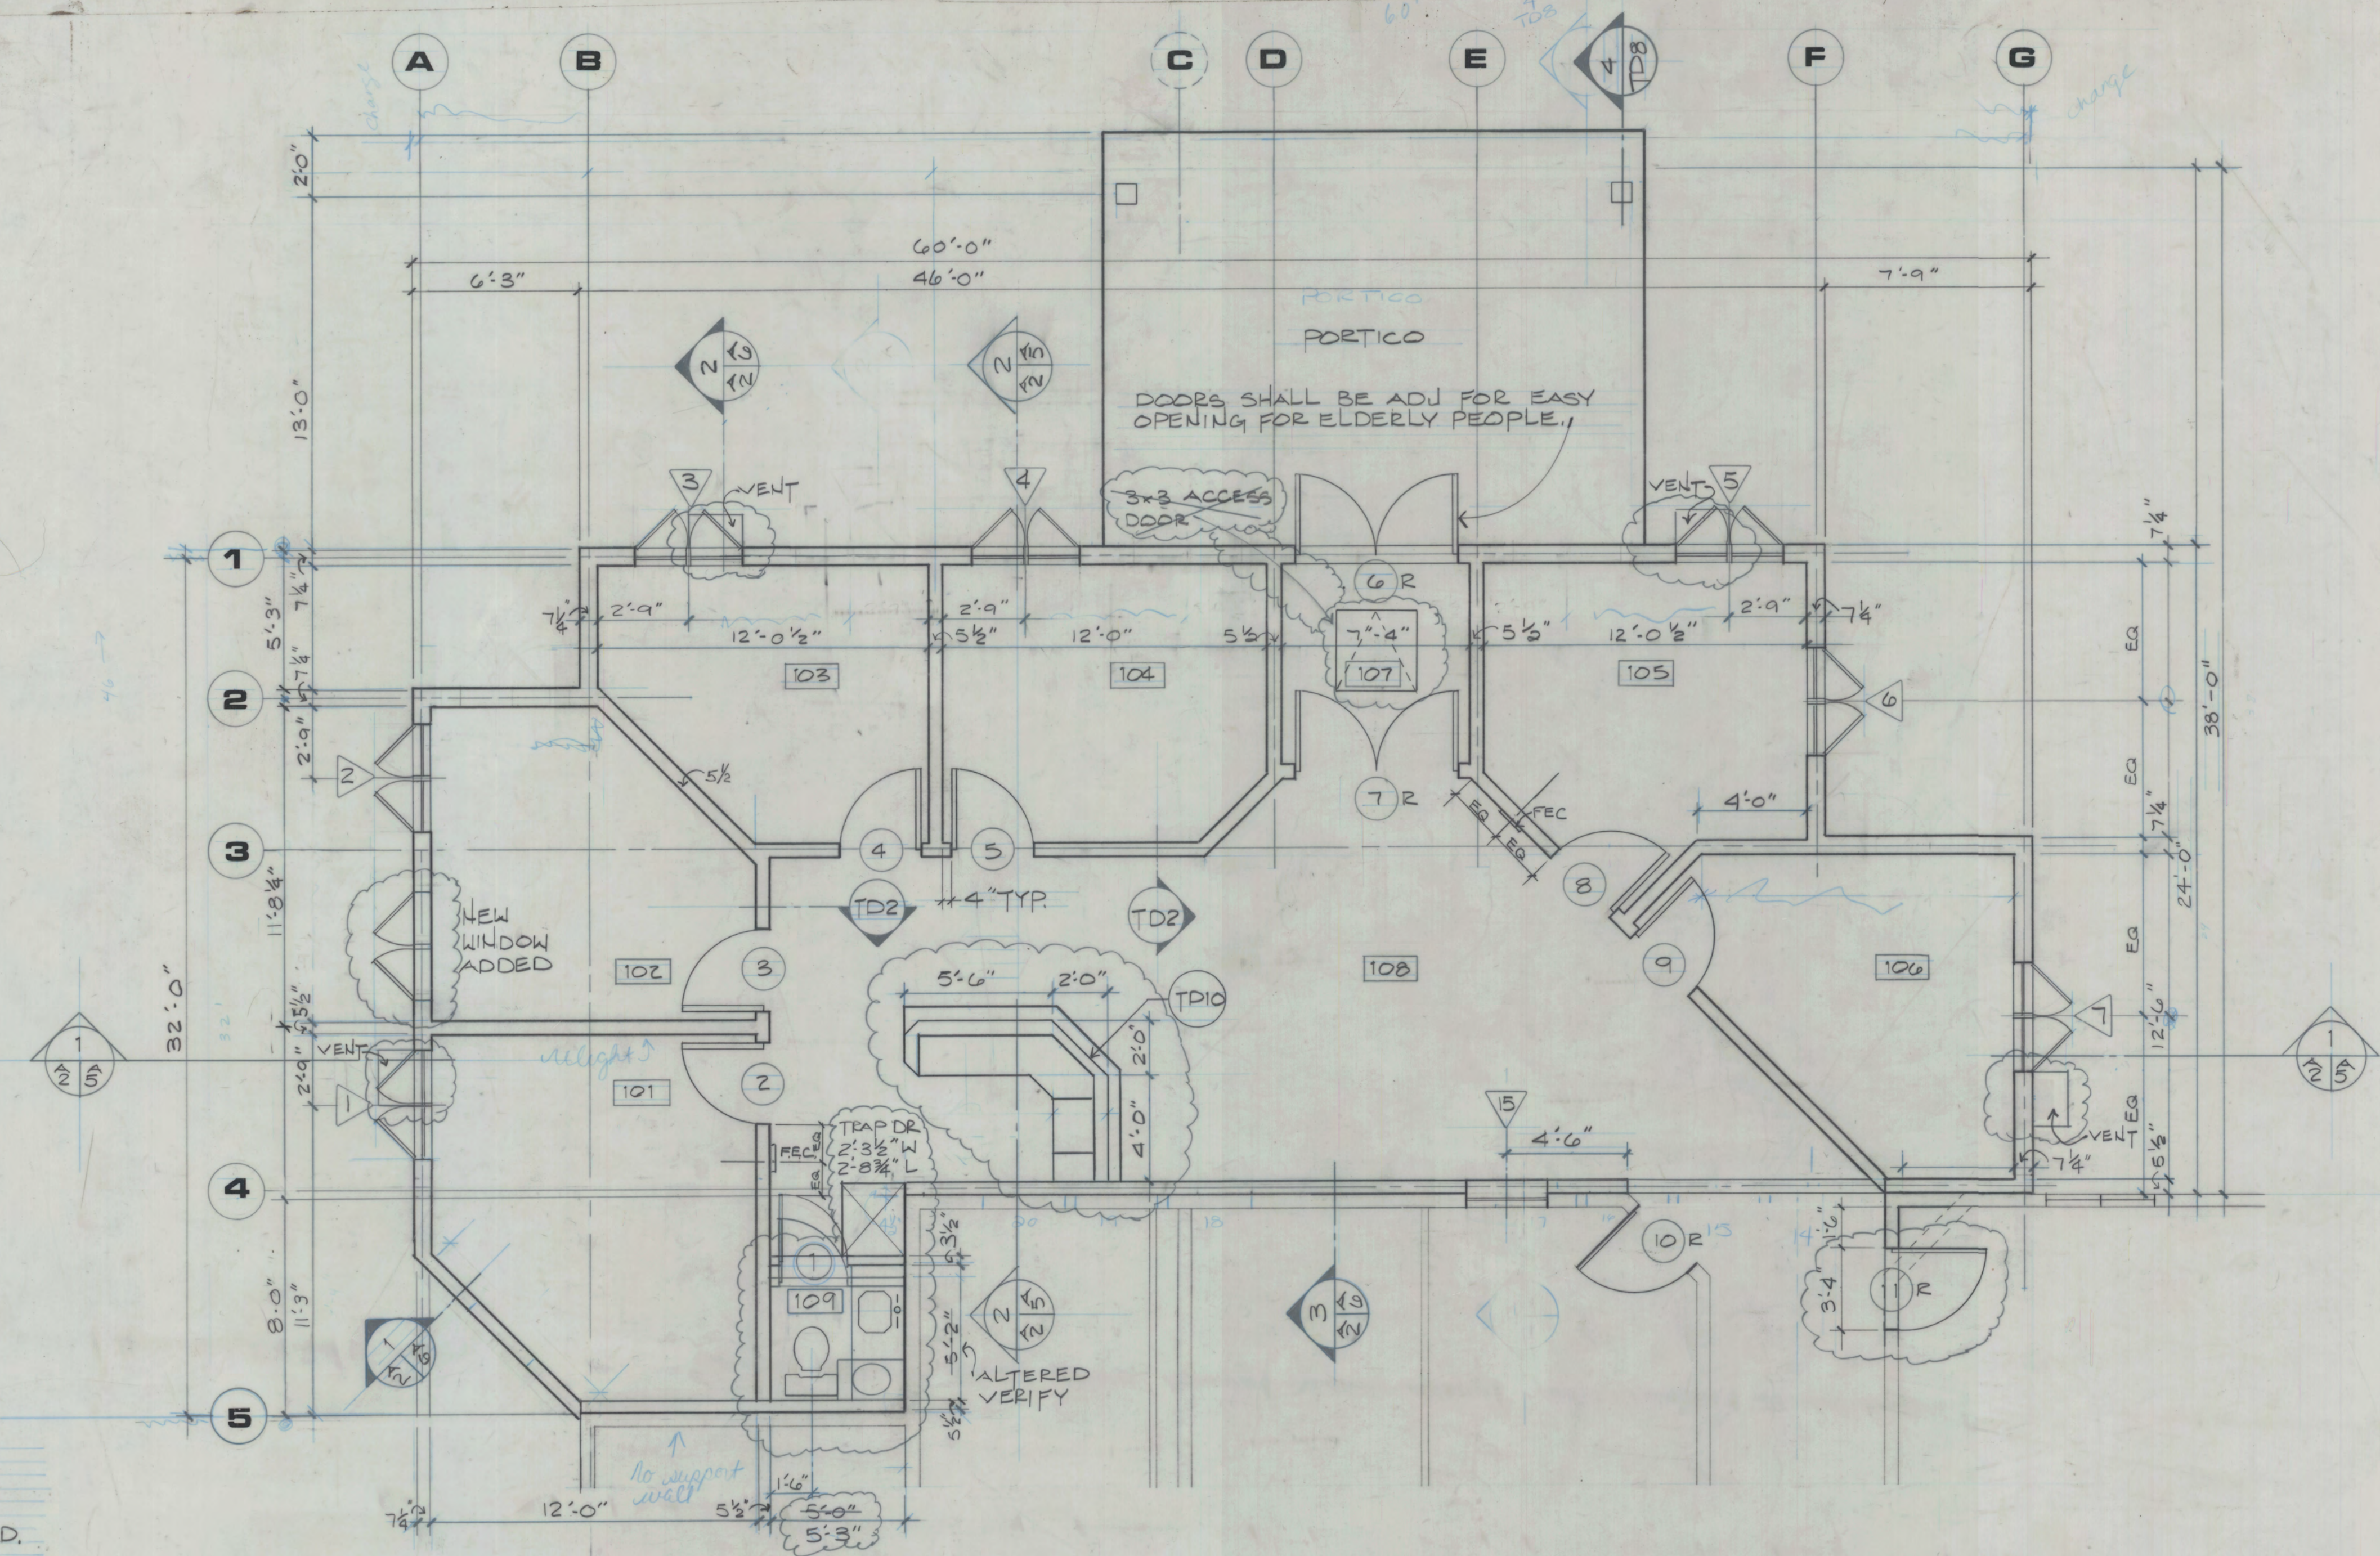

NOTE: GRID LINES ARE FOR REFERENCE ONLY. DIMENSIONS ARE TAKEN FROM FOS TO FOS, UNLESS OTHERWISE SPECIFIED.

PLAN - ADDITION
 1/4" = 1'-0"

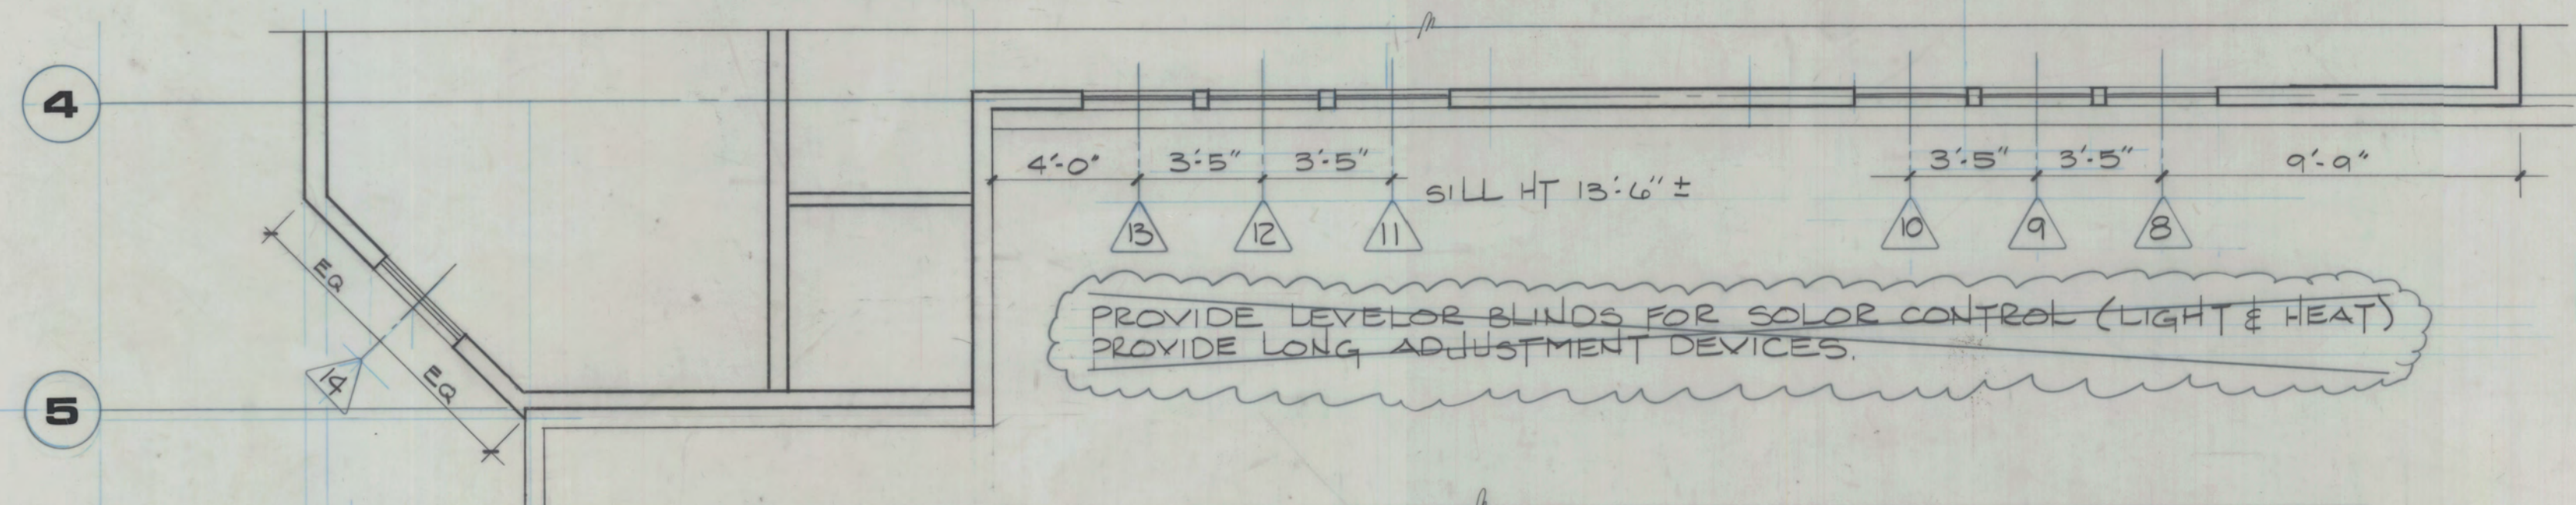

PLAN - ADDITION @ CLERESTORY
 1/4" = 1'-0"

ENG7957.TIF

F8.0-045 7.