

NOTE: TYPICAL 0.5 TO 1.5 ORGANIC MAT OVERLAPPING NON-CLEARED AREAS
ALL ELEV'S MEASURED TO MINERAL SOIL
WOODED

NOTE: ALL ELEV'S 430+ UNLESS NOTED
50' SDD UNLESS NOTED

RAVED PARKING AREA

PROBABLE BURIED ELECTRICAL SERVICE

NOTE: CONCRETE SURFACE DRAINS EXTEND 3' WEST OF PROP LINE
MEASUREMENTS TO EXTERIOR FINISH


NOTE: WATER + SEWER LOCATION DATA FURNISHED BY CITY OF FAIRBANKS MUNICIPAL UTILITIES SYSTEM AND IS NOT GUARANTEED OR CERTIFIED AS SHOWN. CONTRACTOR SHOULD PROCEED WITH CAUTION. CONTRACTOR ALSO BEWARE BURIED FUEL OIL TANK & BURIED ELECTRICAL SERVICE.



SEALS 80-21
COR 1
1981
3292 S

TYPICAL 2 1/2" AWM CAP RECOVERED THIS SURVEY

LAURENCE H. IRVING
Registered Land Surveyor
U.S. Mineral Surveyor
1205 Smythe Street
Fairbanks, AK 99701
Phone: 907-456-4298

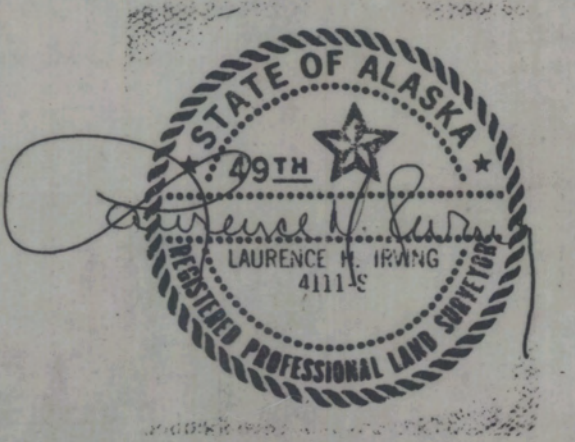

SITE SURVEY:		SENIOR CITIZENS RECREATION & NUTRITION CENTER	
SCALE: 1" = 20'	APPROVED BY:	DRAWN BY: DE	REVIEWED:
DATE: 8-7-86			
FOR: ENVIRON DESIGN ASSOC.			
LOCATED IN ALASKA STATE LAND SURVEY 80-21		DRAWING NUMBER: C2	
SEC 9 T15E1W E1M ALASKA			

THESE "AS-BUILT" DRAWINGS WERE COMPILED BY THE ARCHITECT/ENGINEER (A/E) BASED ON INFORMATION SUPPLIED BY THE CONTRACTOR. NO WARRANTY IS MADE OR IMPLIED BY THE A/E AS TO ACCURACY OR COMPLETENESS.

F8:0-046

ENG7958.TIF