KAE 19 1255 12-77 MC 7169+

JANET MATHESON ARCHITECT
P.O. BOX 81038
FAIRBANKS,
ALASKA 99708
(907) 452-4640

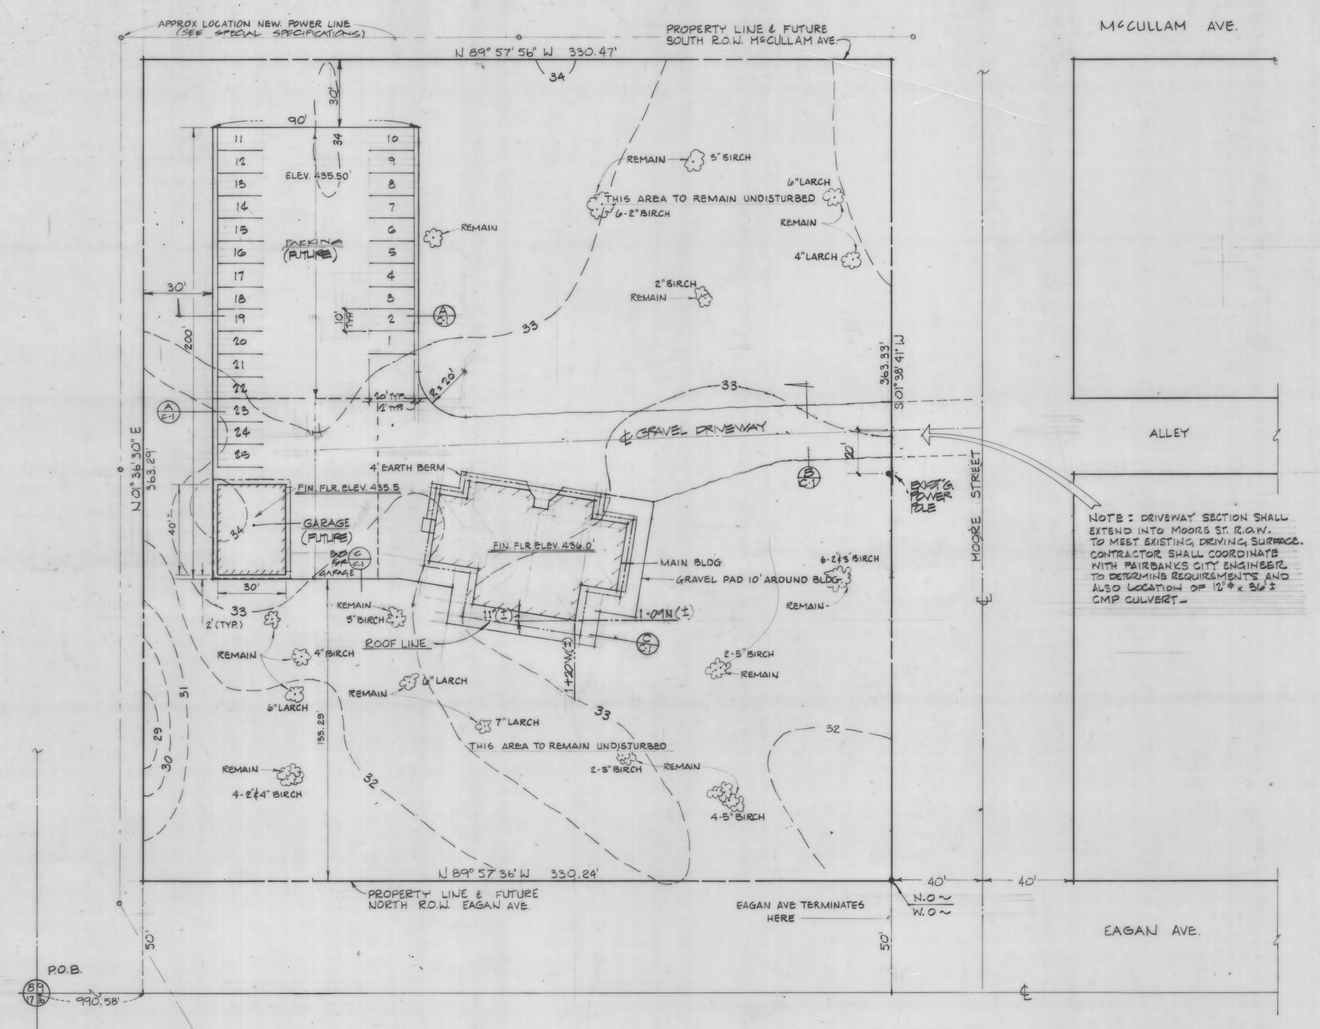

NORTH

SITE PLAN
1" = 30'

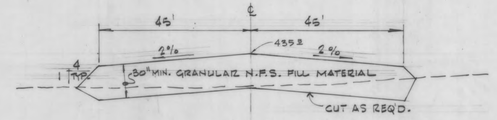

A / C-1

PARKING SECTION
HOR. 1" = 20'
VERT. 1" = 5'

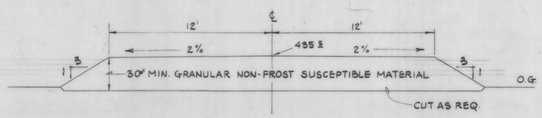

B / C-1

DRIVEWAY SECTION
1" = 5'

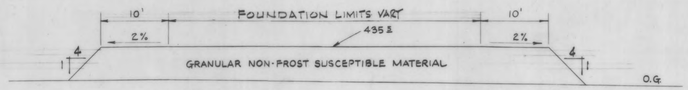

C / C-1

PAD SECTION
HOR 1"=10'
VER 1"=5'

REBID

"AS-BUILT"
NO CHANGE EXCEPT DRIVE-WAY ALIGNMENT.
2/2/82

STATE OF ALASKA
NOTH
John C. Conover
CE-3961
REGISTERED PROFESSIONAL ENGINEER

CITY OF FAIRBANKS
SENIOR CITIZENS RECREATION & NUTRITION CENTER

REV.	DATE	BY	REVISION
1	2-9-80	JSC	GENERAL REVISION FOR RE-BID

FIELD BOOKS — DESIGNED JSC/C.F.
DESIGN — DRAWN LKH/R.M.
STAKING — CHECKED J.S.C.
AS-BUILT — DATE 10-8-79
SCALE HOR. AS NOTED VER.
GRID
JOB NO. 79003F

ENGINEERS and LAND SURVEYORS bell, herring & assoc.

SITE PLAN

MICROFILMED DATE: 12/83
MICROFILM NUMBER:

SHEET C-1 OF 1
FILE NO. C6.0.162

ENG2185.TIF