

CITY OF FAIRBANKS
SENIOR CITIZENS RECREATION
& NUTRITION CENTER

CONSTRUCTION CHANGES + CORRES.
APPENDIX NO. 1

DOOR & FINISH SCHEDULES
RE BID


SHT #

A17

DWN JM CKD

DATE 2-22-83 PROJ # 791

C6.0.163

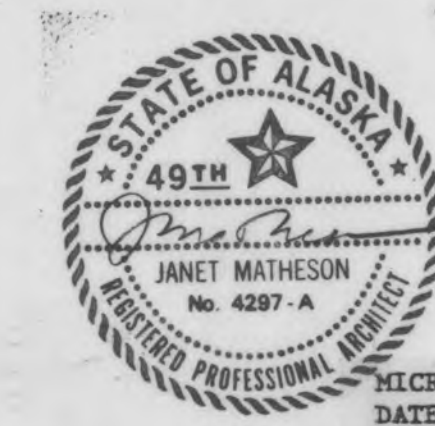


MICROFILMED
DATE: 12/83
MICROFILM NUMBER:

DOOR SCHEDULE										REMARKS		
DOOR	*FRAME	DETAILS	HARDWARE		REMARKS							
DOOR NO.	DOOR SIZE	TYPE	MATERIAL	FINISH	FRAME TYPE	MATERIAL	FINISH	HEAD	JAMB	SILL	GROUP	REMARKS

*NOTE: FOR DOOR FRAME TYPES, SEE SHEET A-16.

ROOM FINISH SCHEDULE										REMARKS	
NO	ROOM NAME	FLOOR	BASE	NORTH	EAST	SOUTH	WEST	CEILING	WALL	CEILING	REMARKS

RESIDENT # 37140- FLOORING: (B08B) CARPET: #55 (ASH-BROWN) BASE: 109 P (RANE) 5/8" (GRN) PAINT: A50A - B08B G30G - GREEN/WHITE

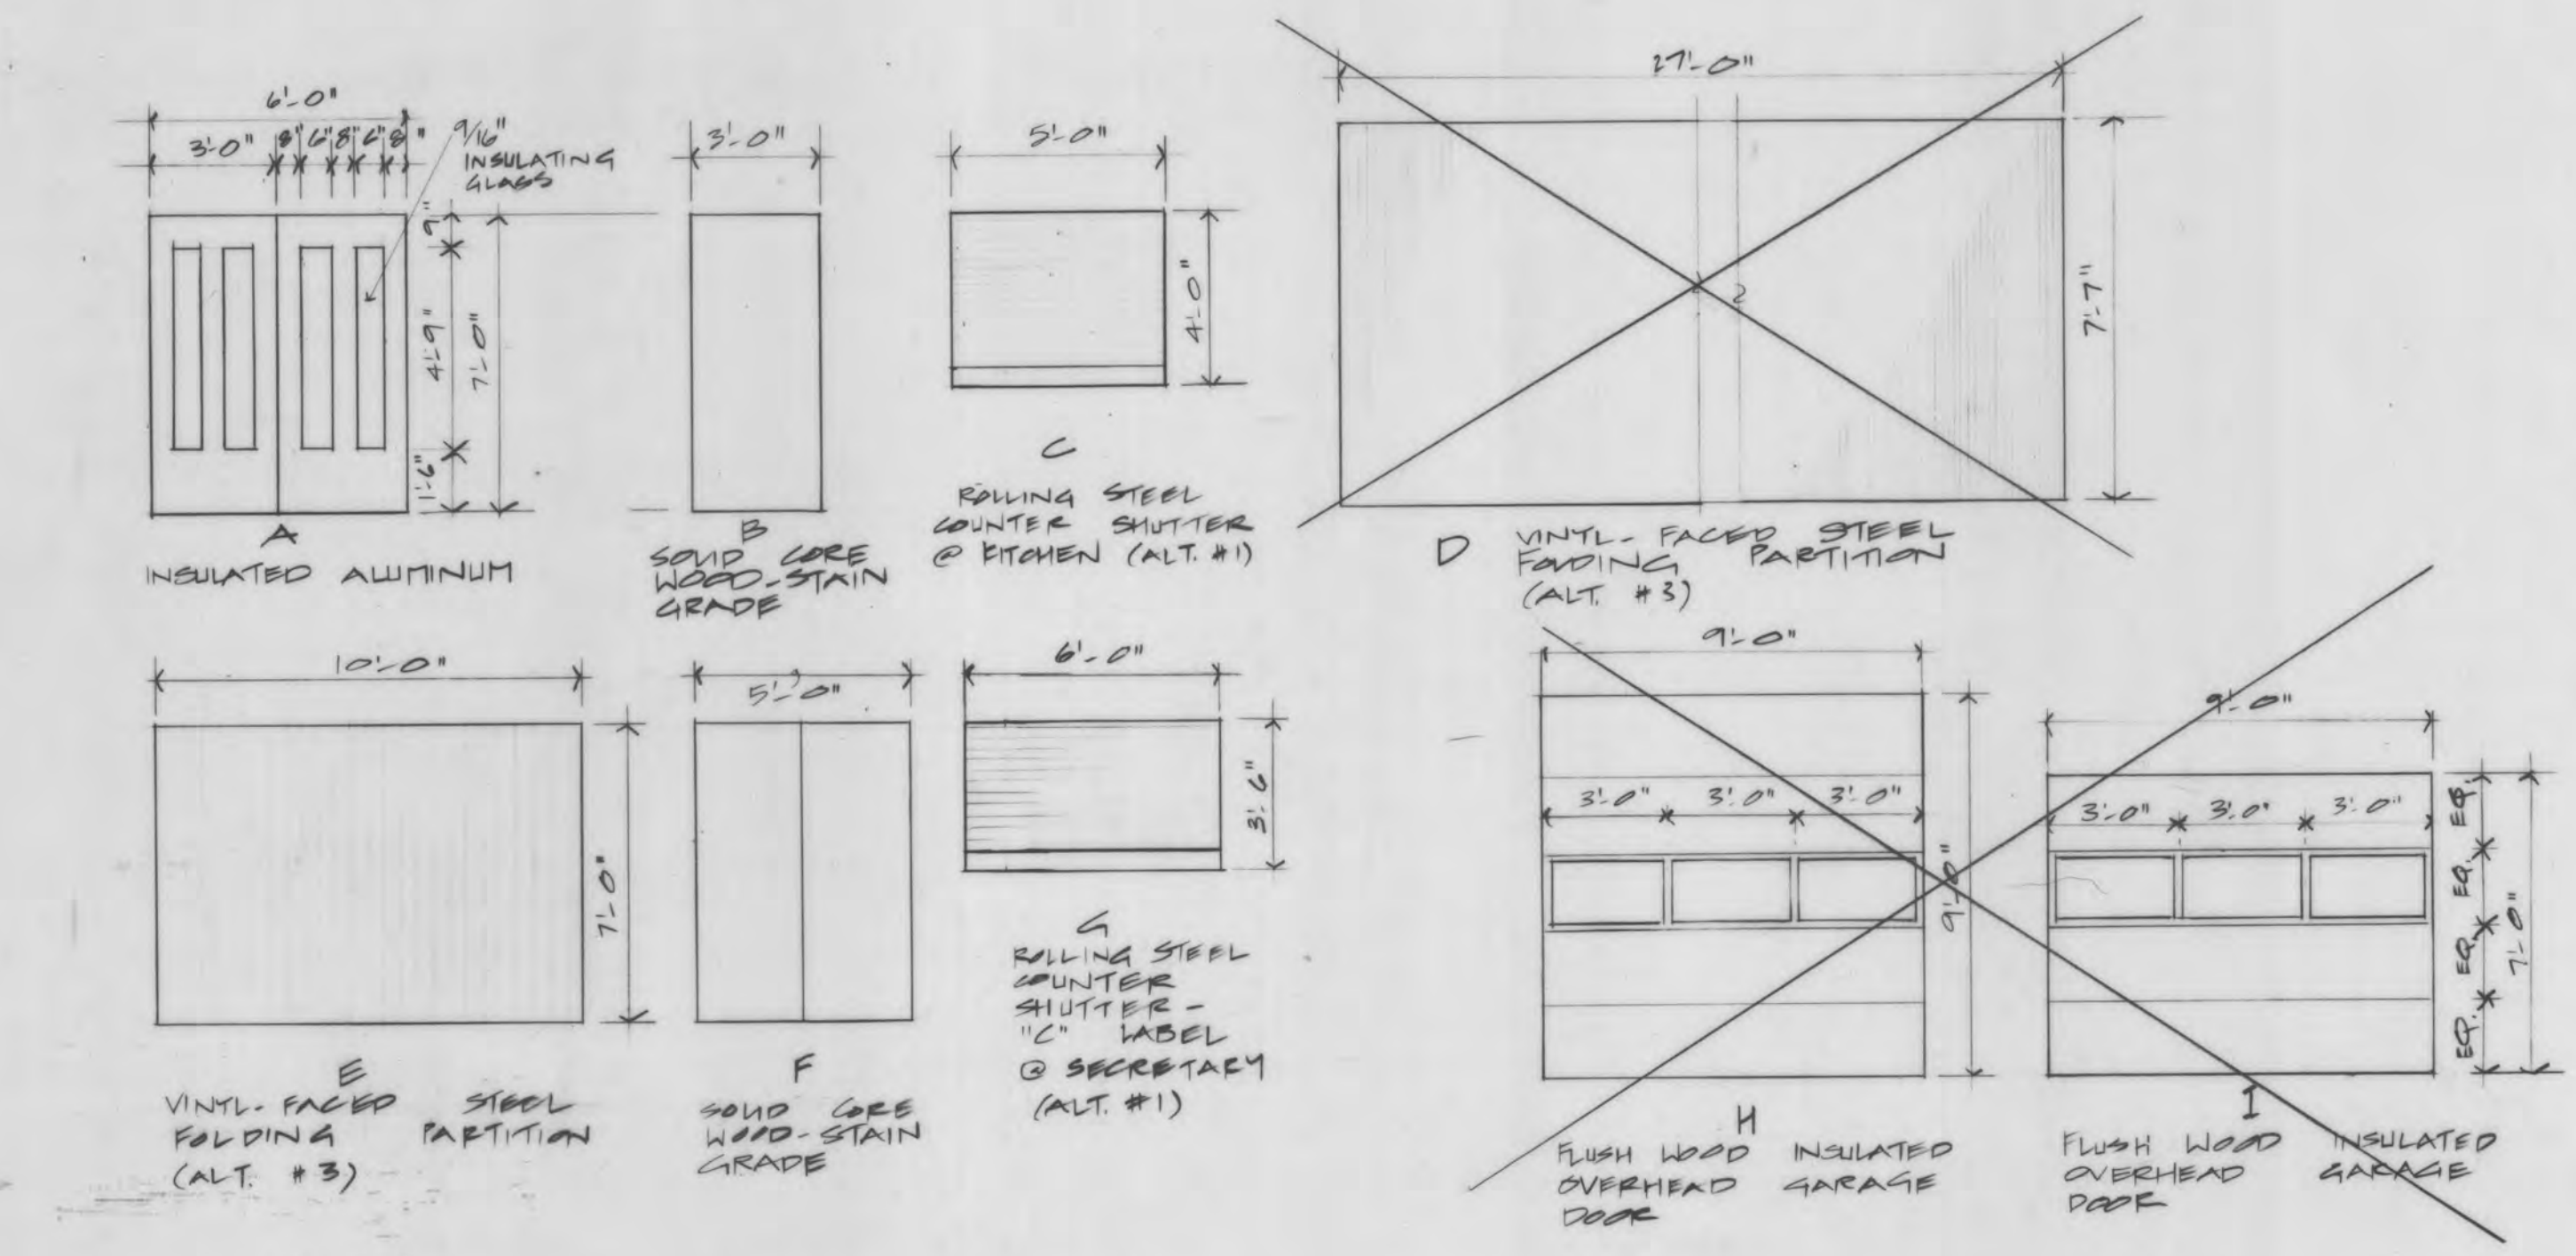

DOOR TYPES
SCALE: 1/4" = 1'-0" (FOR WINDOW TYPES SEE SHEET A-11)