
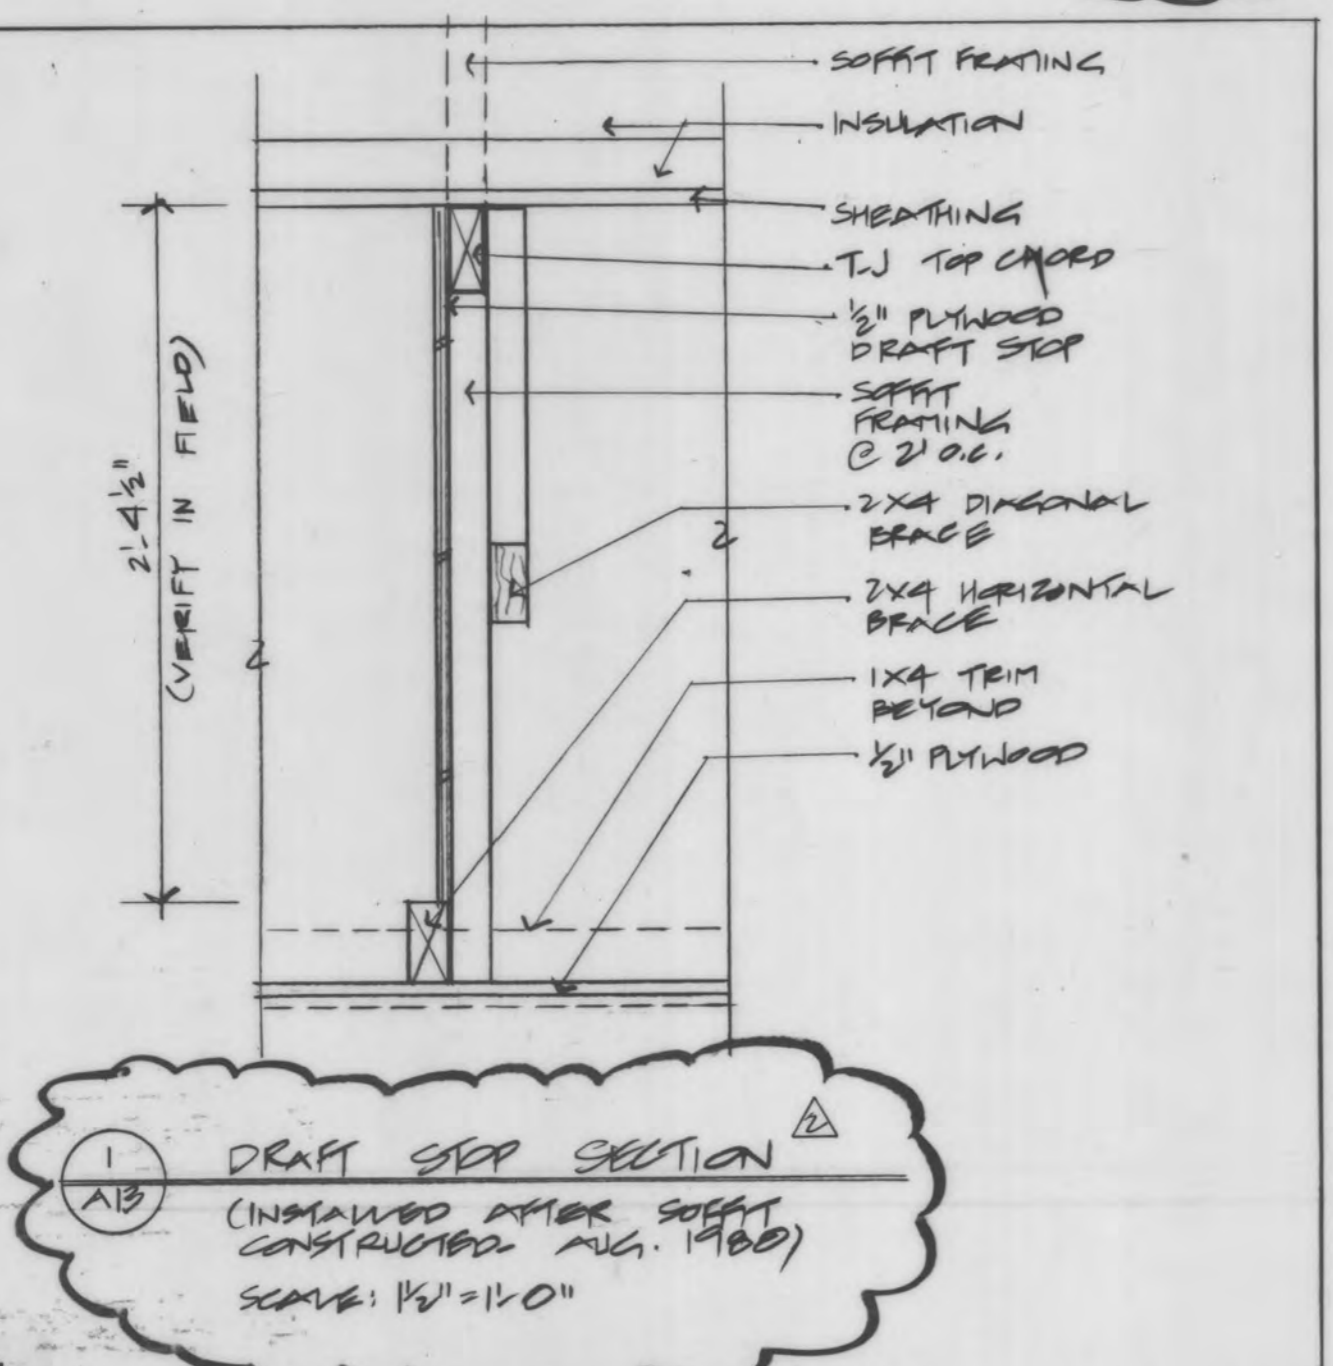


**JANET MATHESON ARCHITECT**

P.O. BOX 81038  
FAIRBANKS,  
ALASKA 99708  
(907) 452-4640

**CITY OF FAIRBANKS  
SENIOR CITIZENS RECREATION  
& NUTRITION CENTER**

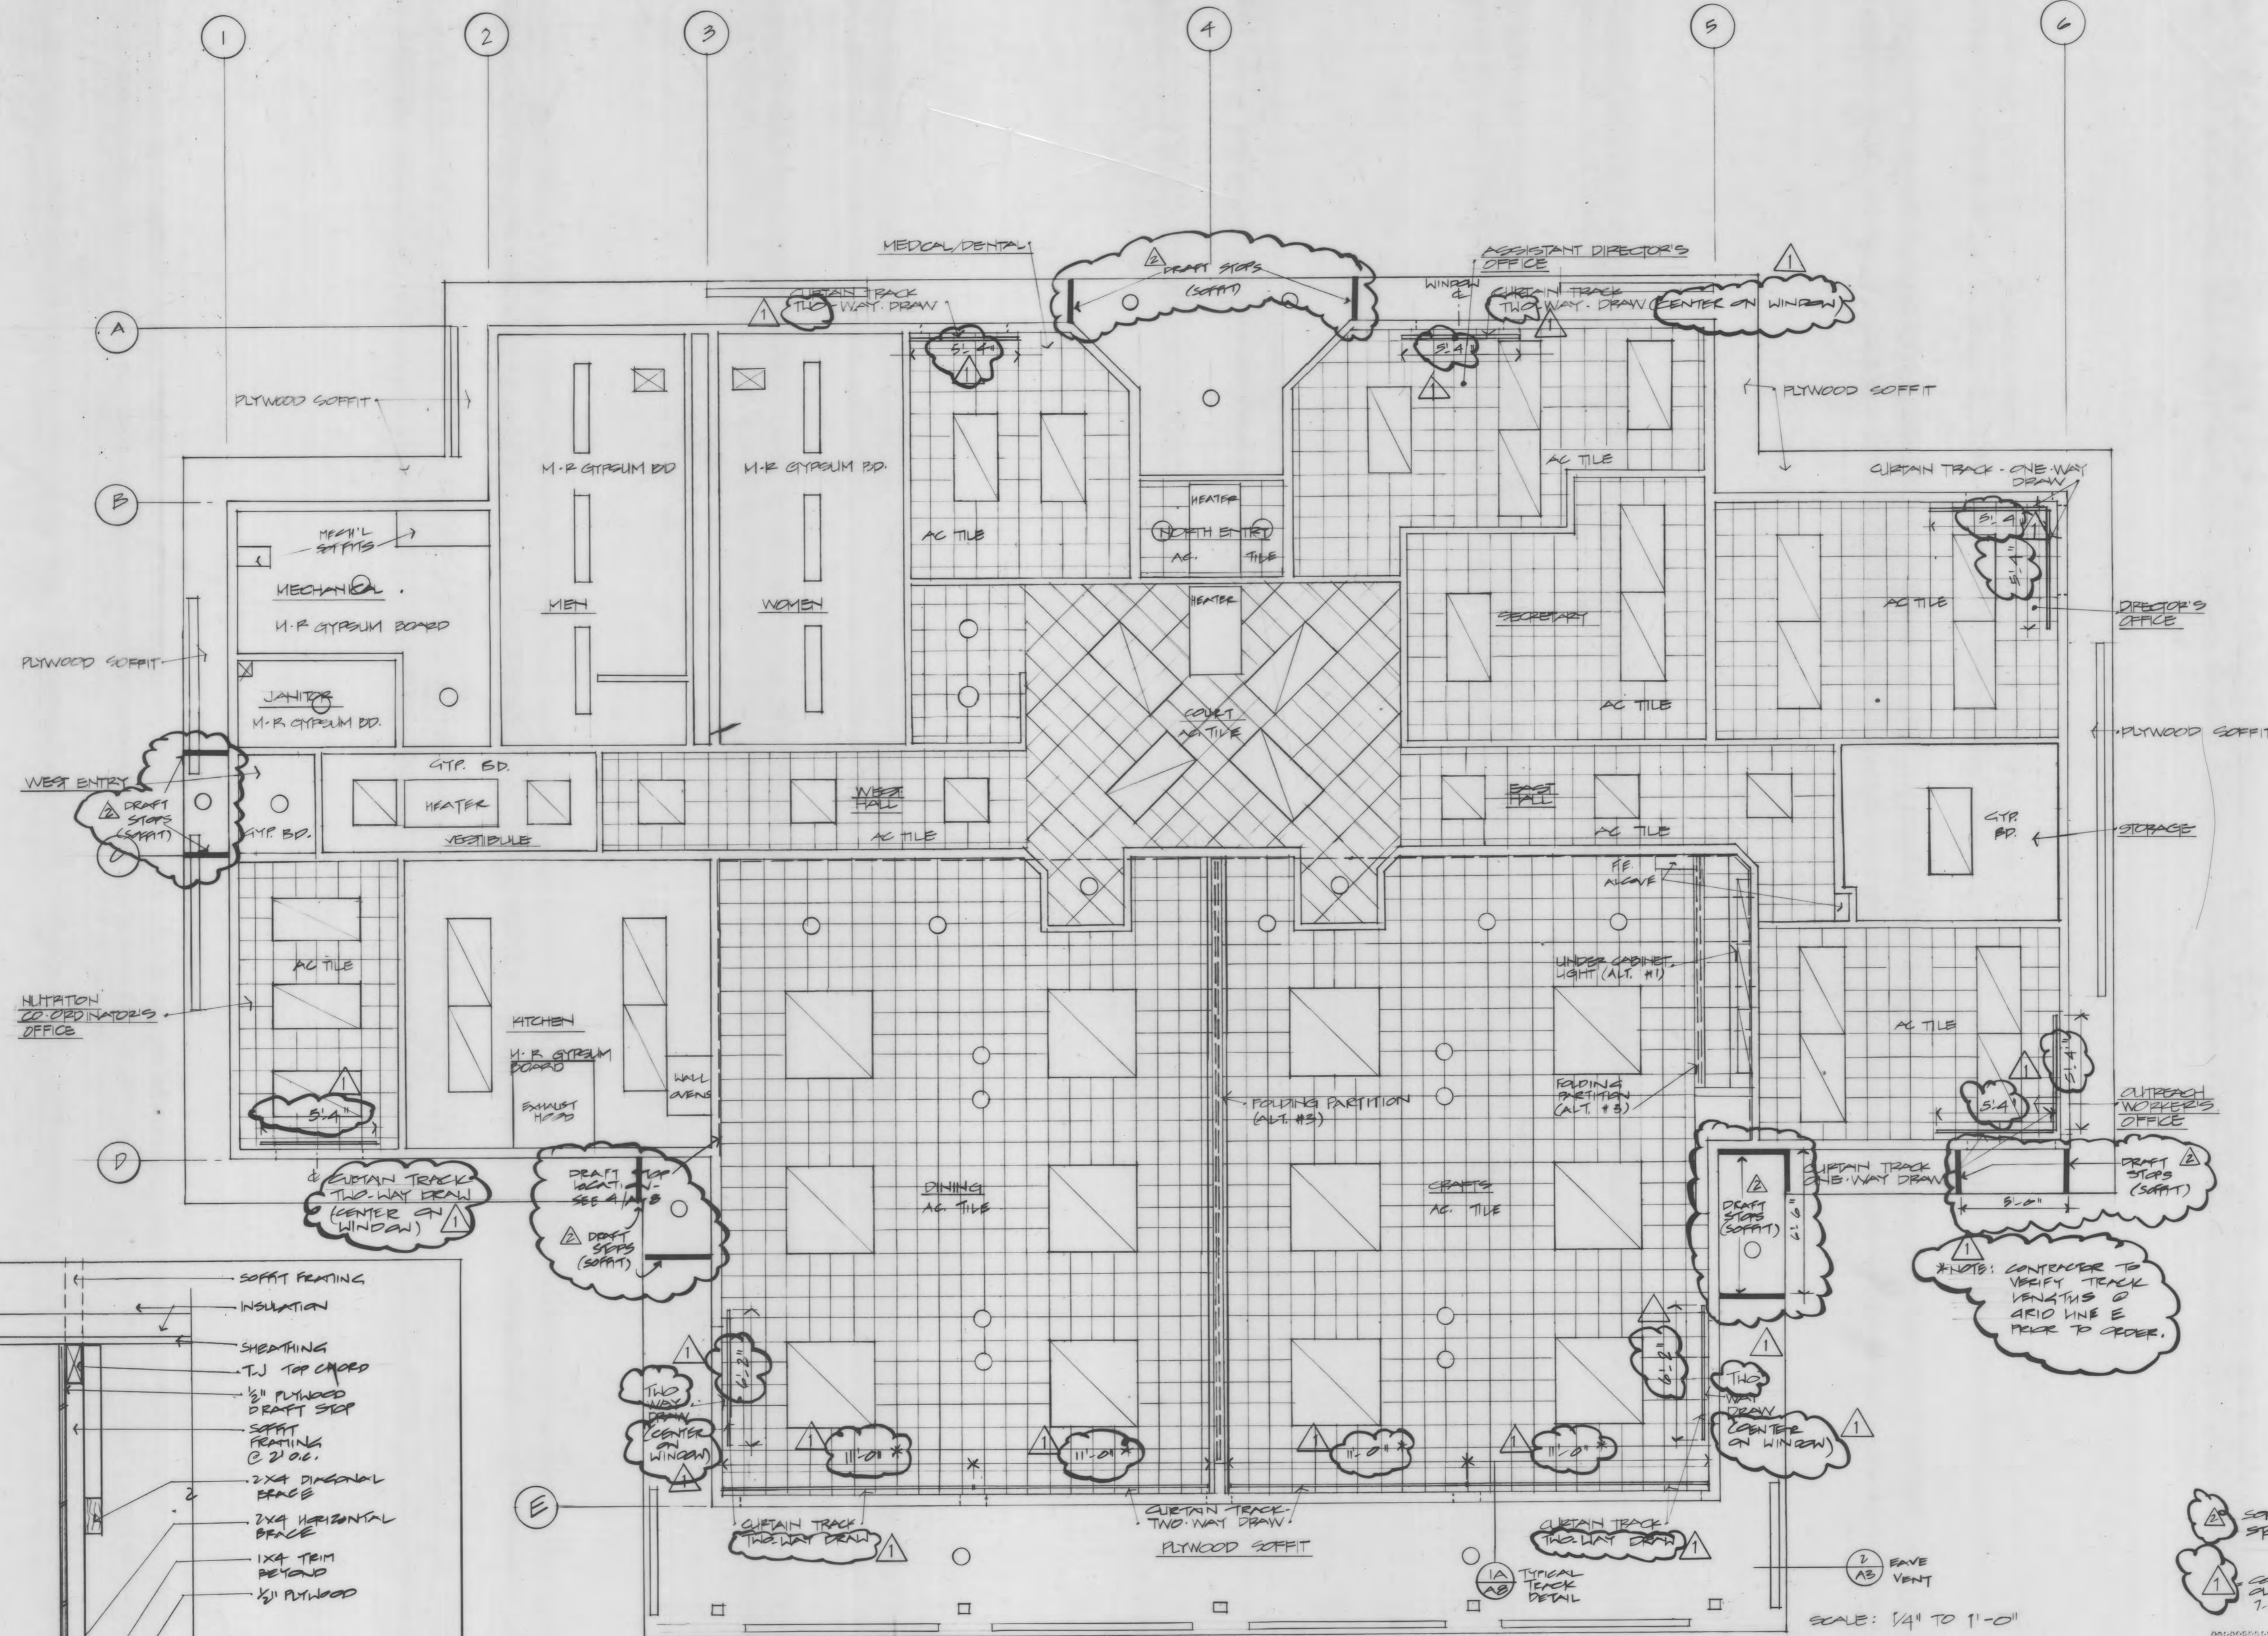

**DRAFT STOP SECTION**  
(INSTALLED AFTER SOFFIT  
CONSTRUCTION AUG. 1980)  
SCALE: 1/2" = 1'-0"

\*NOTE: CONTRACTOR TO VERIFY TRACK VENTILATION GRID LINE E MARK TO CORRECT.

SOFFIT DRAFT STOPS - 8-26-80  
CONSTANT QUALIFICATION 7-25-80



MICROFILMED  
DATE: 8/83  
MICROFILM NUMBER:

SCALE: 1/4" TO 1'-0"

REFLECTED  
CEILING  
PLAN  
REBID

SHT #

**A13**

DWN GH CKD JT  
DATE: 8/83 PROJ: 171  
C6.0.167