

**CITY OF FAIRBANKS  
SENIOR CITIZENS RECREATION  
& NUTRITION CENTER**

CONSTRUCTION CHANGES  
ADDENDUM NO. 1


RECID  
INTERIOR WALL  
SECTIONS  
&  
DETAILS

SHT #

**A12**

DWN JH CKD  
DATE 2-22-83 PROJ # 791

C6.0.168

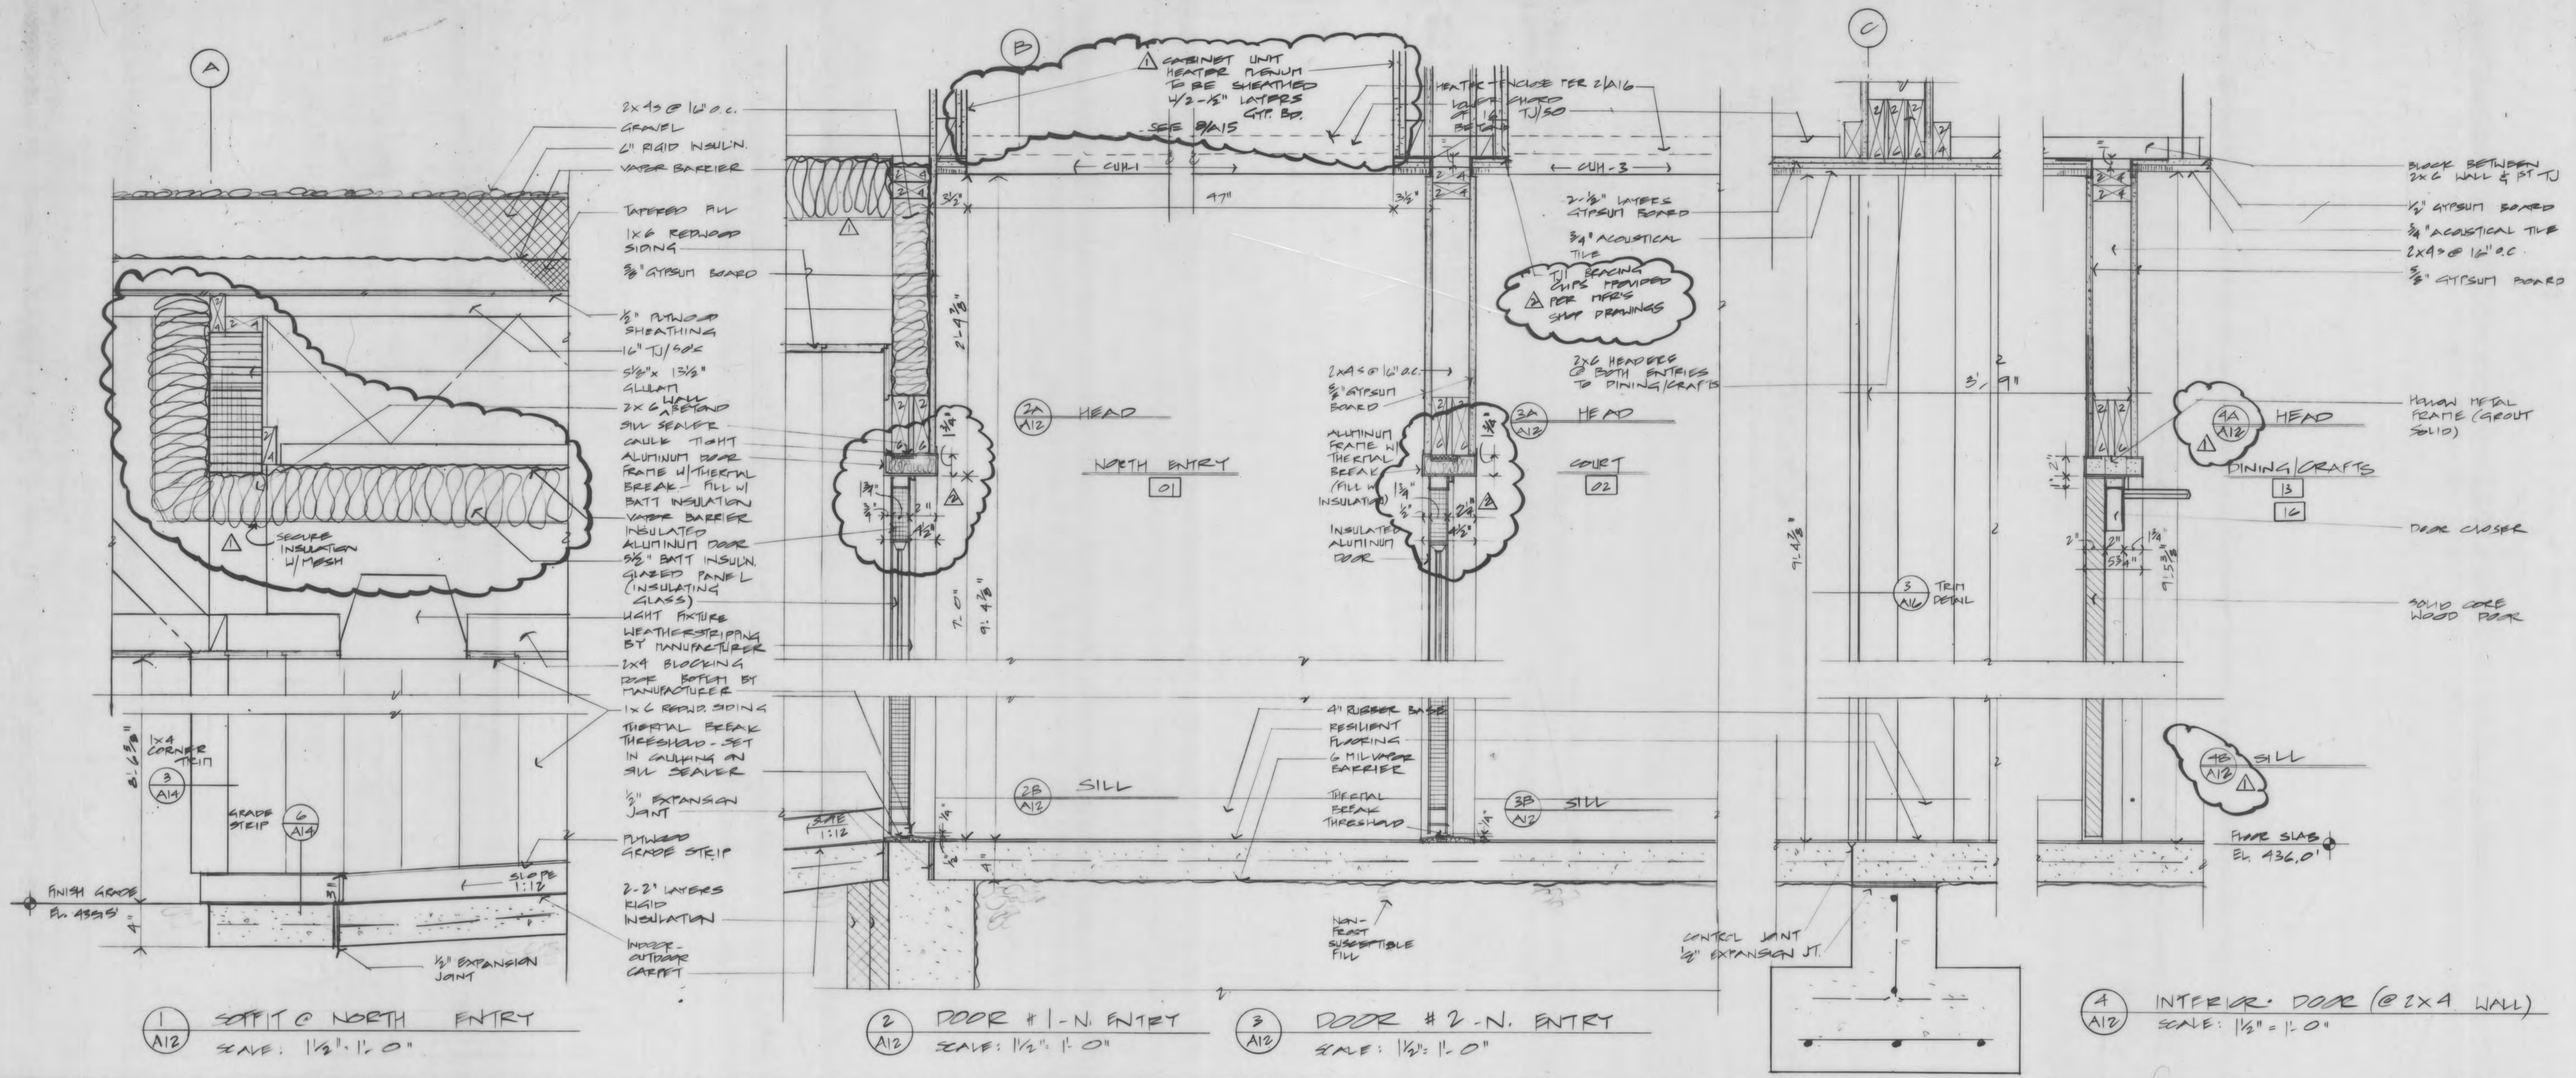


1 SECTION OF NORTH ENTRY  
SCALE: 1/2" = 1'-0"


2 DOOR # 1 - N. ENTRY  
SCALE: 1/2" = 1'-0"

3 DOOR # 2 - N. ENTRY  
SCALE: 1/2" = 1'-0"

4 INTERIOR DOOR @ 2x4 WALL  
SCALE: 1/2" = 1'-0"

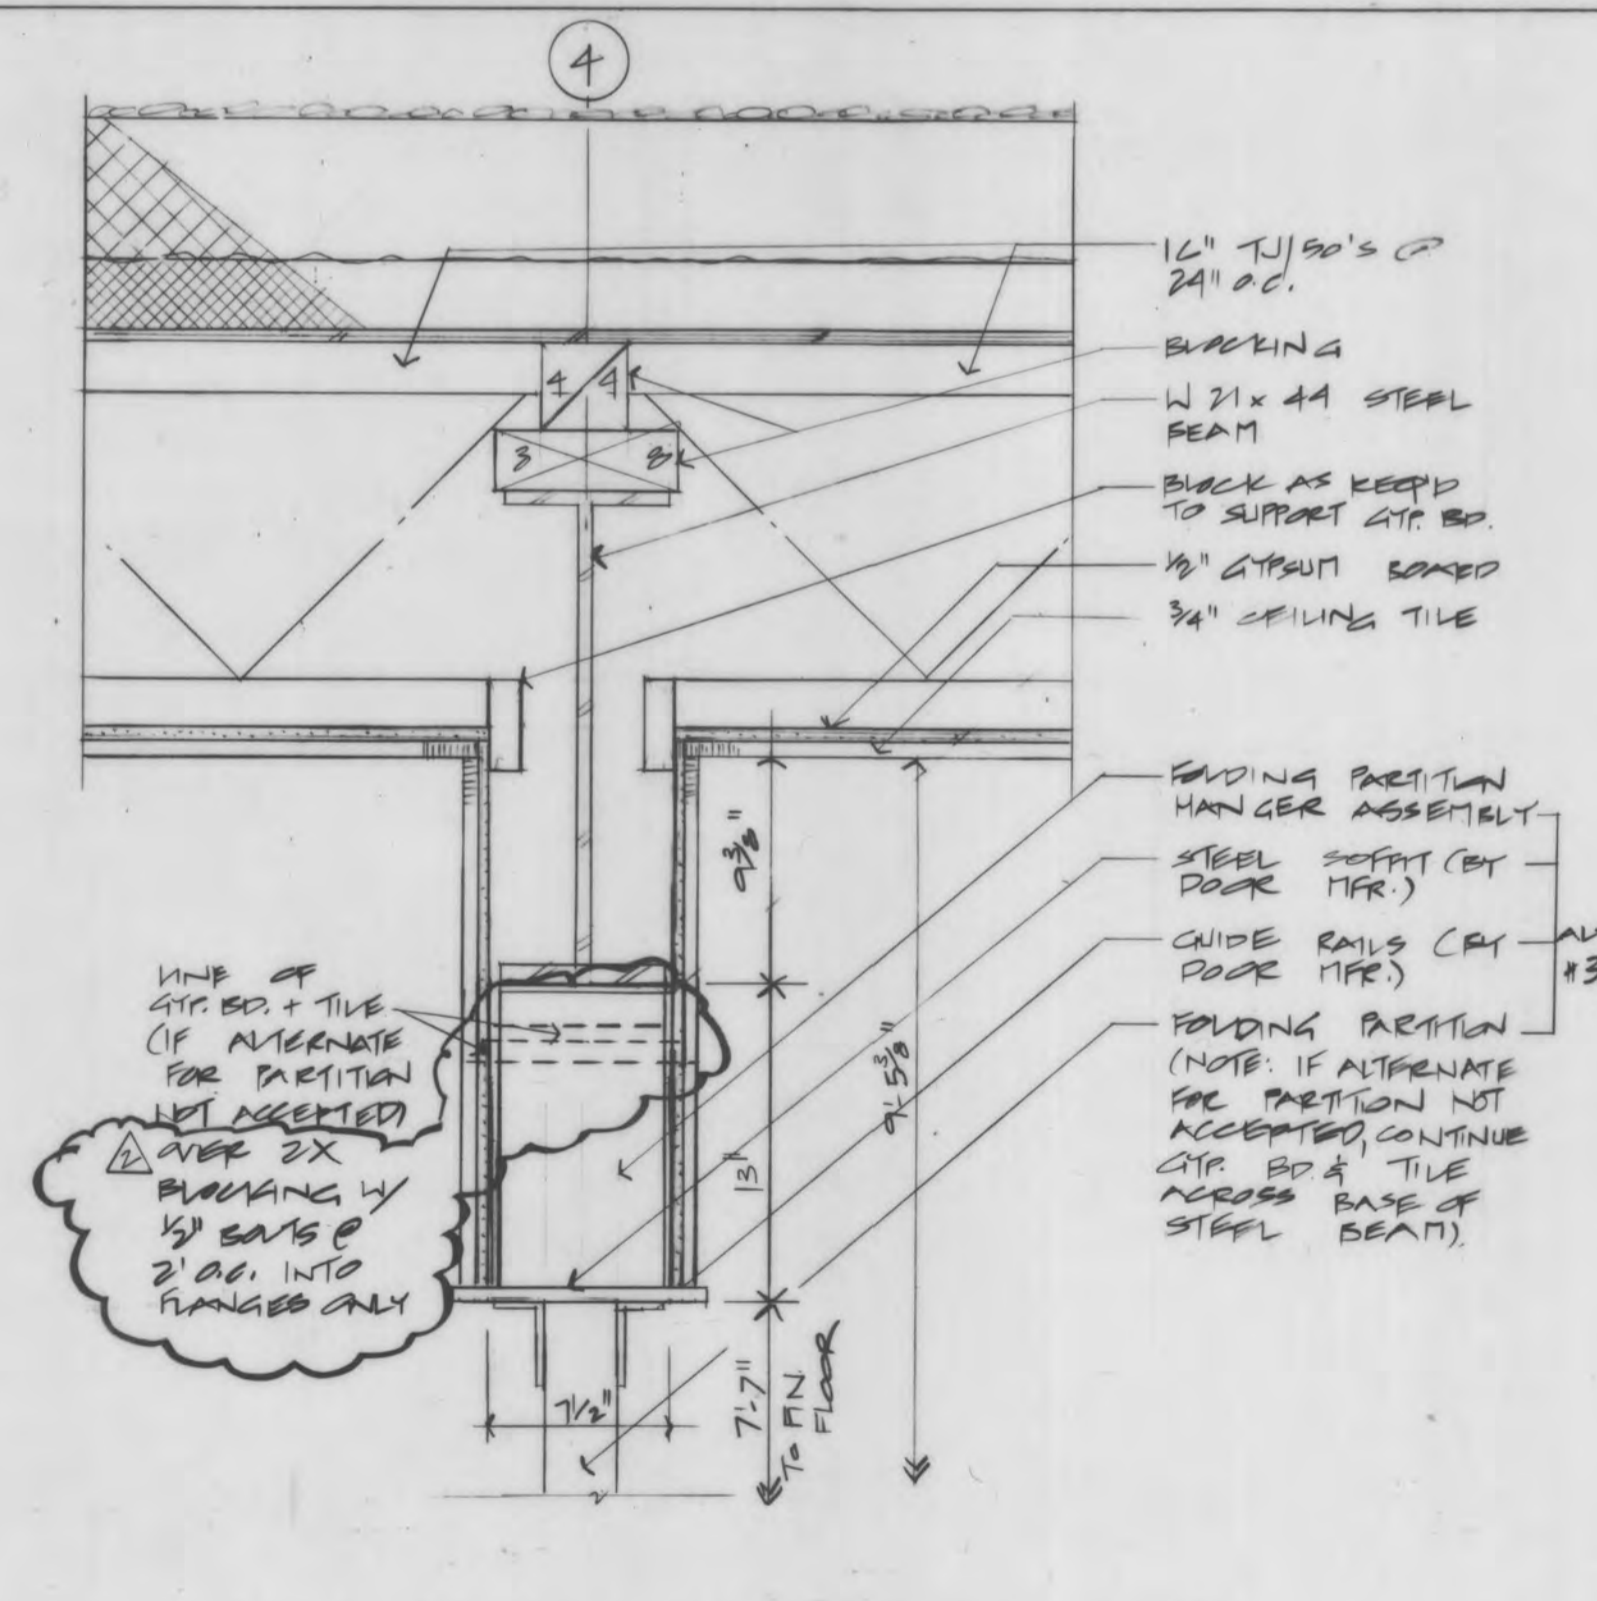


5 PARTITION SUPPORT DETAIL  
SCALE: 1/2" = 1'-0"

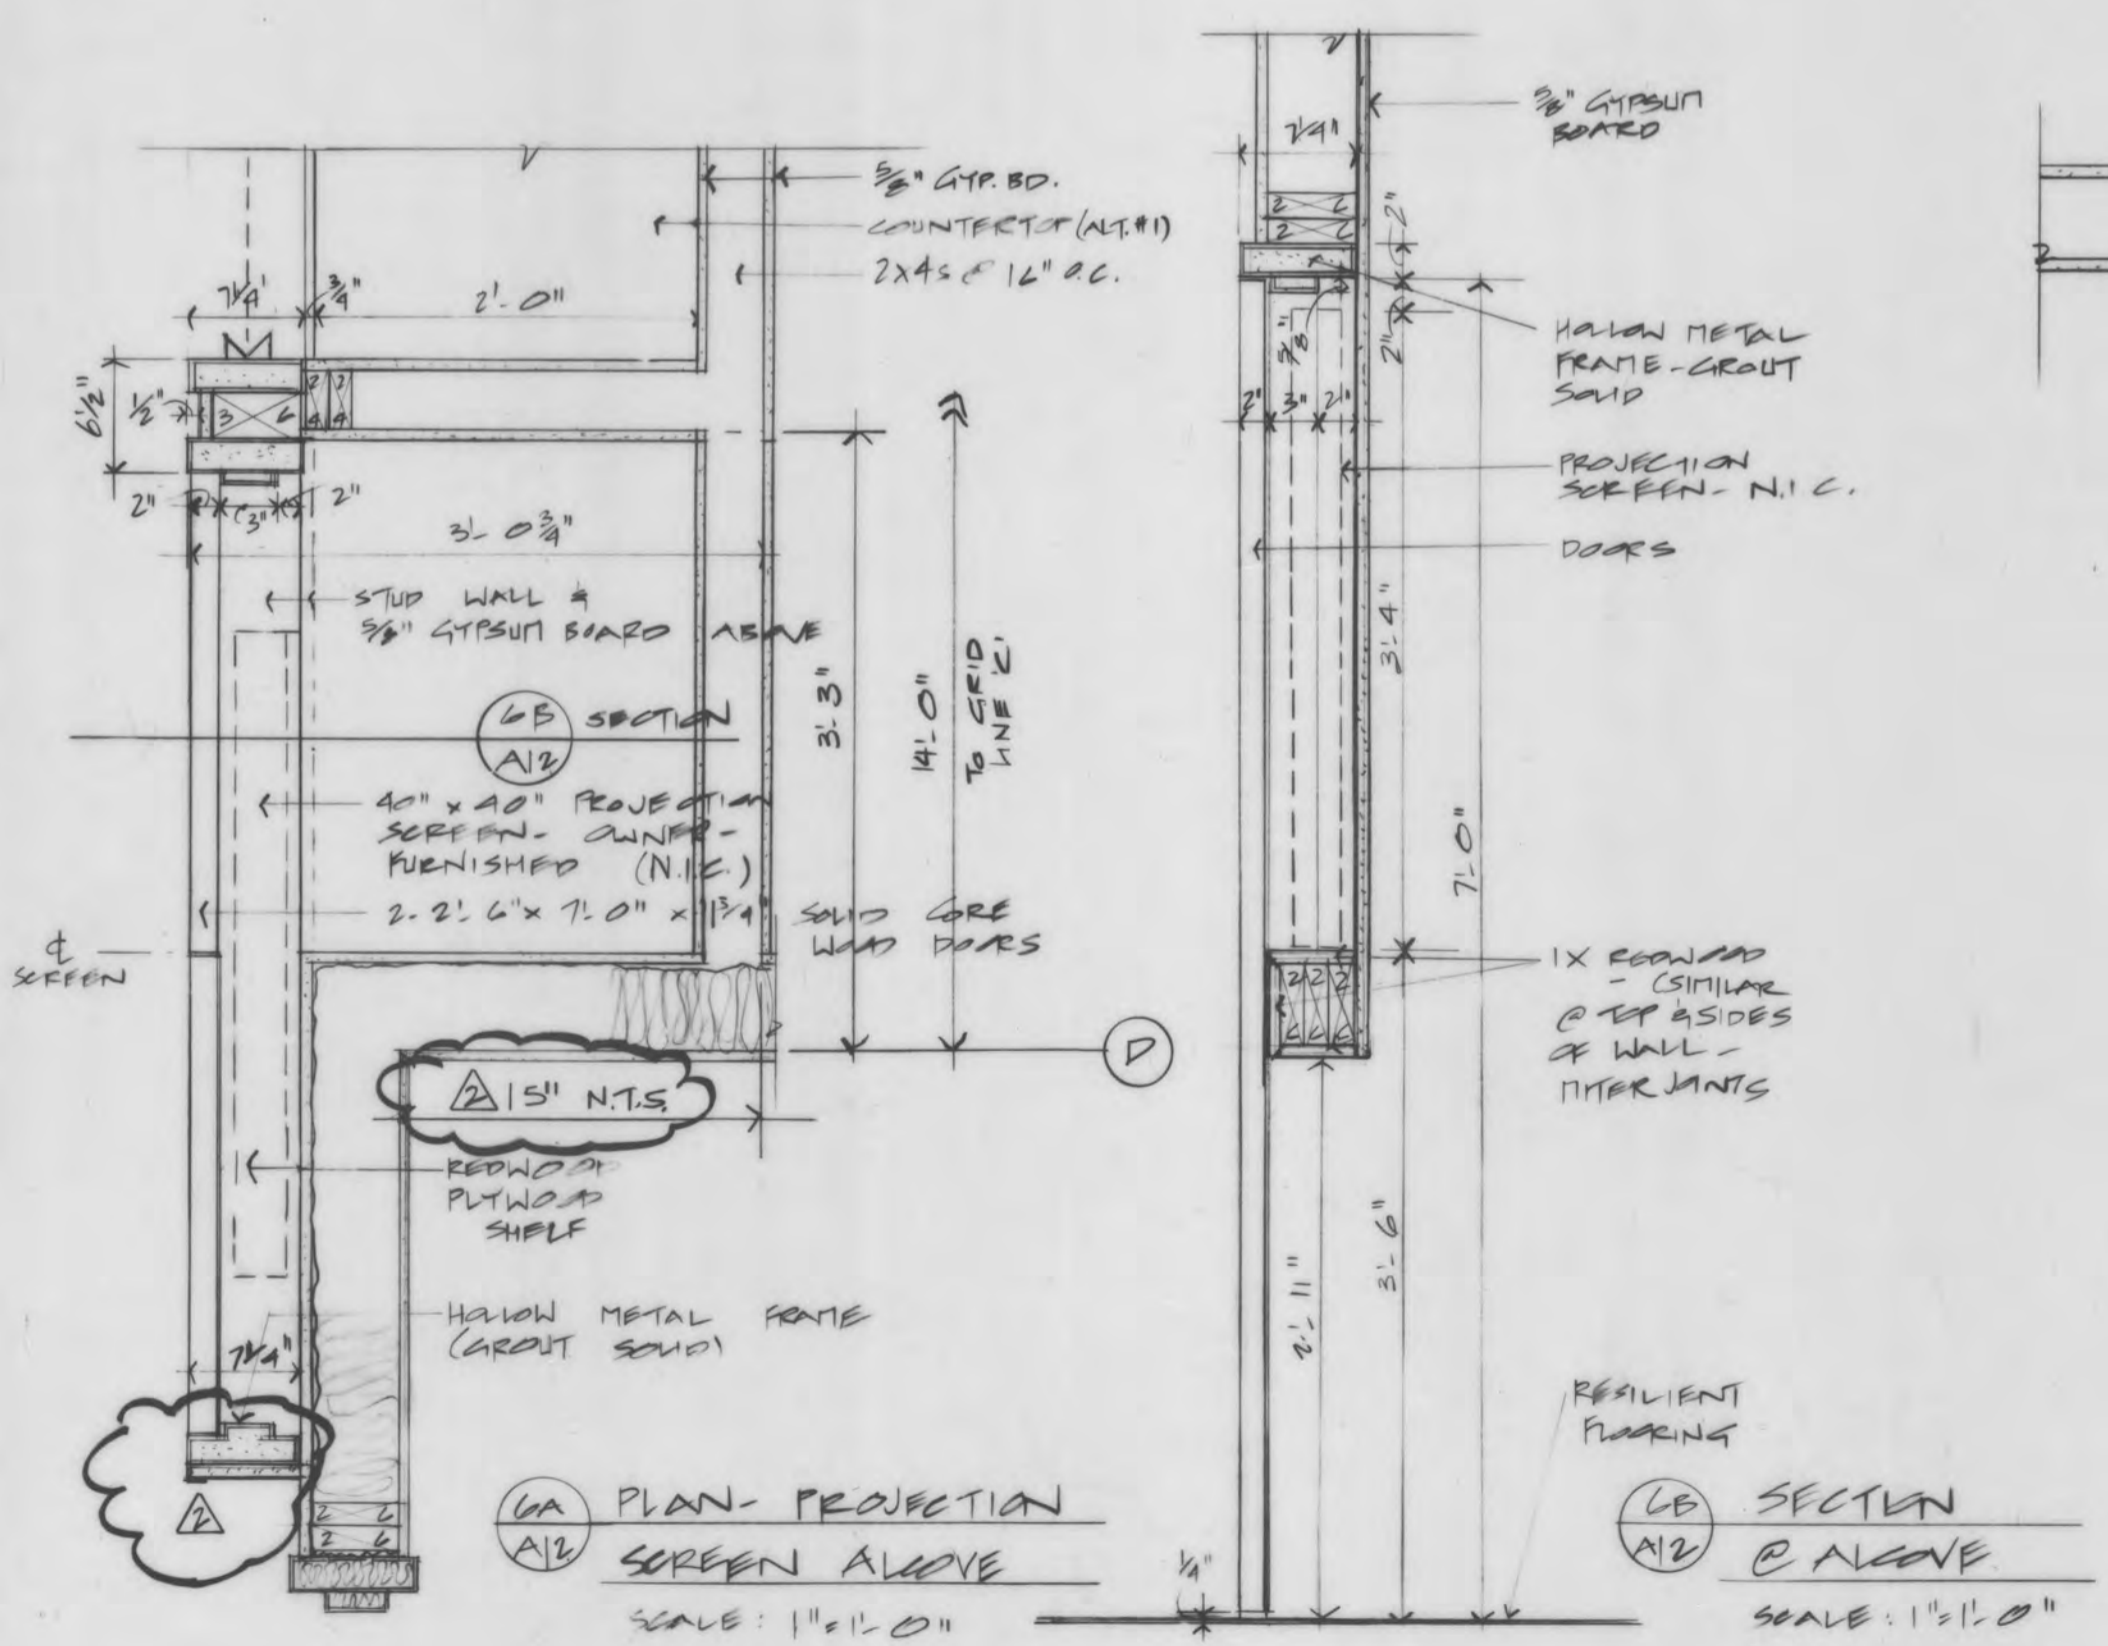

SCALE: 1" = 1'-0"

SCALE: 1" = 1'-0"

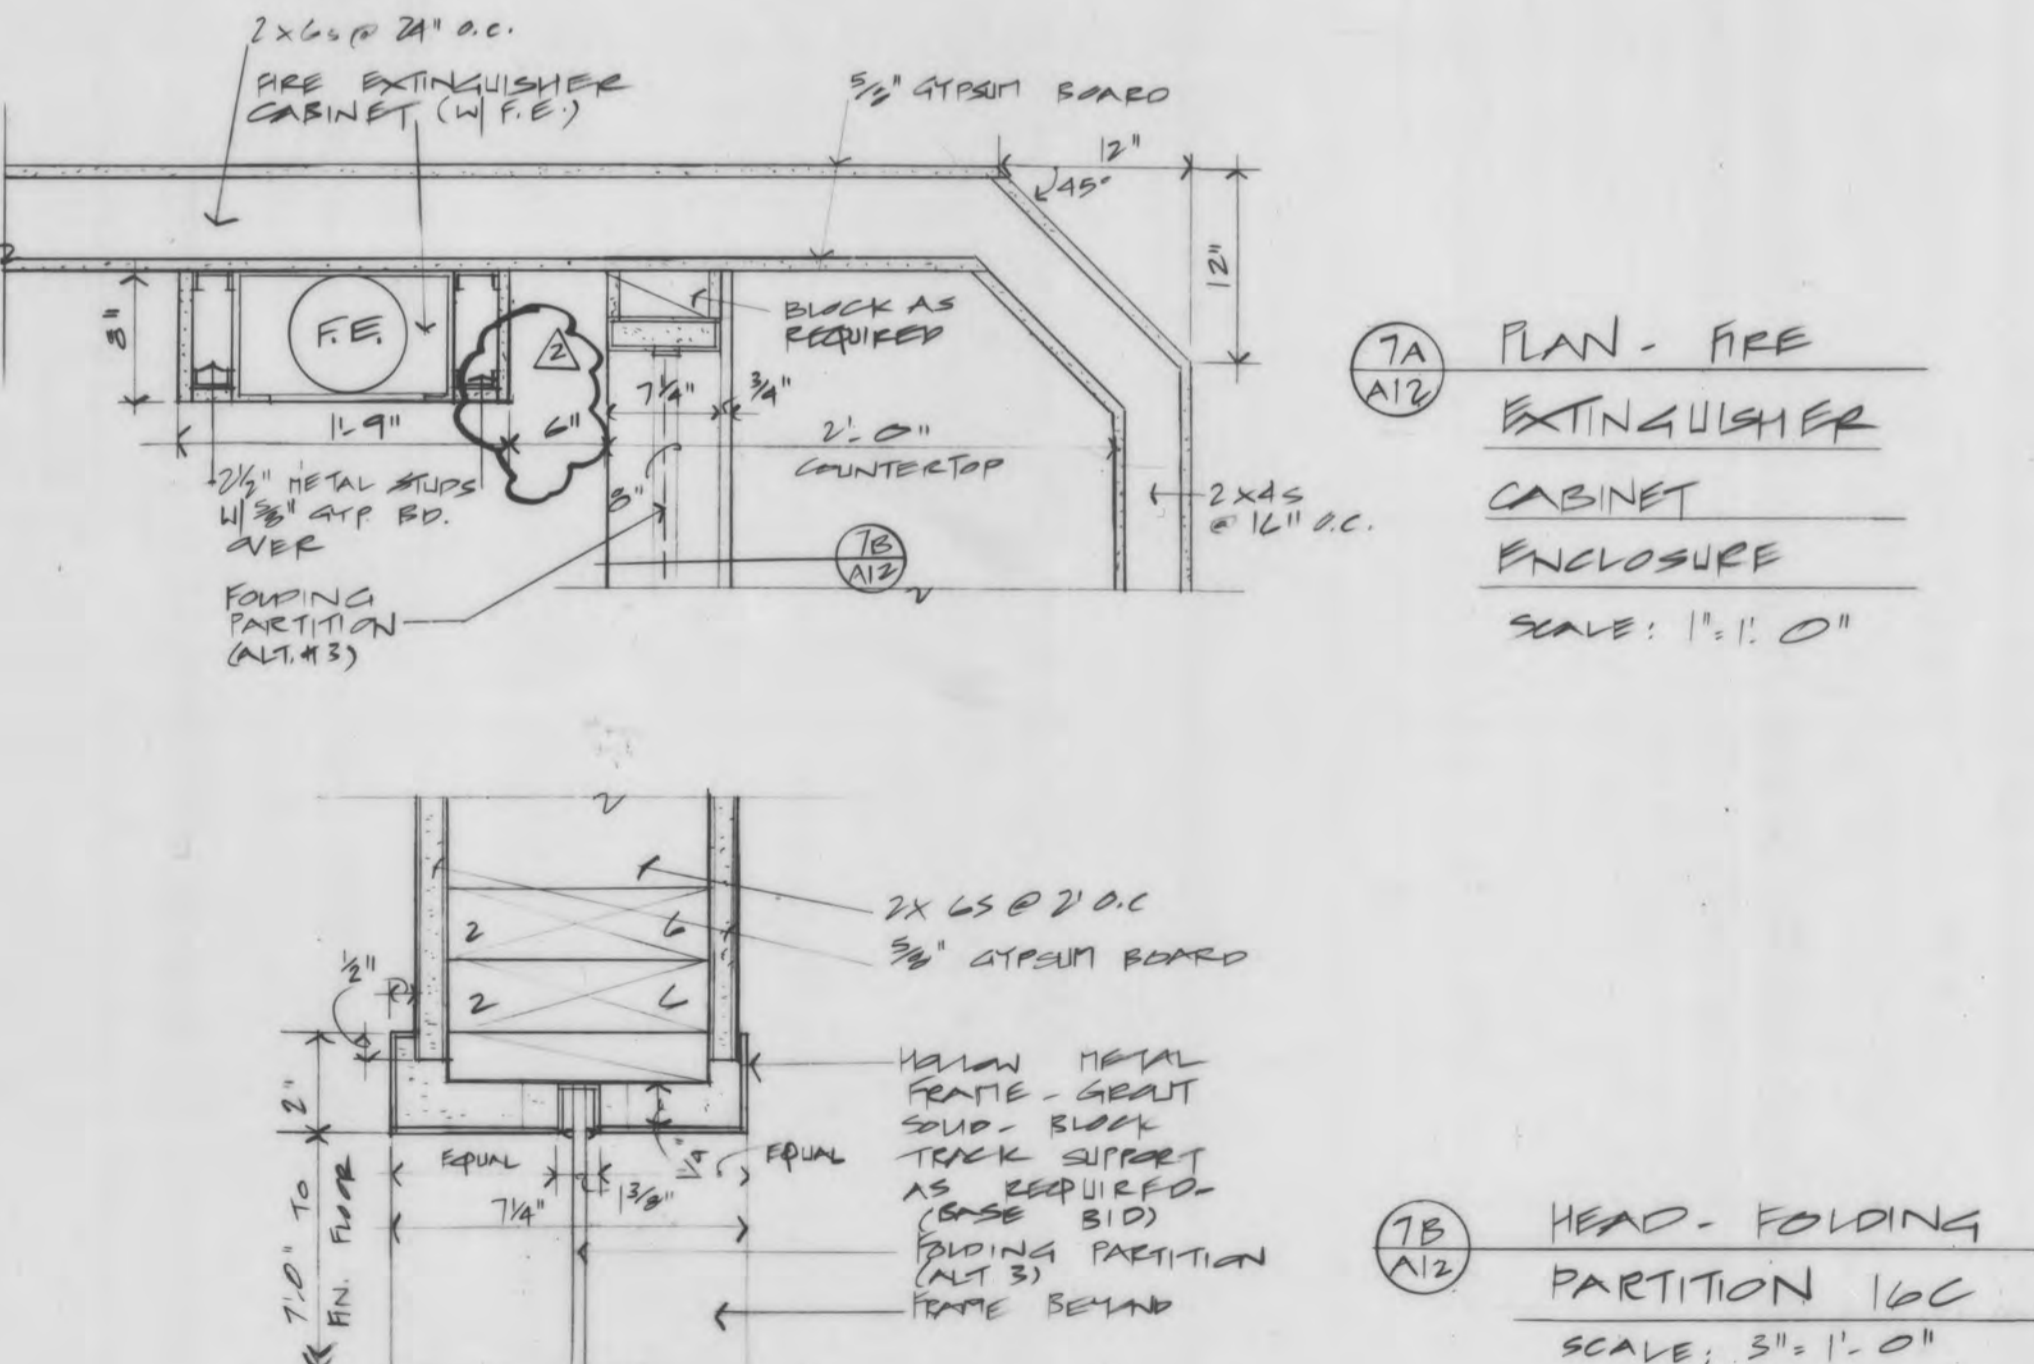

7A PLAN - FIRE EXTINGUISHER CABINET ENCLOSURE  
SCALE: 1" = 1'-0"

7B HEAD - FOLDING PARTITION 16C  

MICROFILMED  
DATE: 12/83  
MICROFILM NUMBER:

