

CITY OF FAIRBANKS  
SENIOR CITIZENS RECREATION  
& NUTRITION CENTER

CONSTRUCTION CHANGES  
APPENDIX NO. 1

EXTERIOR  
WALL  
SECTIONS  
REBID






SHT #

A8

OWN JH OKD Jm  
DATE: 12/83  
PROJ # 791  
C6.0.172



MICROFILMED  
DATE: 12/83  
MICROFILM NUMBER:

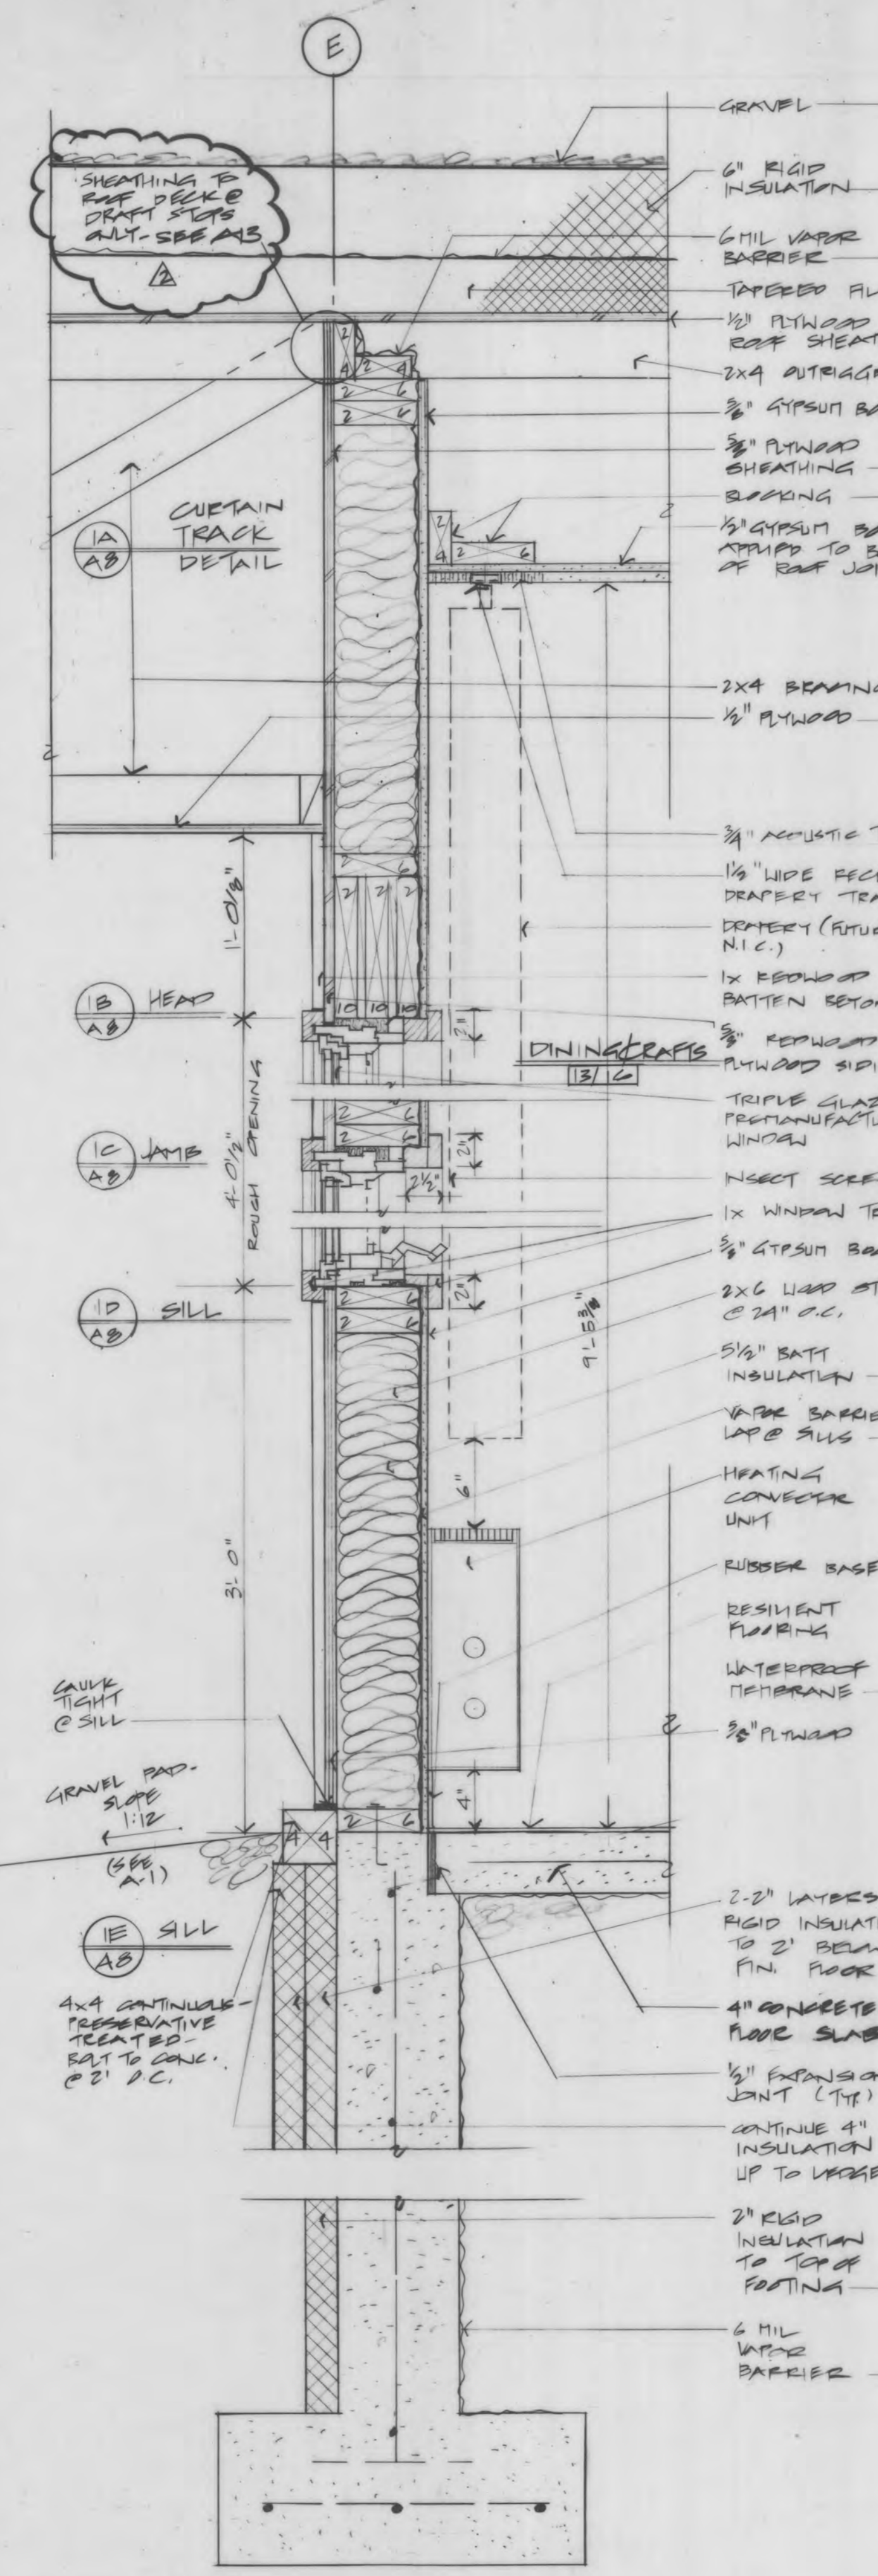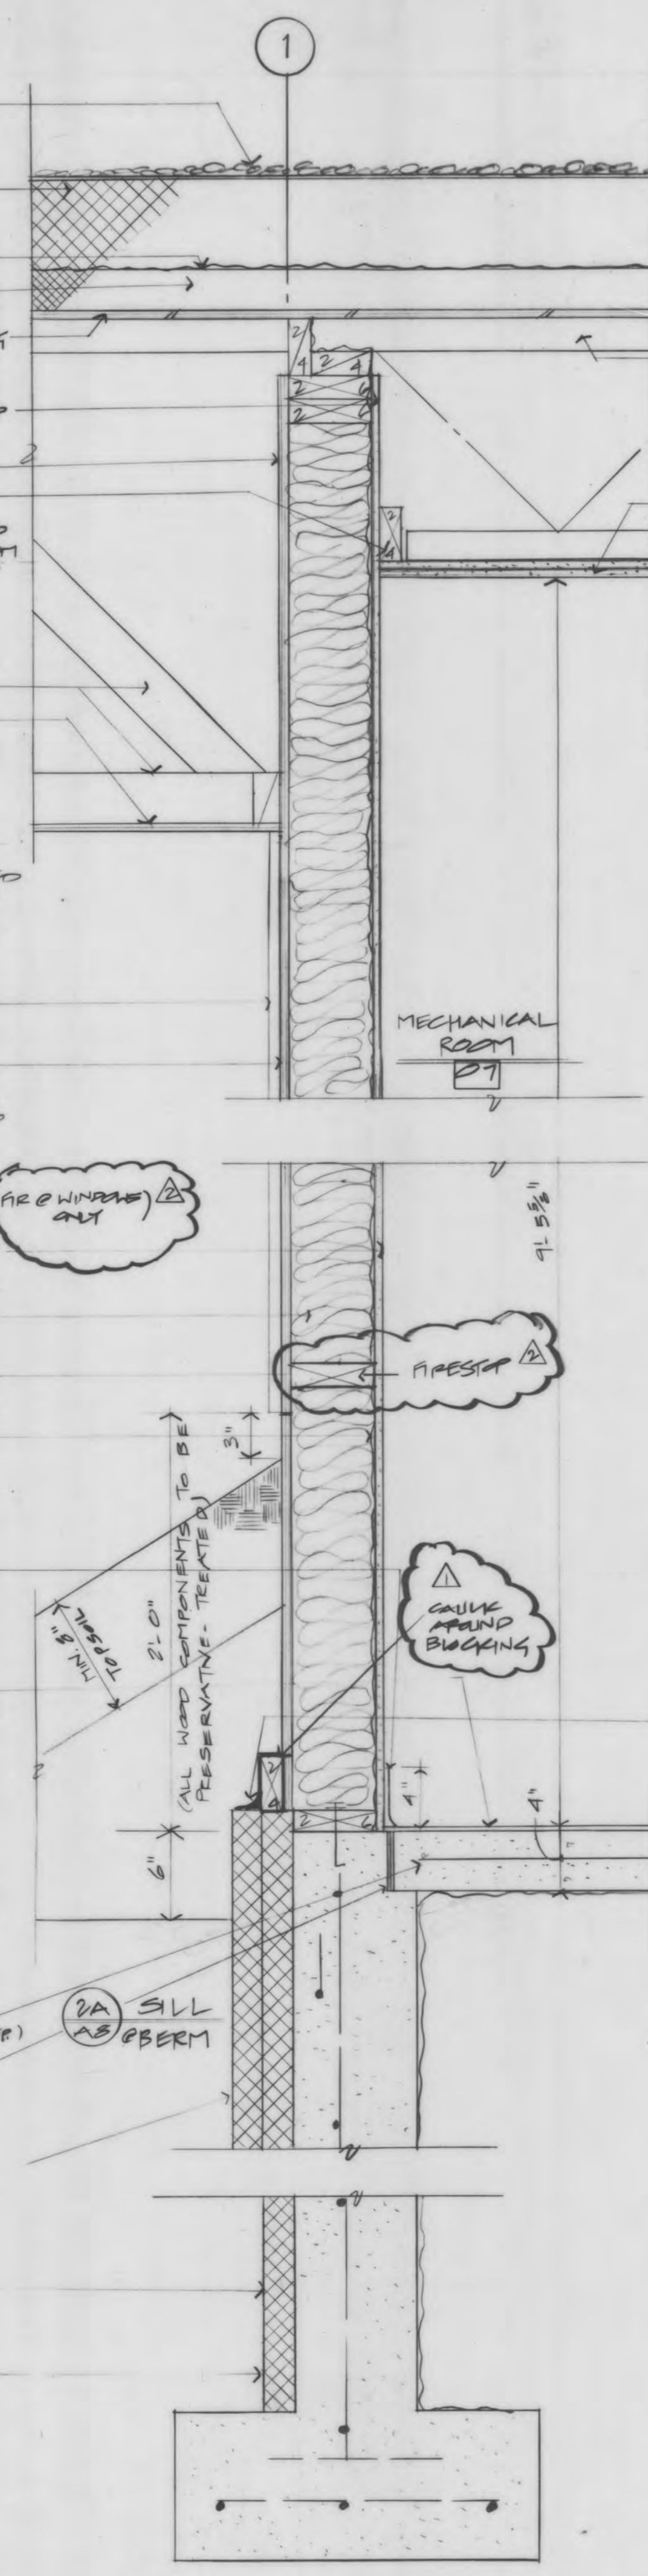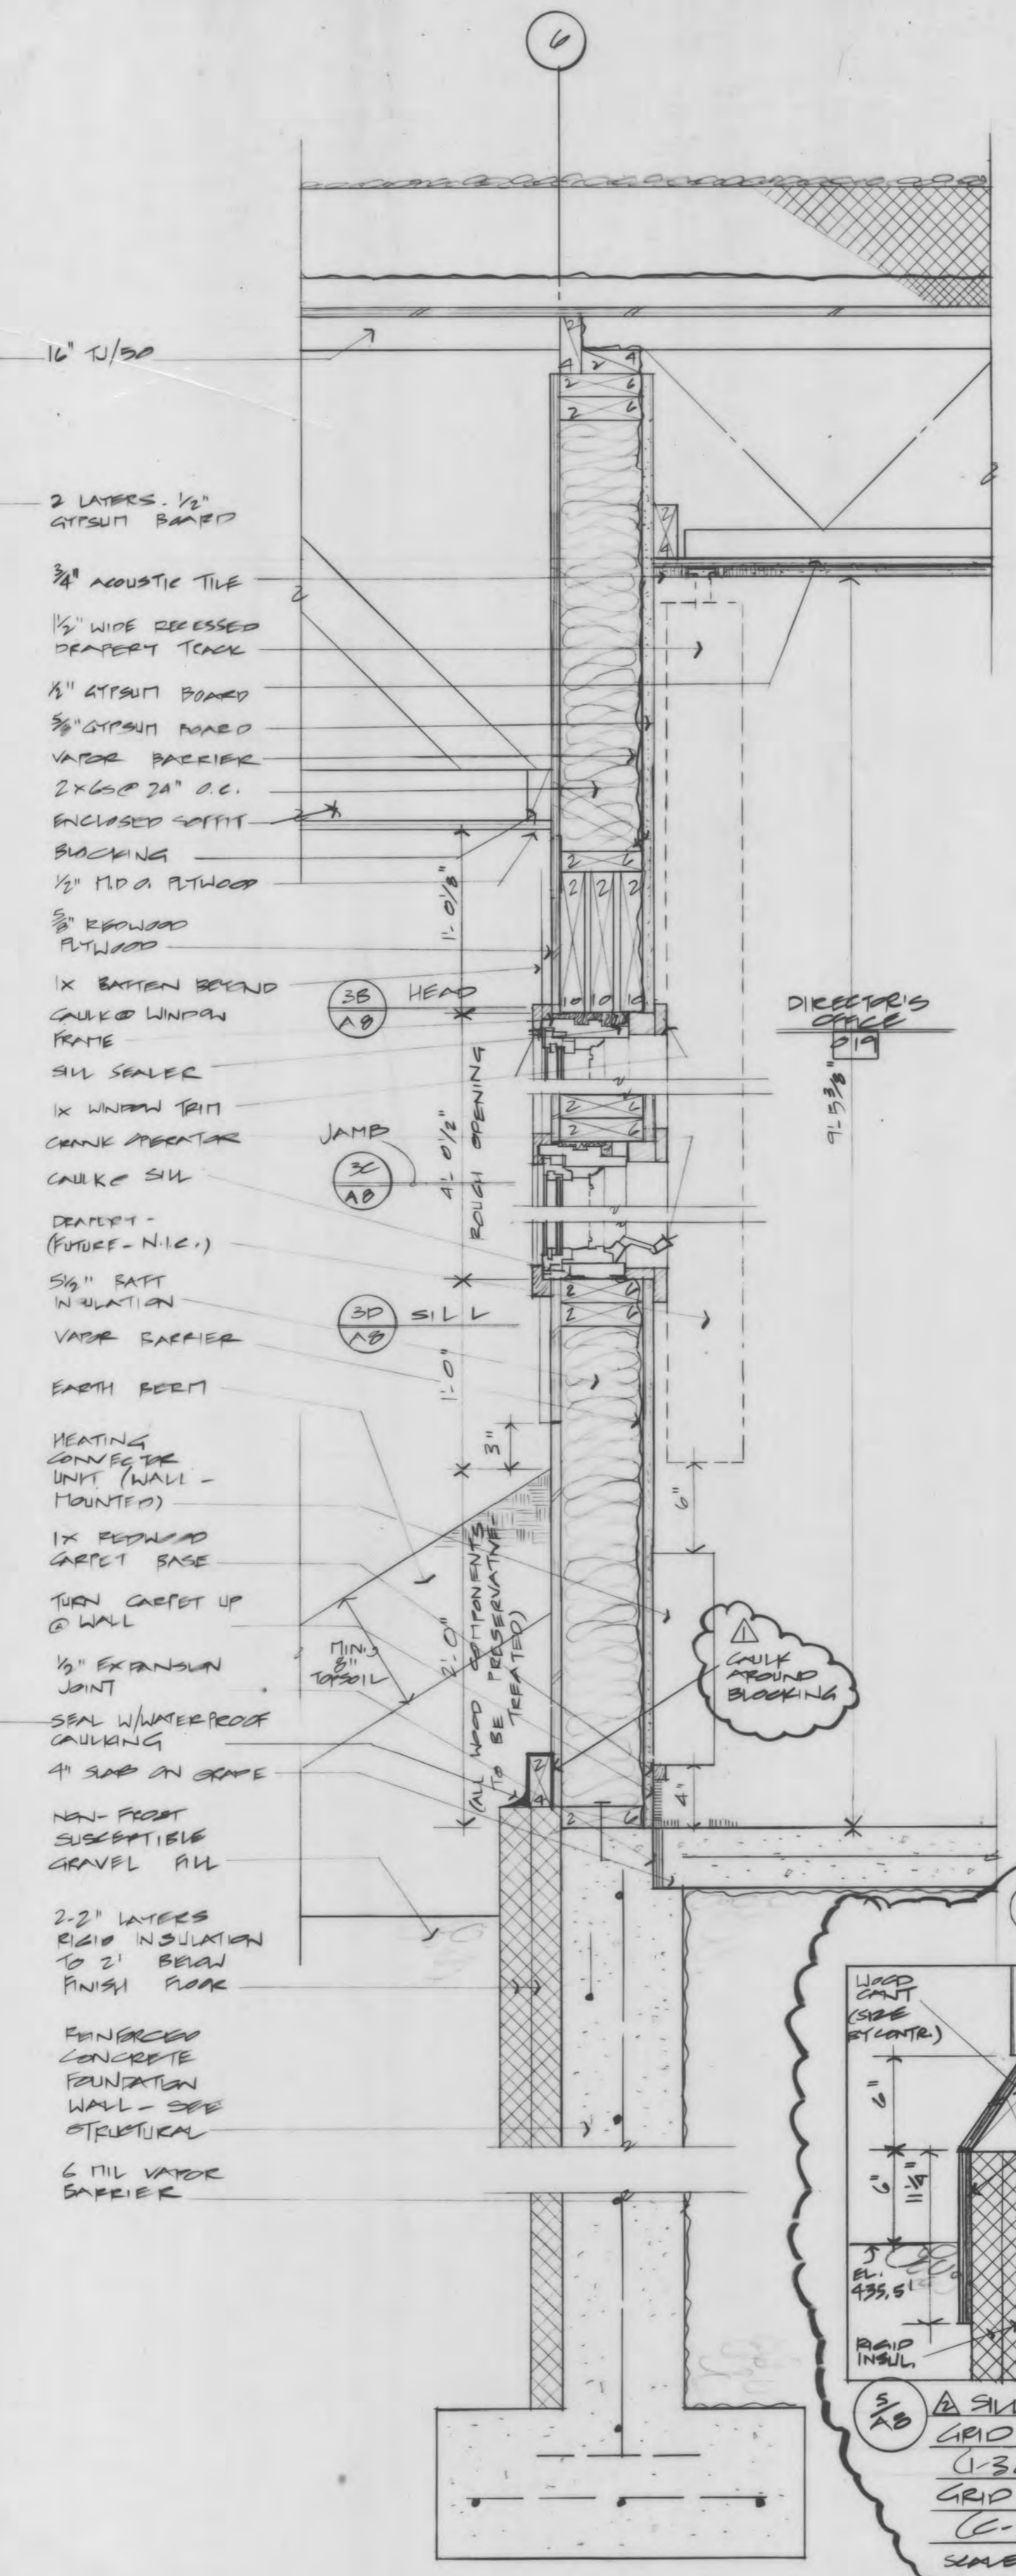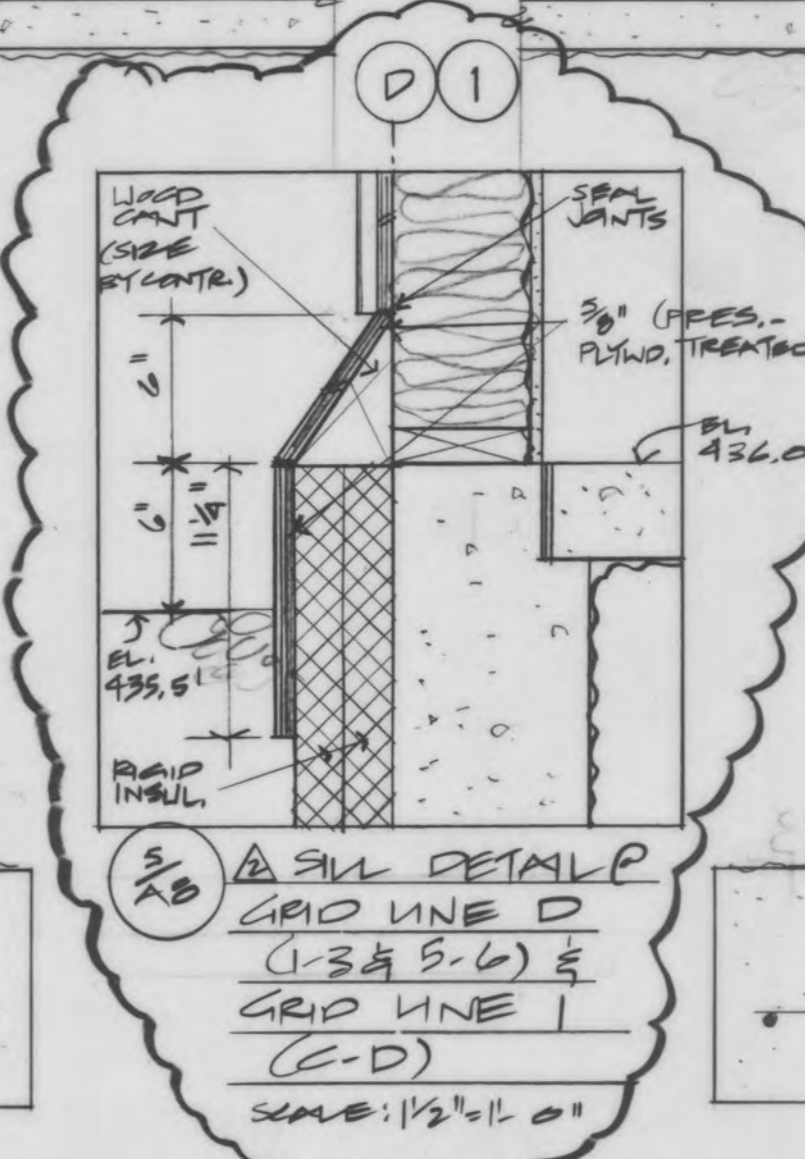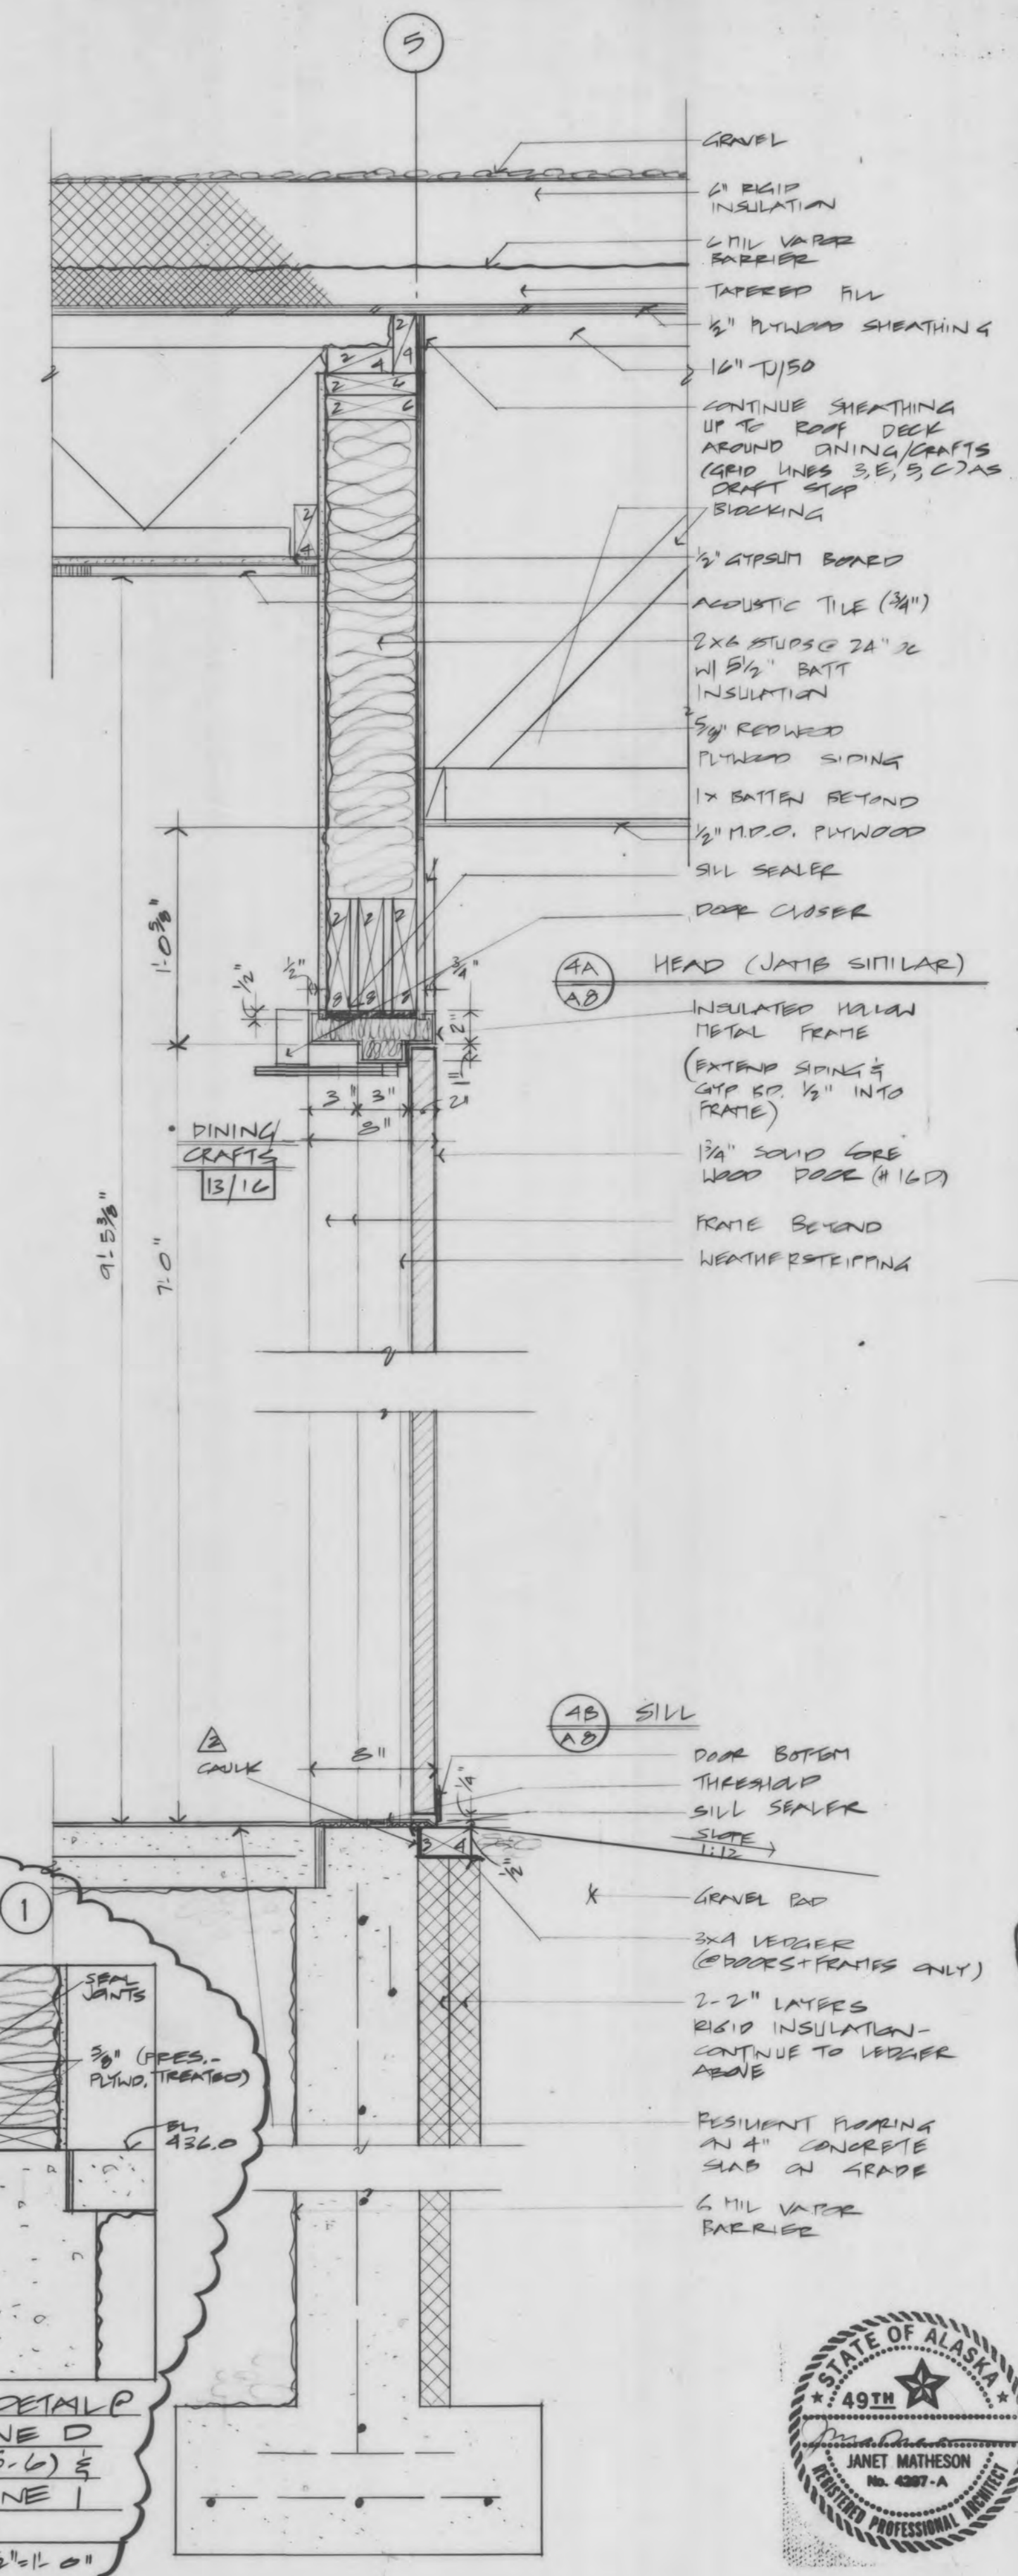

1 EXT. WALL SECTION @ DINING/CRAFTS  
SCALE: 1/2" = 1'-0"

2 EXT. WALL SECTION @ BERM  
SCALE: 1/2" = 1'-0"

3 EXT. WALL SECTION  
SCALE: 1/2" = 1'-0"

4 EXT. WALL SECTION @ DOOR TO EXTERIOR  
SCALE: 1/2" = 1'-0"