



JANET MATHESON ARCHITECT

P.O. BOX 81038  
FAIRBANKS,  
ALASKA 99708  
(907) 452-4640



CITY OF FAIRBANKS  
SENIOR CITIZENS RECREATION  
& NUTRITION CENTER

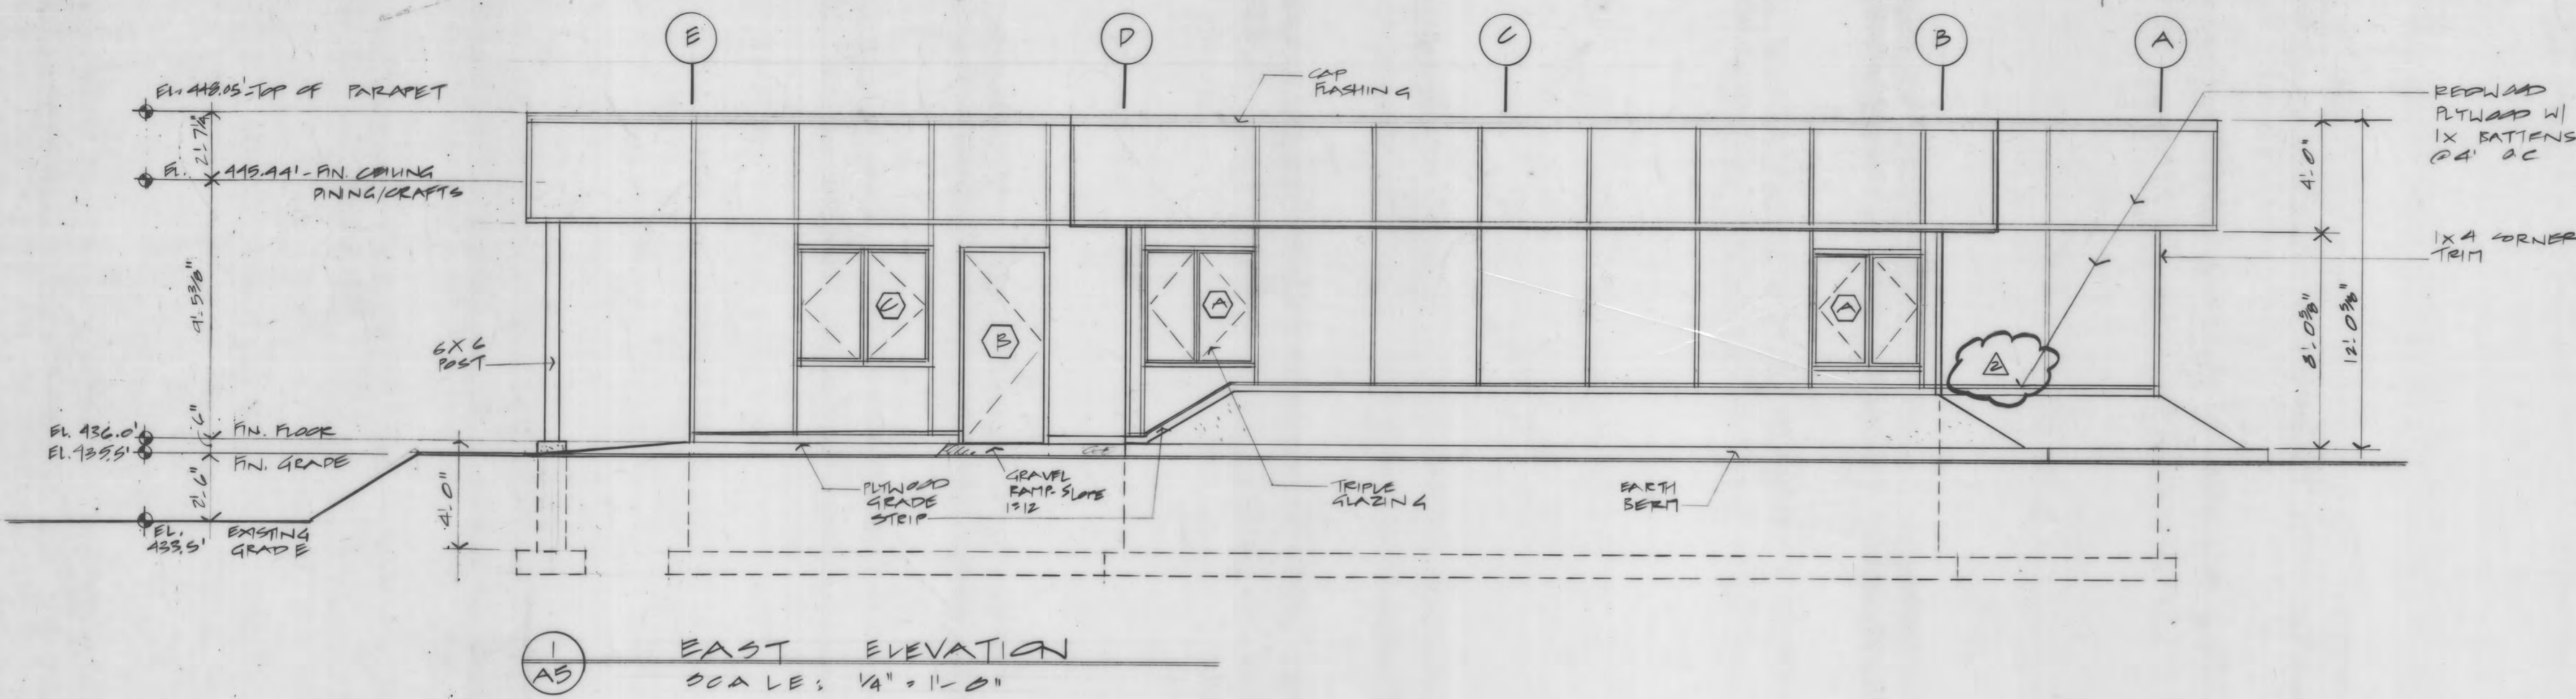


1 EAST ELEVATION  
SCALE: 1/4" = 1'-0"

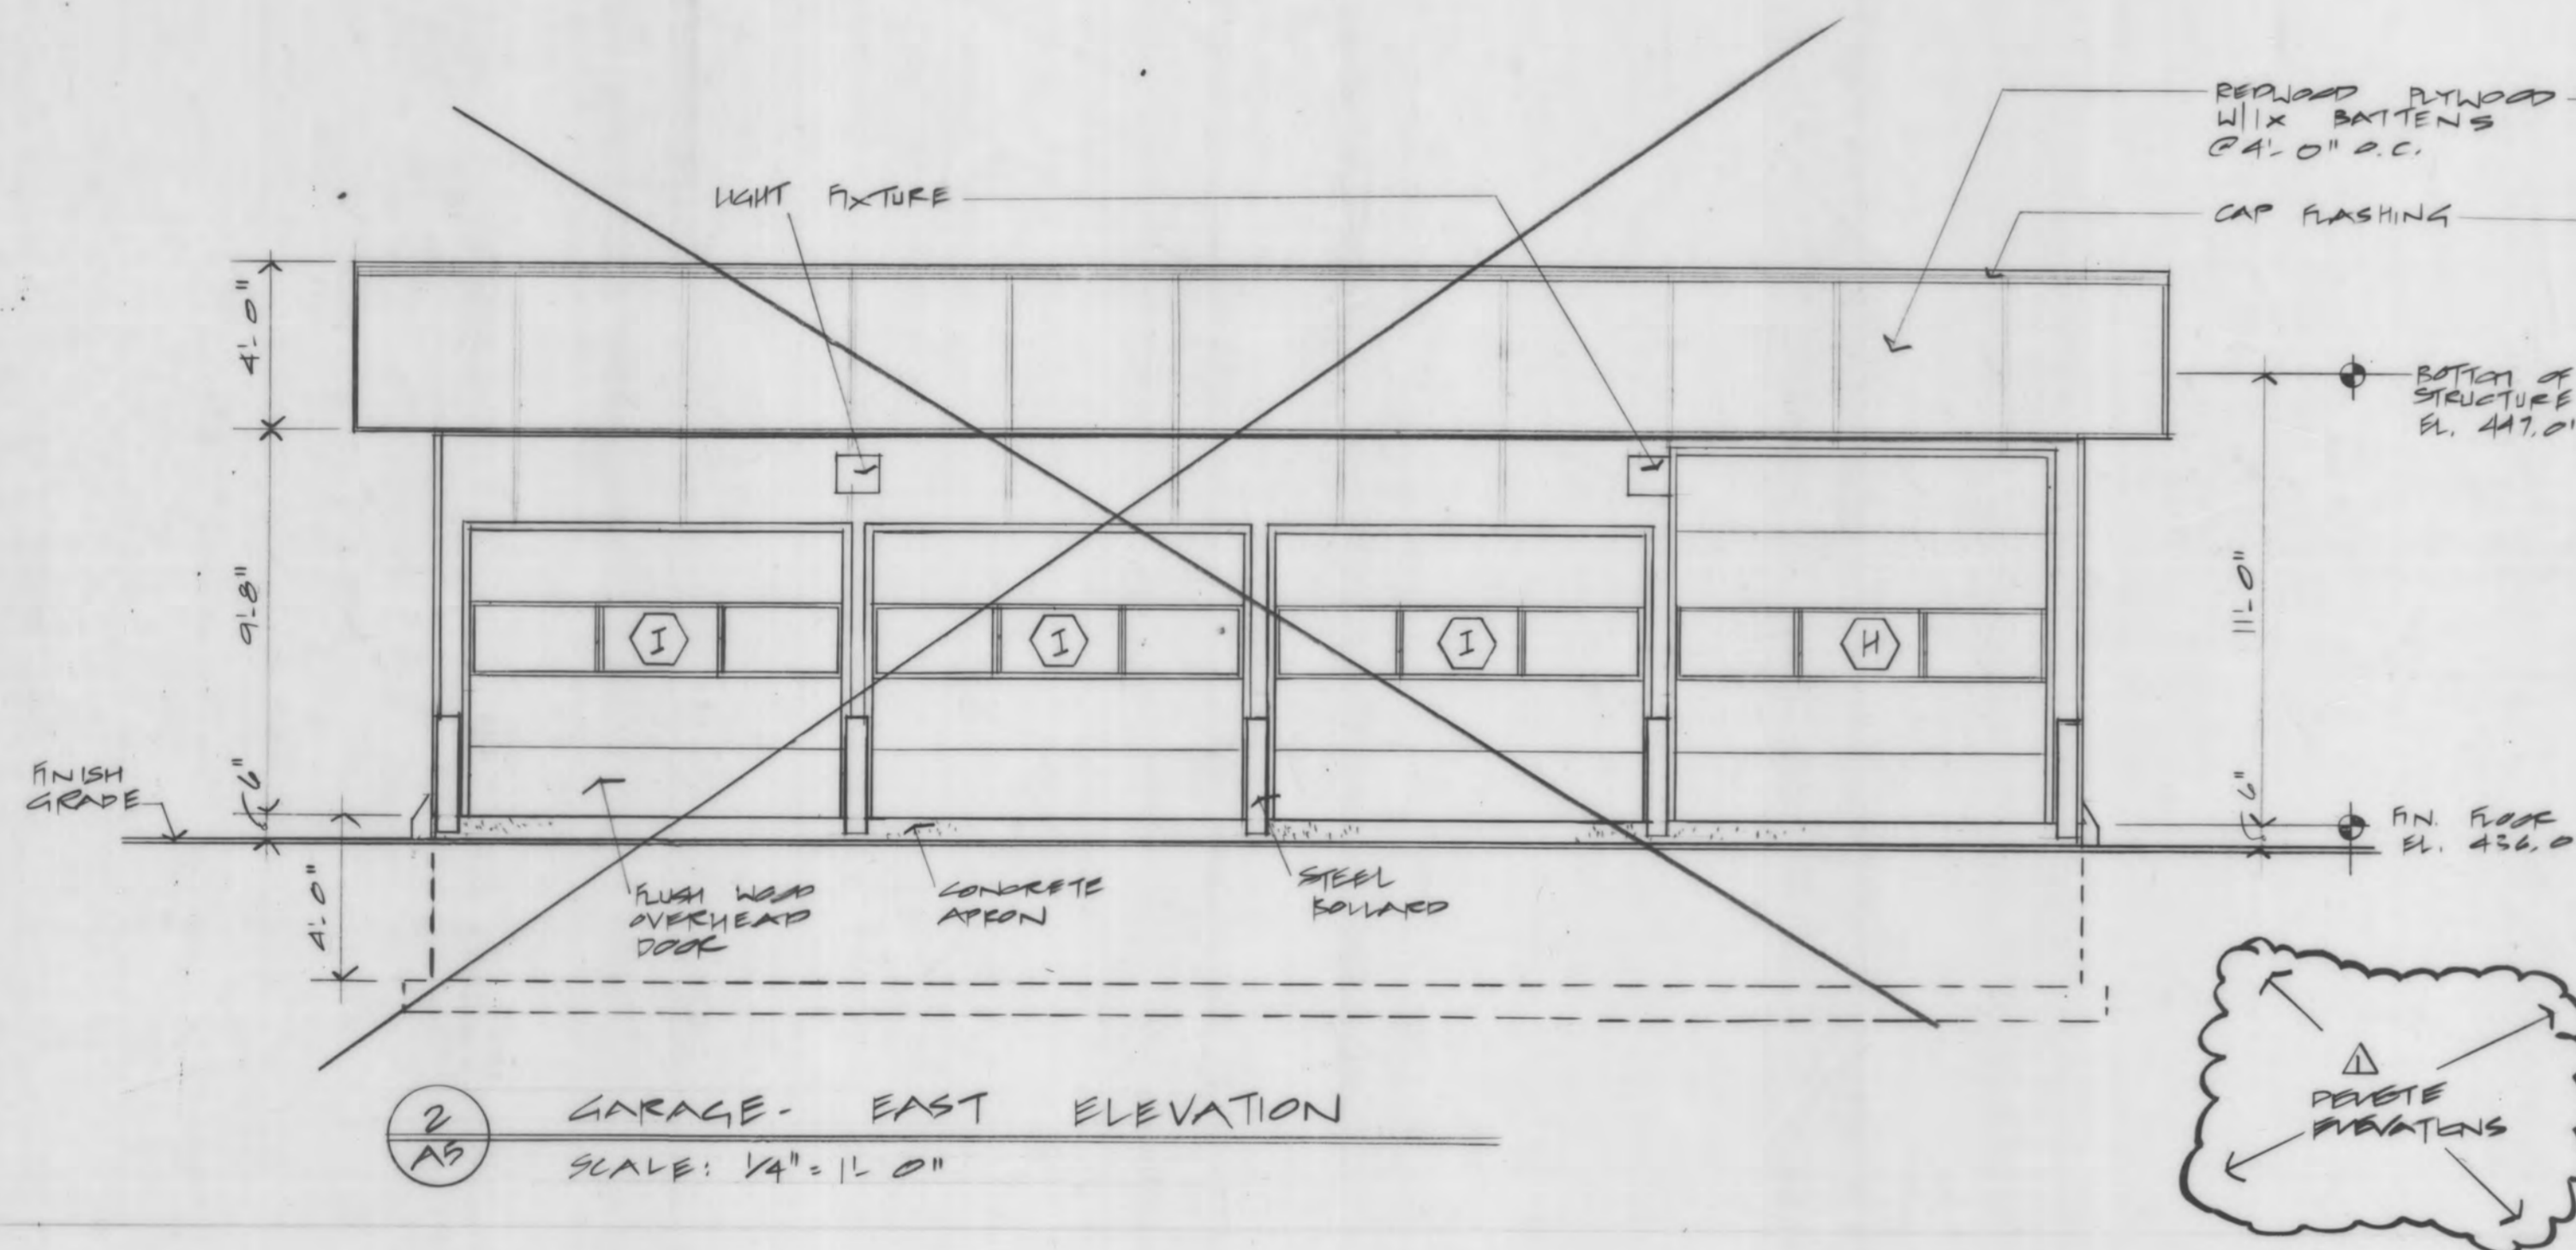


2 GARAGE - EAST ELEVATION  
SCALE: 1/4" = 1'-0"

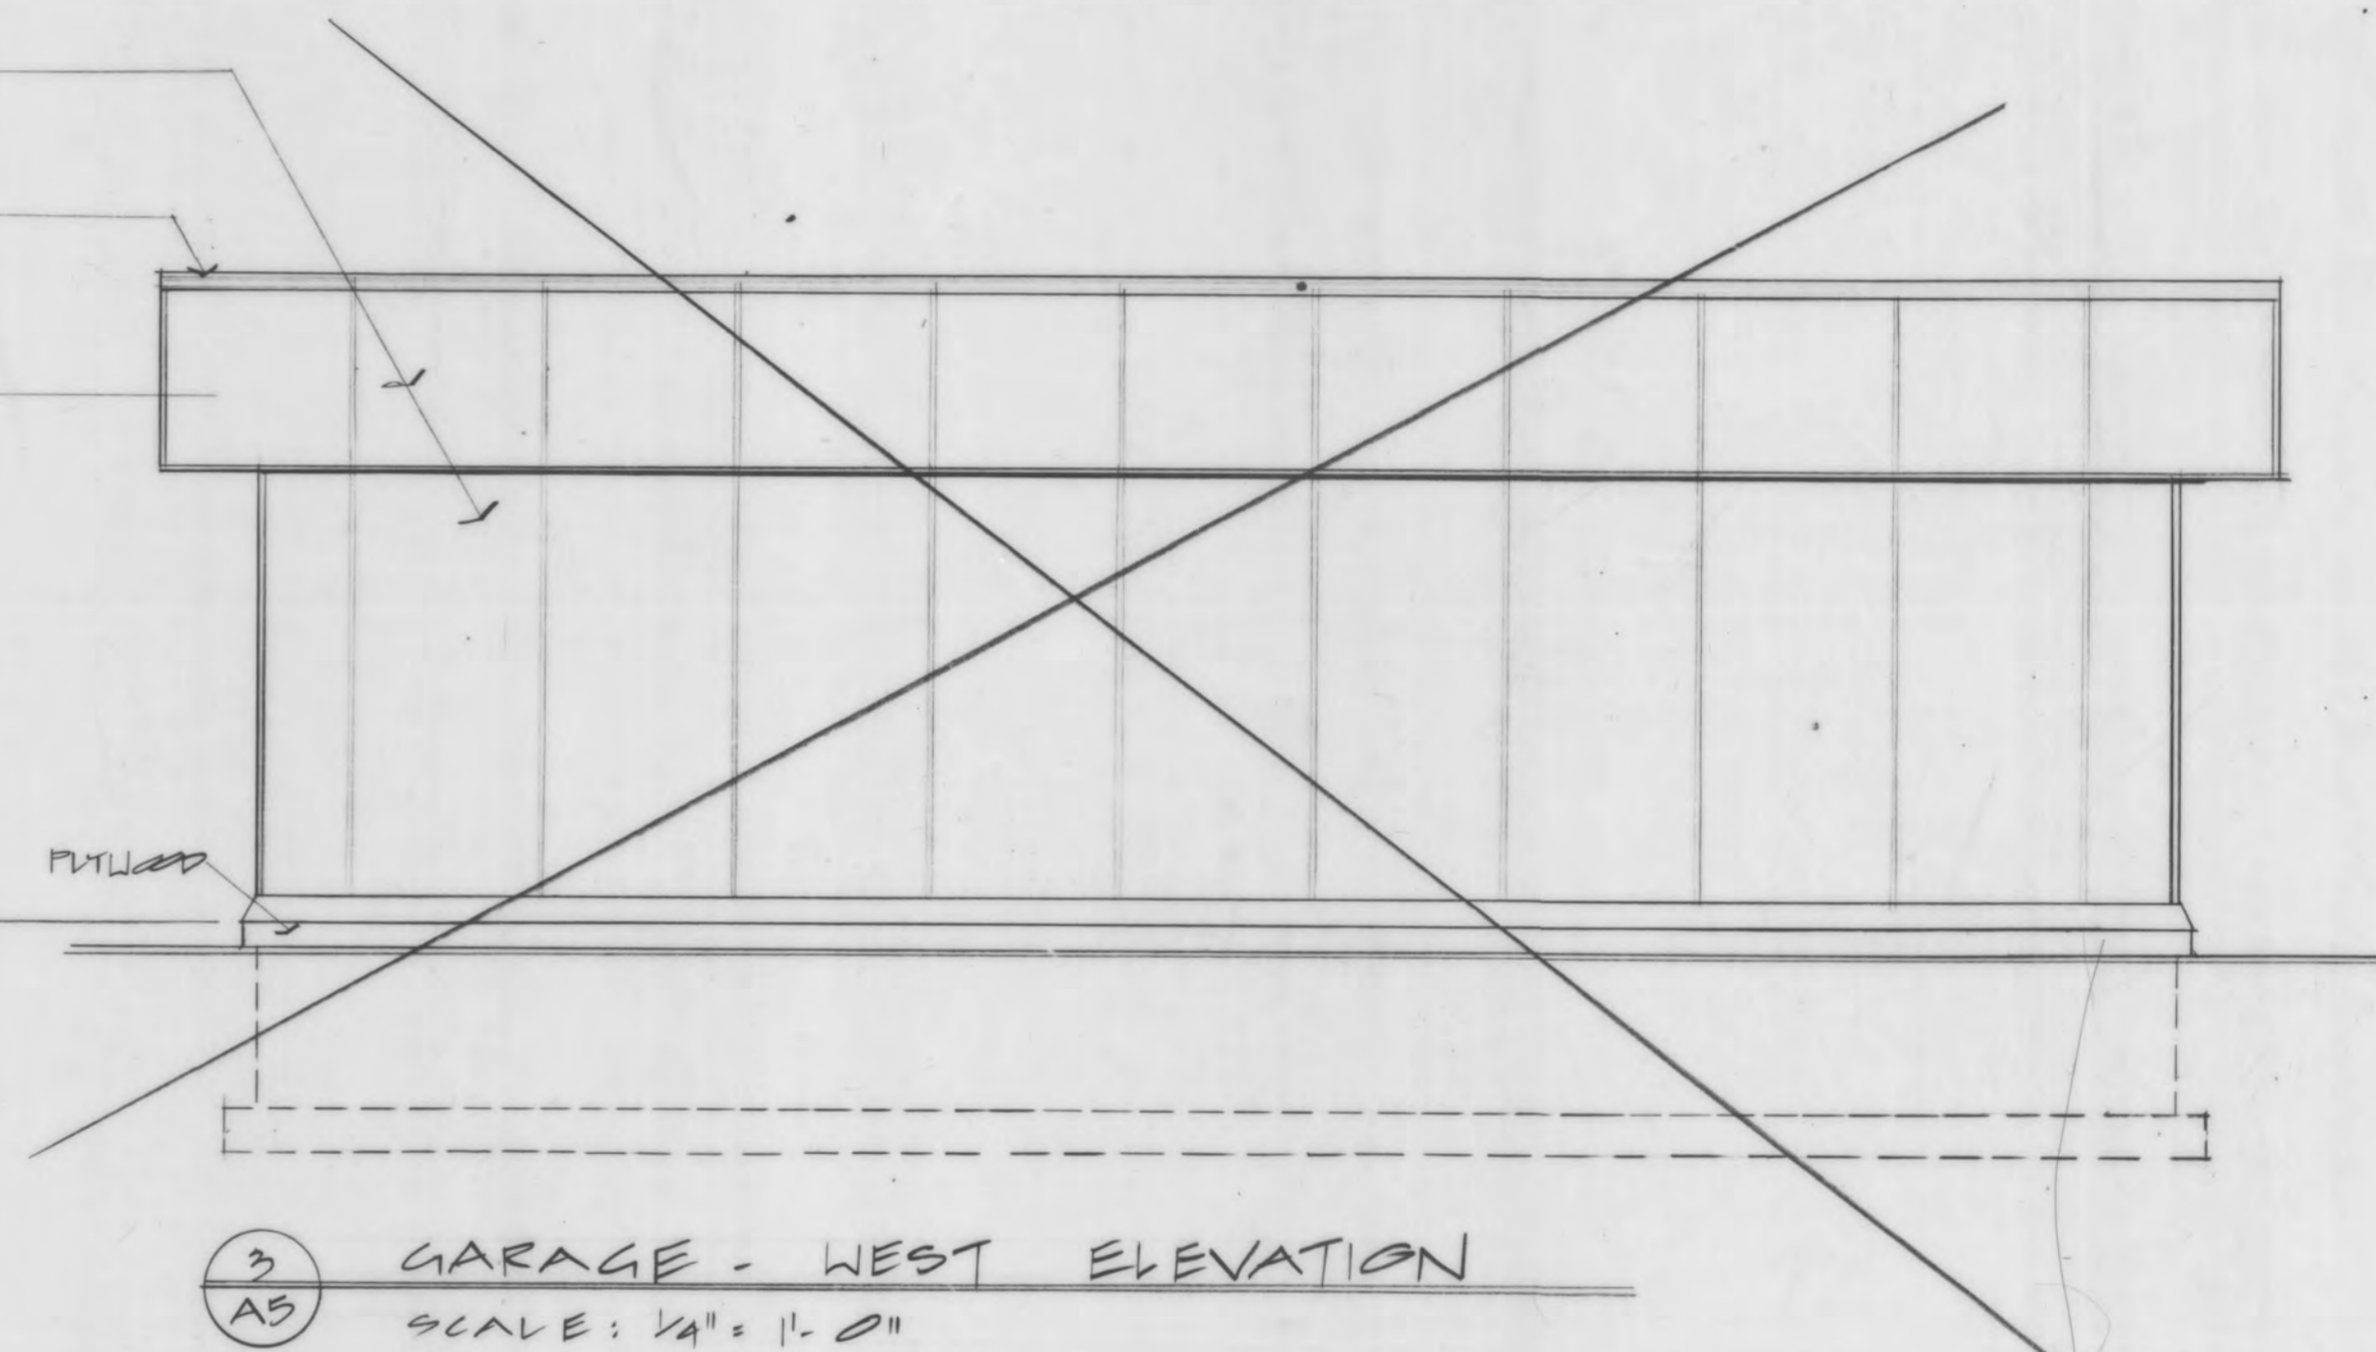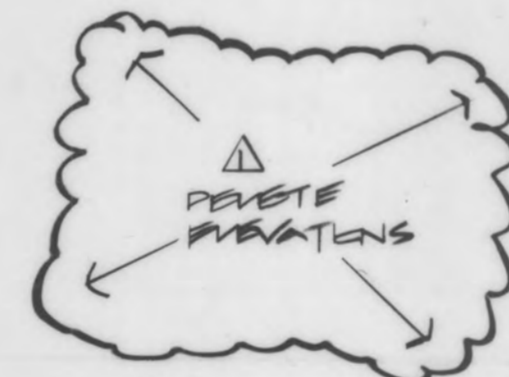

3 GARAGE - WEST ELEVATION  
SCALE: 1/4" = 1'-0"

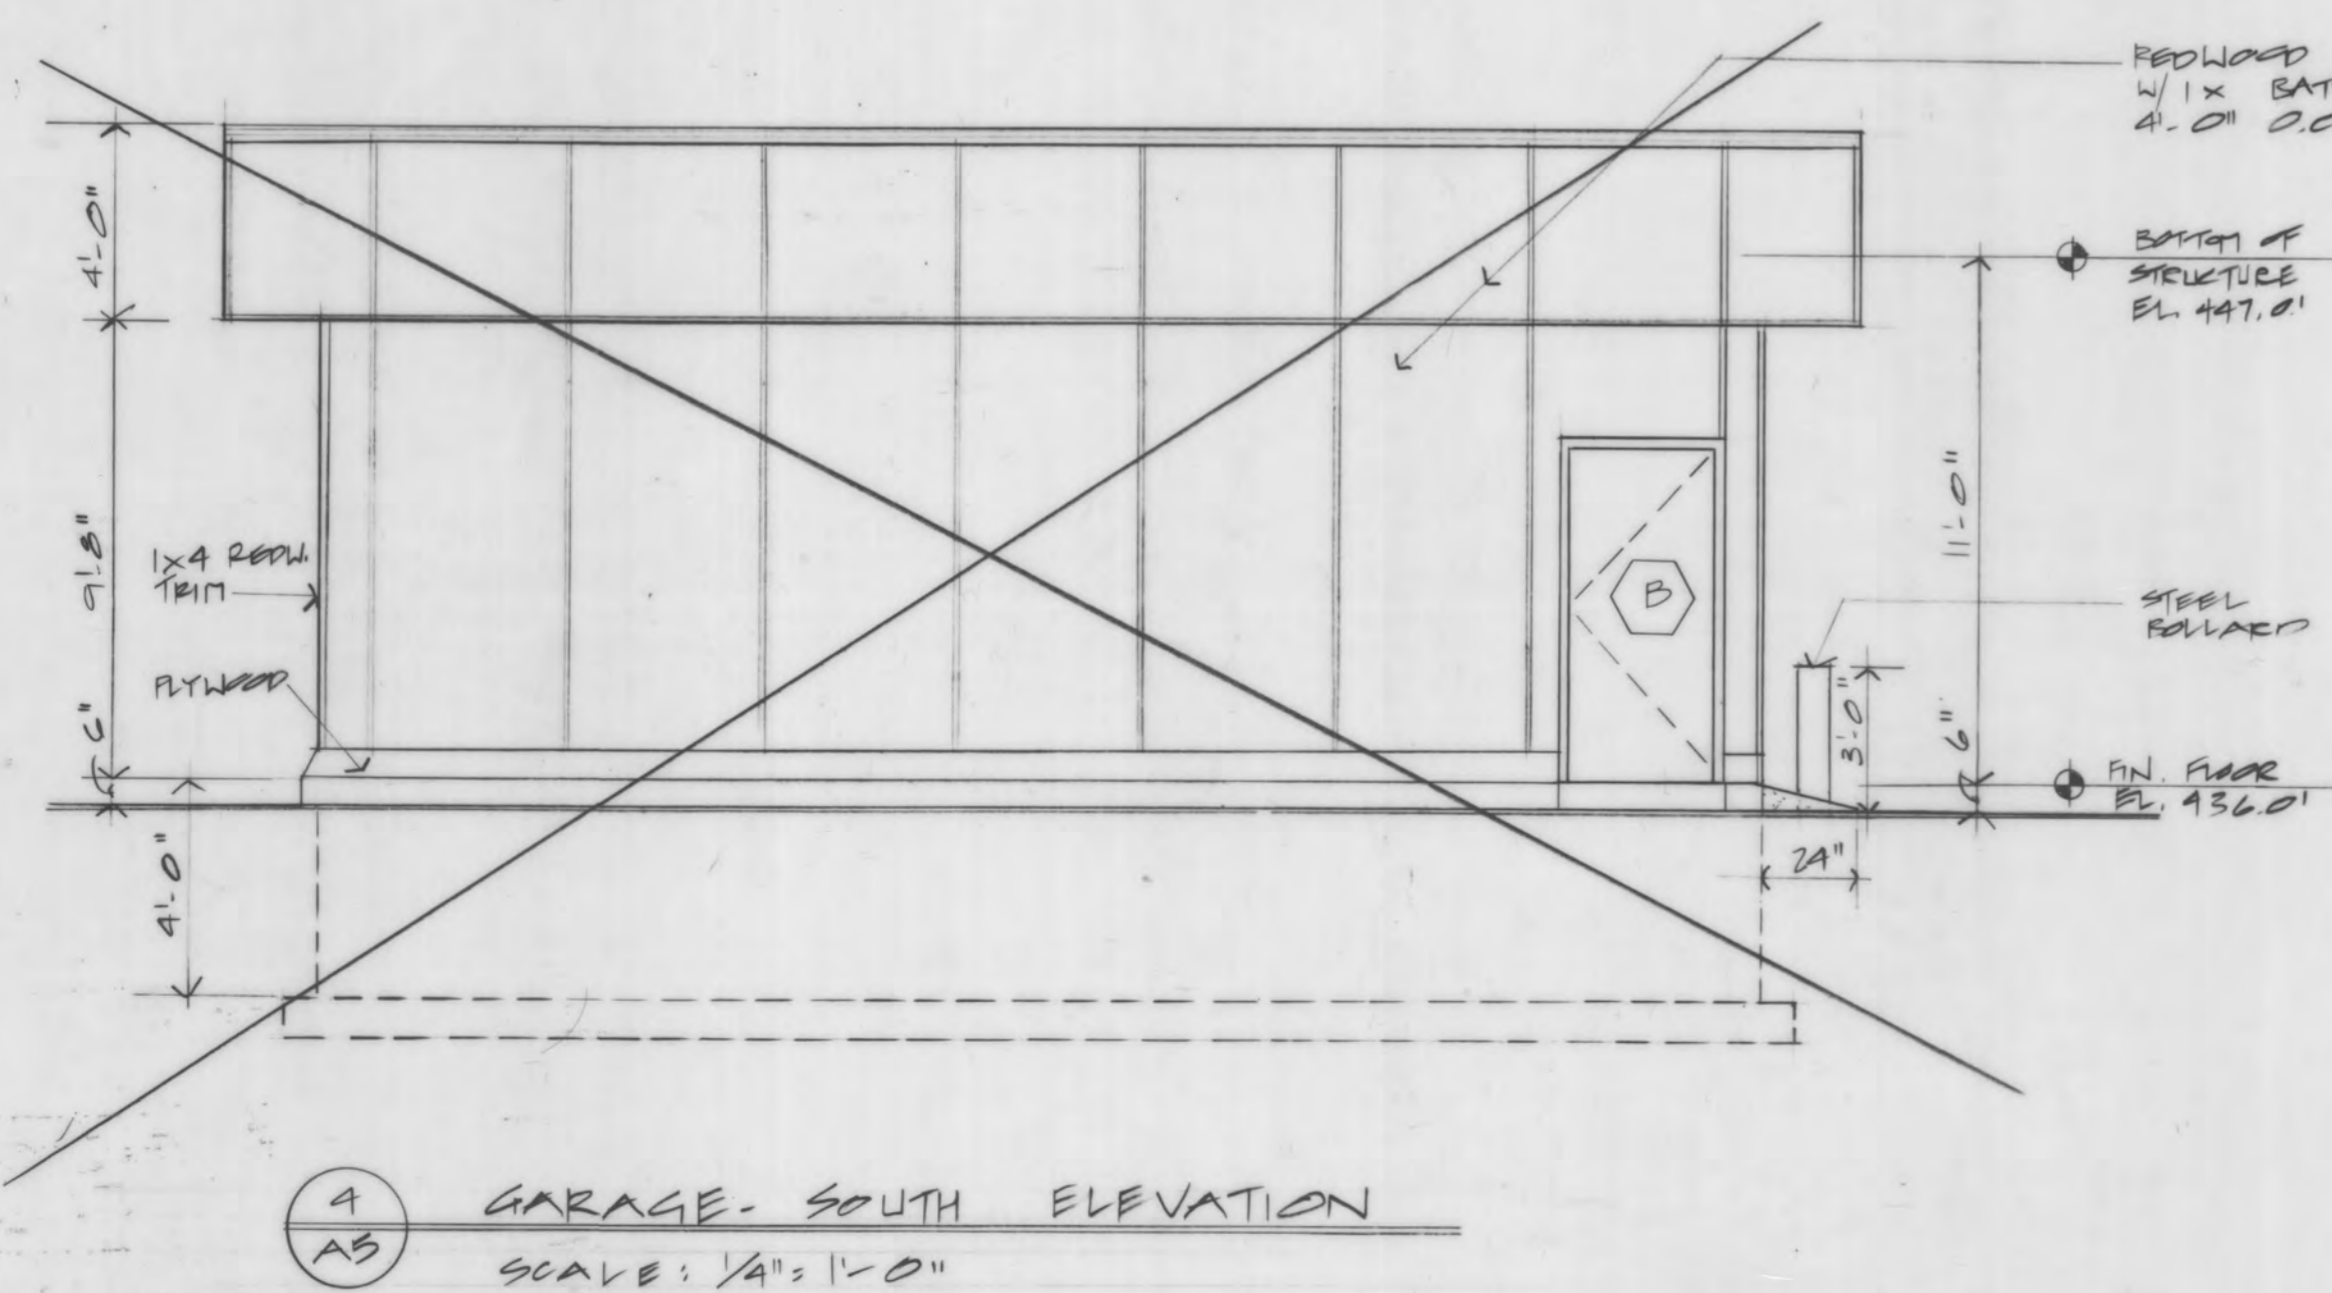

4 GARAGE - SOUTH ELEVATION  
SCALE: 1/4" = 1'-0"

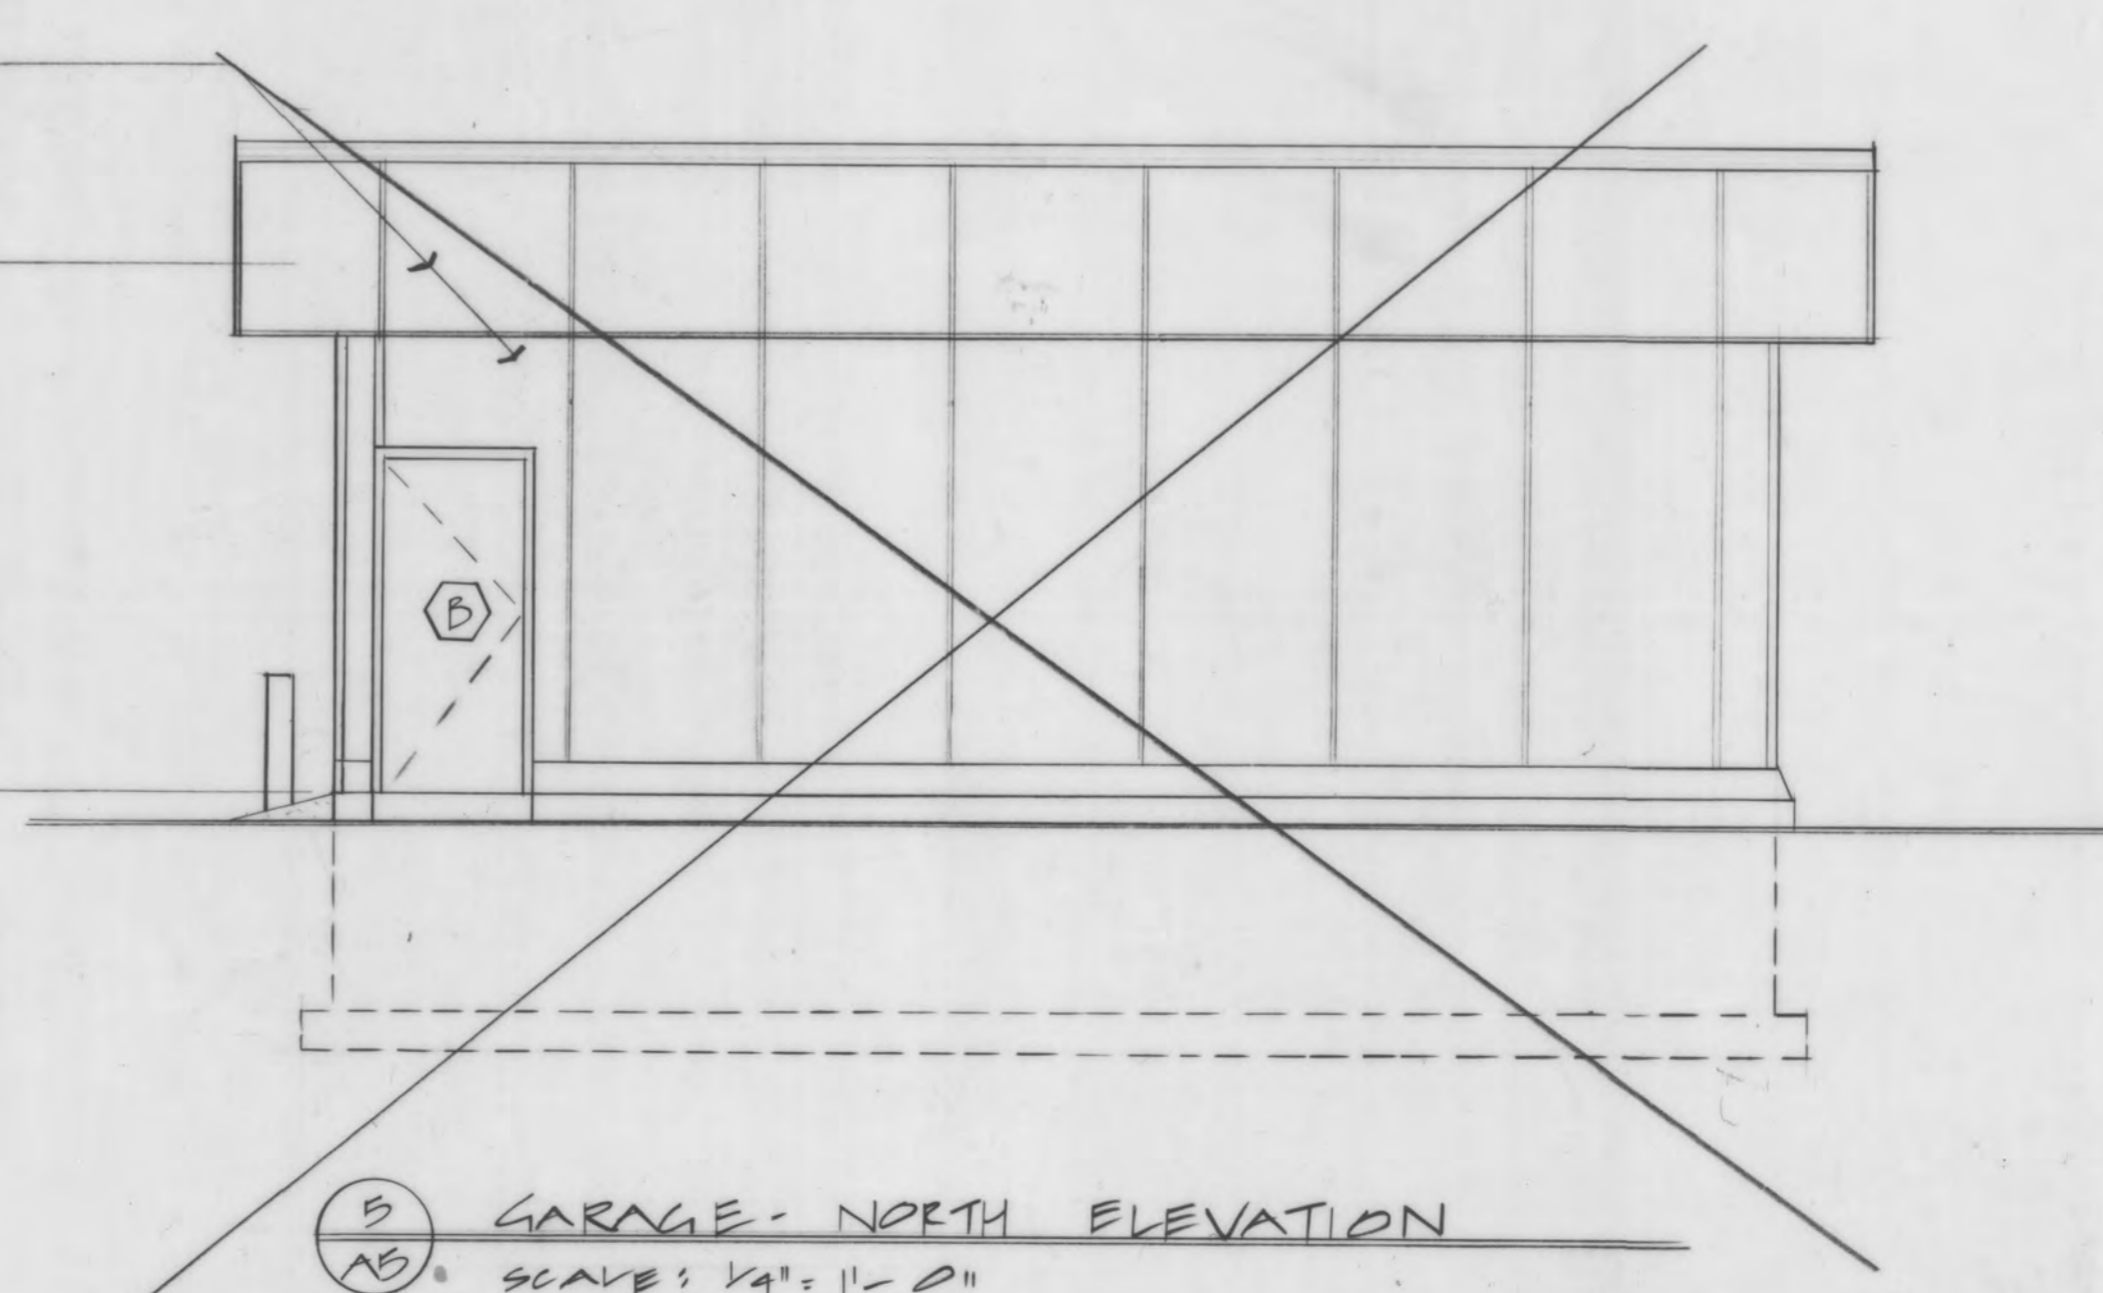

5 GARAGE - NORTH ELEVATION  
SCALE: 1/4" = 1'-0"

CONSTRUCTION CHANGES  
GARAGE NOT AWARDED


EXTERIOR  
ELEVATIONS  
REBID

SHT #

A5

DWN J1 CKD J1

DATE 2-28-83 PROJ # 791  
CG.0.175

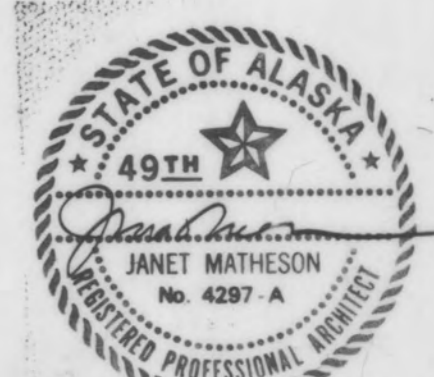

MICROFILMED  
DATE: 12/83  
MICROFILM NUMBER: