

**JANET MATHESON ARCHITECT**

P.O. BOX 81038  
FAIRBANKS,  
ALASKA 99708  
(907) 452-4640

**CITY OF FAIRBANKS  
SENIOR CITIZENS RECREATION  
& NUTRITION CENTER**

CHANGES  
CONSTRUCTION

EXTERIOR  
ELEVATIONS  
RESID

SHT #

**A4**


DWN J11 CKD J11

DATE 2-27-83 PROJ # 791


CG.0.176




MICROFILMED  
DATE: 12/83  
MICROFILM NUMBER:

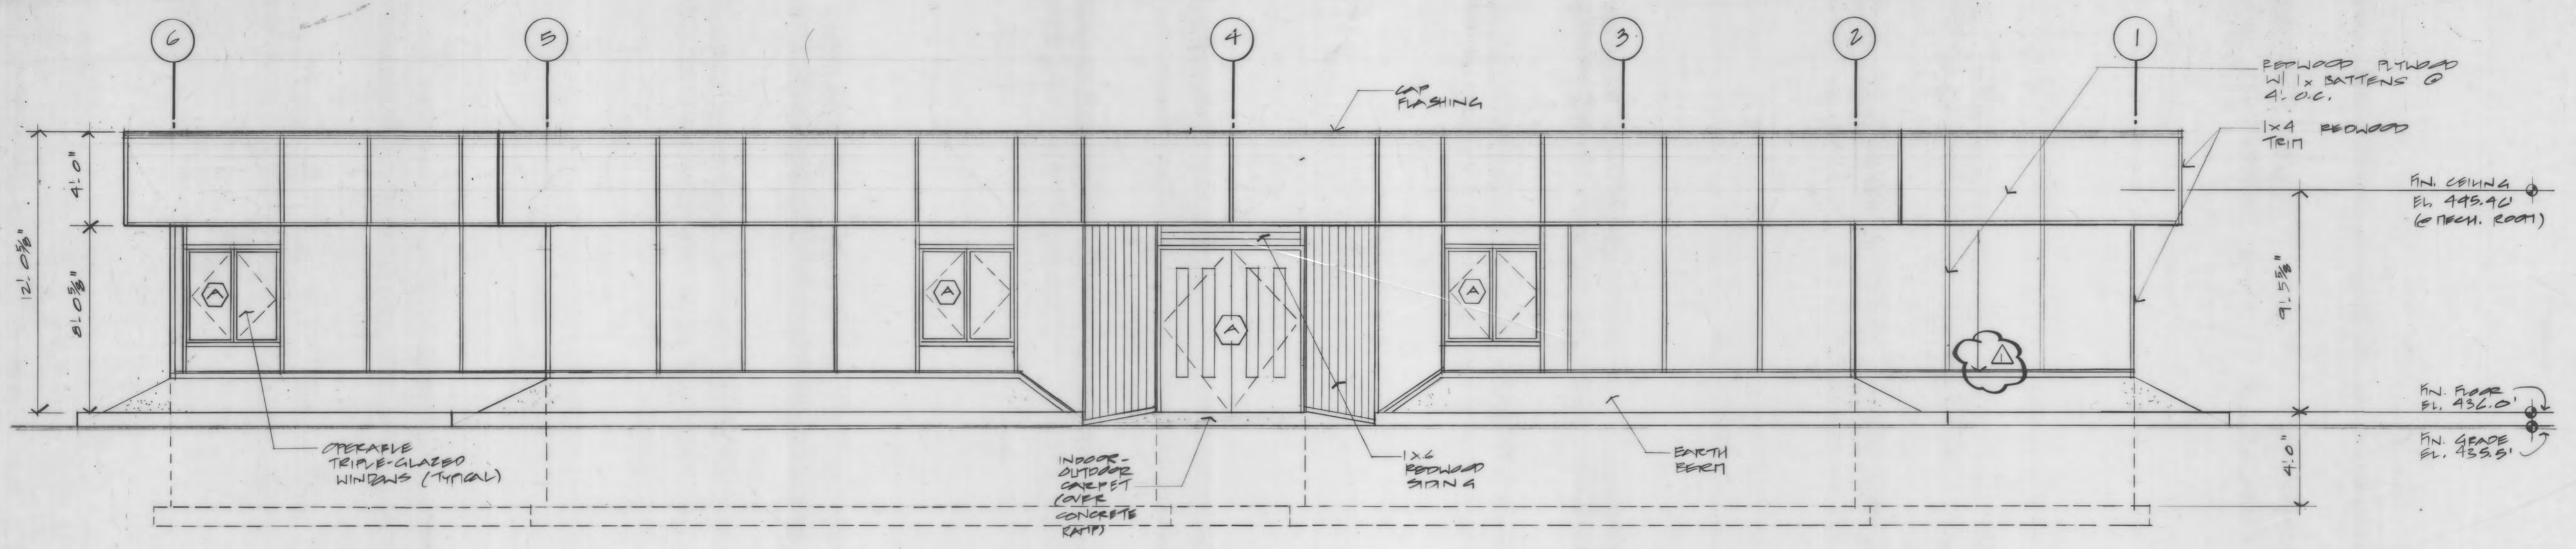

**1 NORTH ELEVATION**  
SCALE: 1/4" = 1'-0"

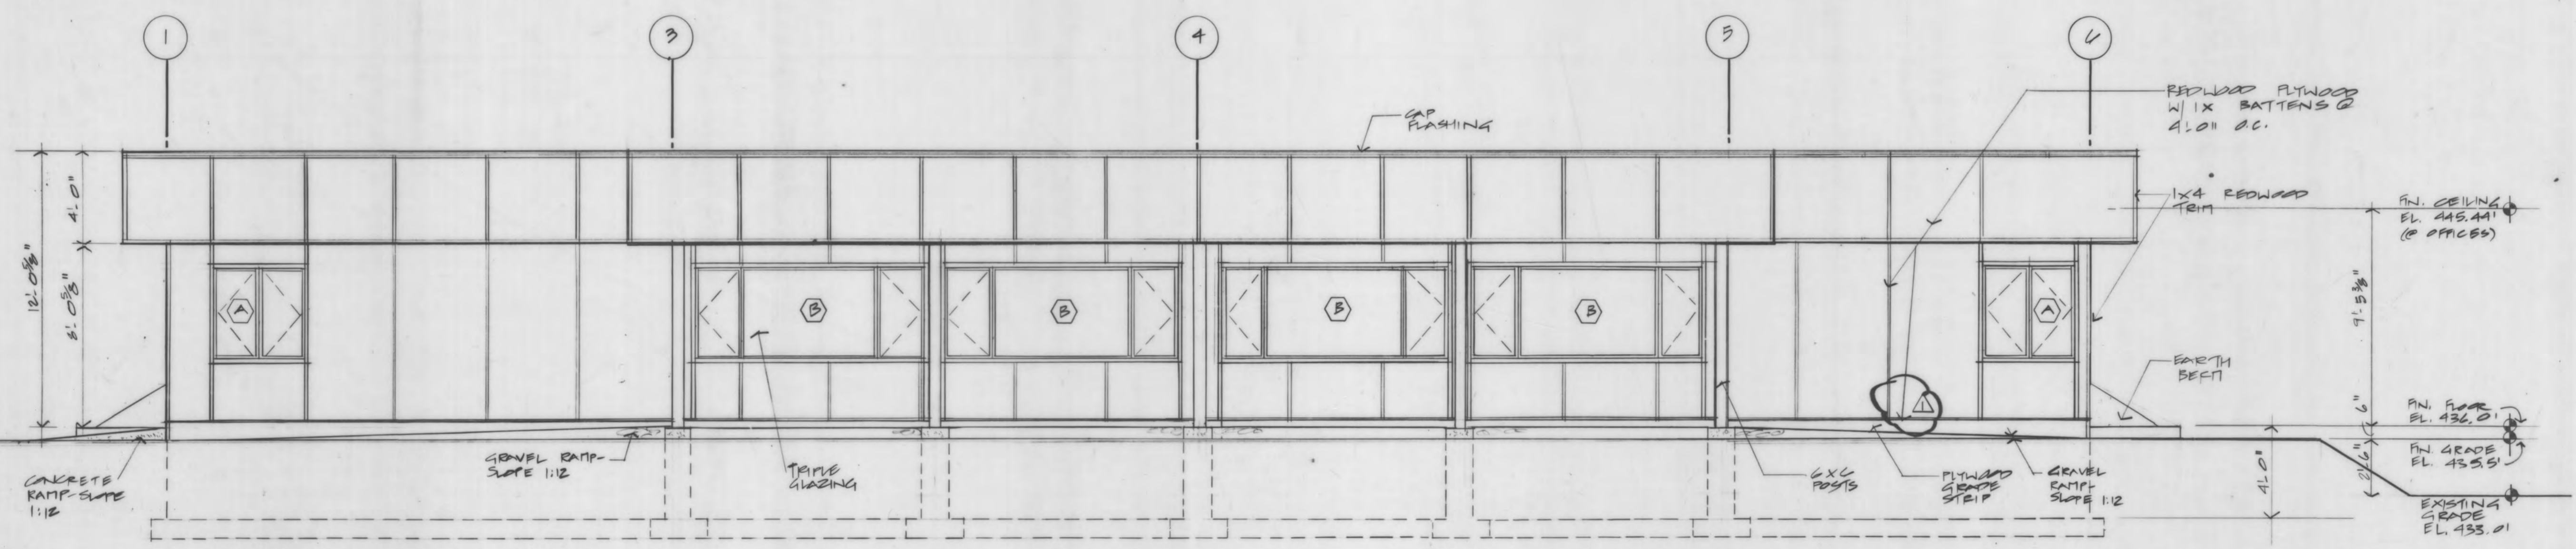

**2 SOUTH ELEVATION**  
SCALE: 1/4" = 1'-0"

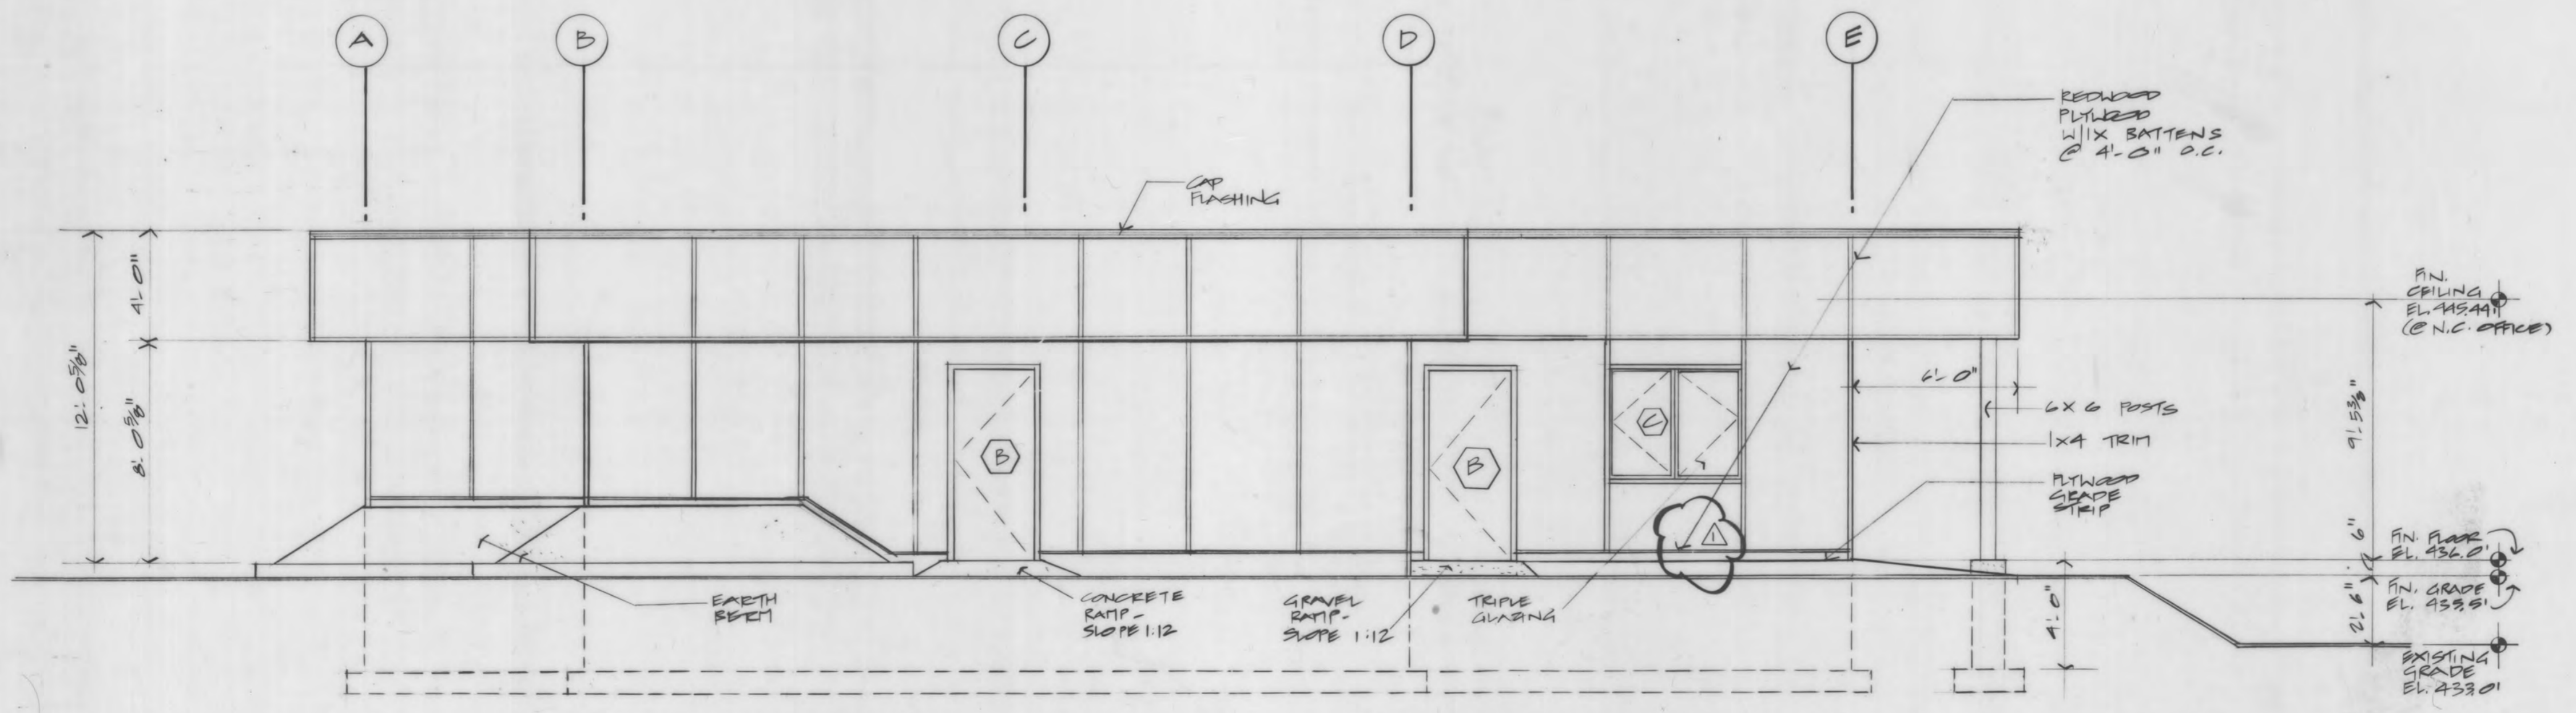

**3 WEST ELEVATION**  
SCALE: 1/4" = 1'-0"