


CITY OF FAIRBANKS
SENIOR CITIZENS RECREATION
& NUTRITION CENTER



1 GARAGE FLOOR PLAN
SCALE: 1/4" = 1'-0"
NOTE: ALL DIMENSIONS SHOWN
ARE FROM FACE OF STUD
UNLESS OTHERWISE NOTED.

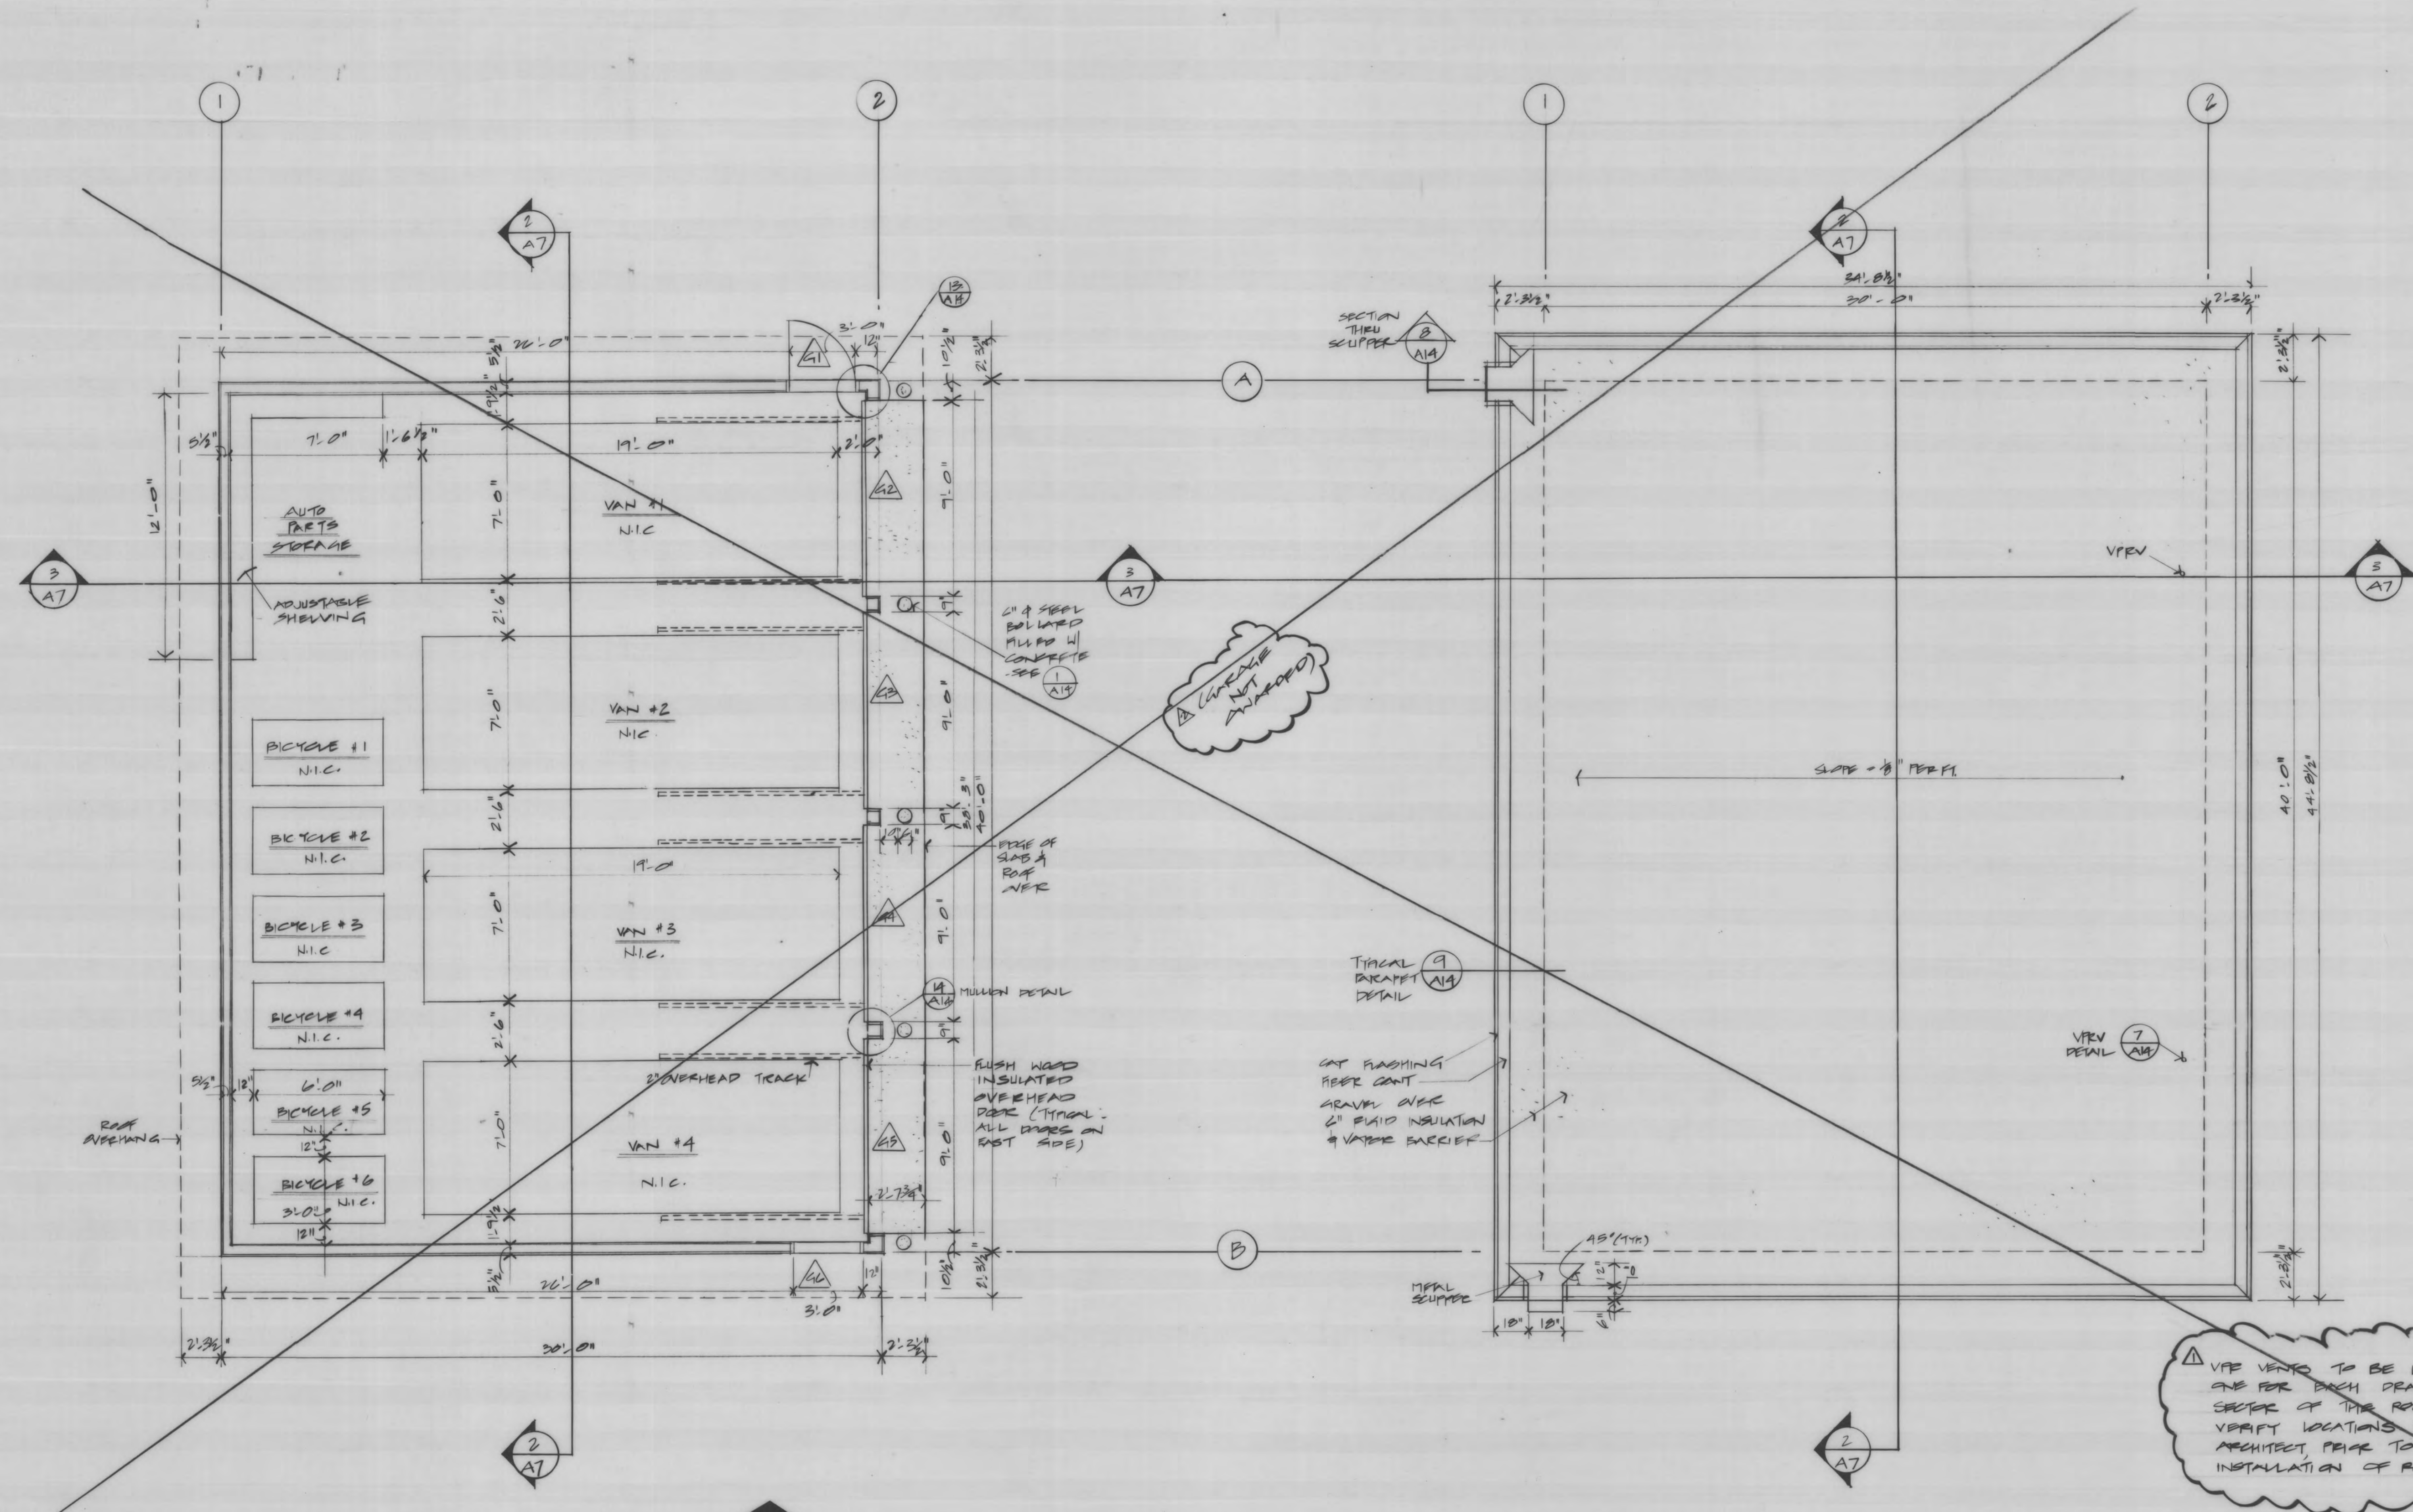

2 GARAGE ROOF PLAN
SCALE: 1/4" = 1'-0"

VFE VENTS TO BE LOCATED
ONE FOR EACH DRAINAGE
SECTION OF THE ROOF.
VERIFY LOCATIONS WITH
ARCHITECT PRIOR TO
INSTALLATION OF ROOF.

△ SHEET A2 N/A
△ APPENDIX NO. 1

GARAGE
FLOOR PLAN
&
ROOF PLAN
RESID

SHT #

A 2



MICROFILMED
DATE: 12/83
MICROFILM NUMBER:

OWN J17 CKD
DATE 2-23-80 PROJ = 791
C.G.O. 178