


CITY OF FAIRBANKS  
SENIOR CITIZENS RECREATION  
& NUTRITION CENTER

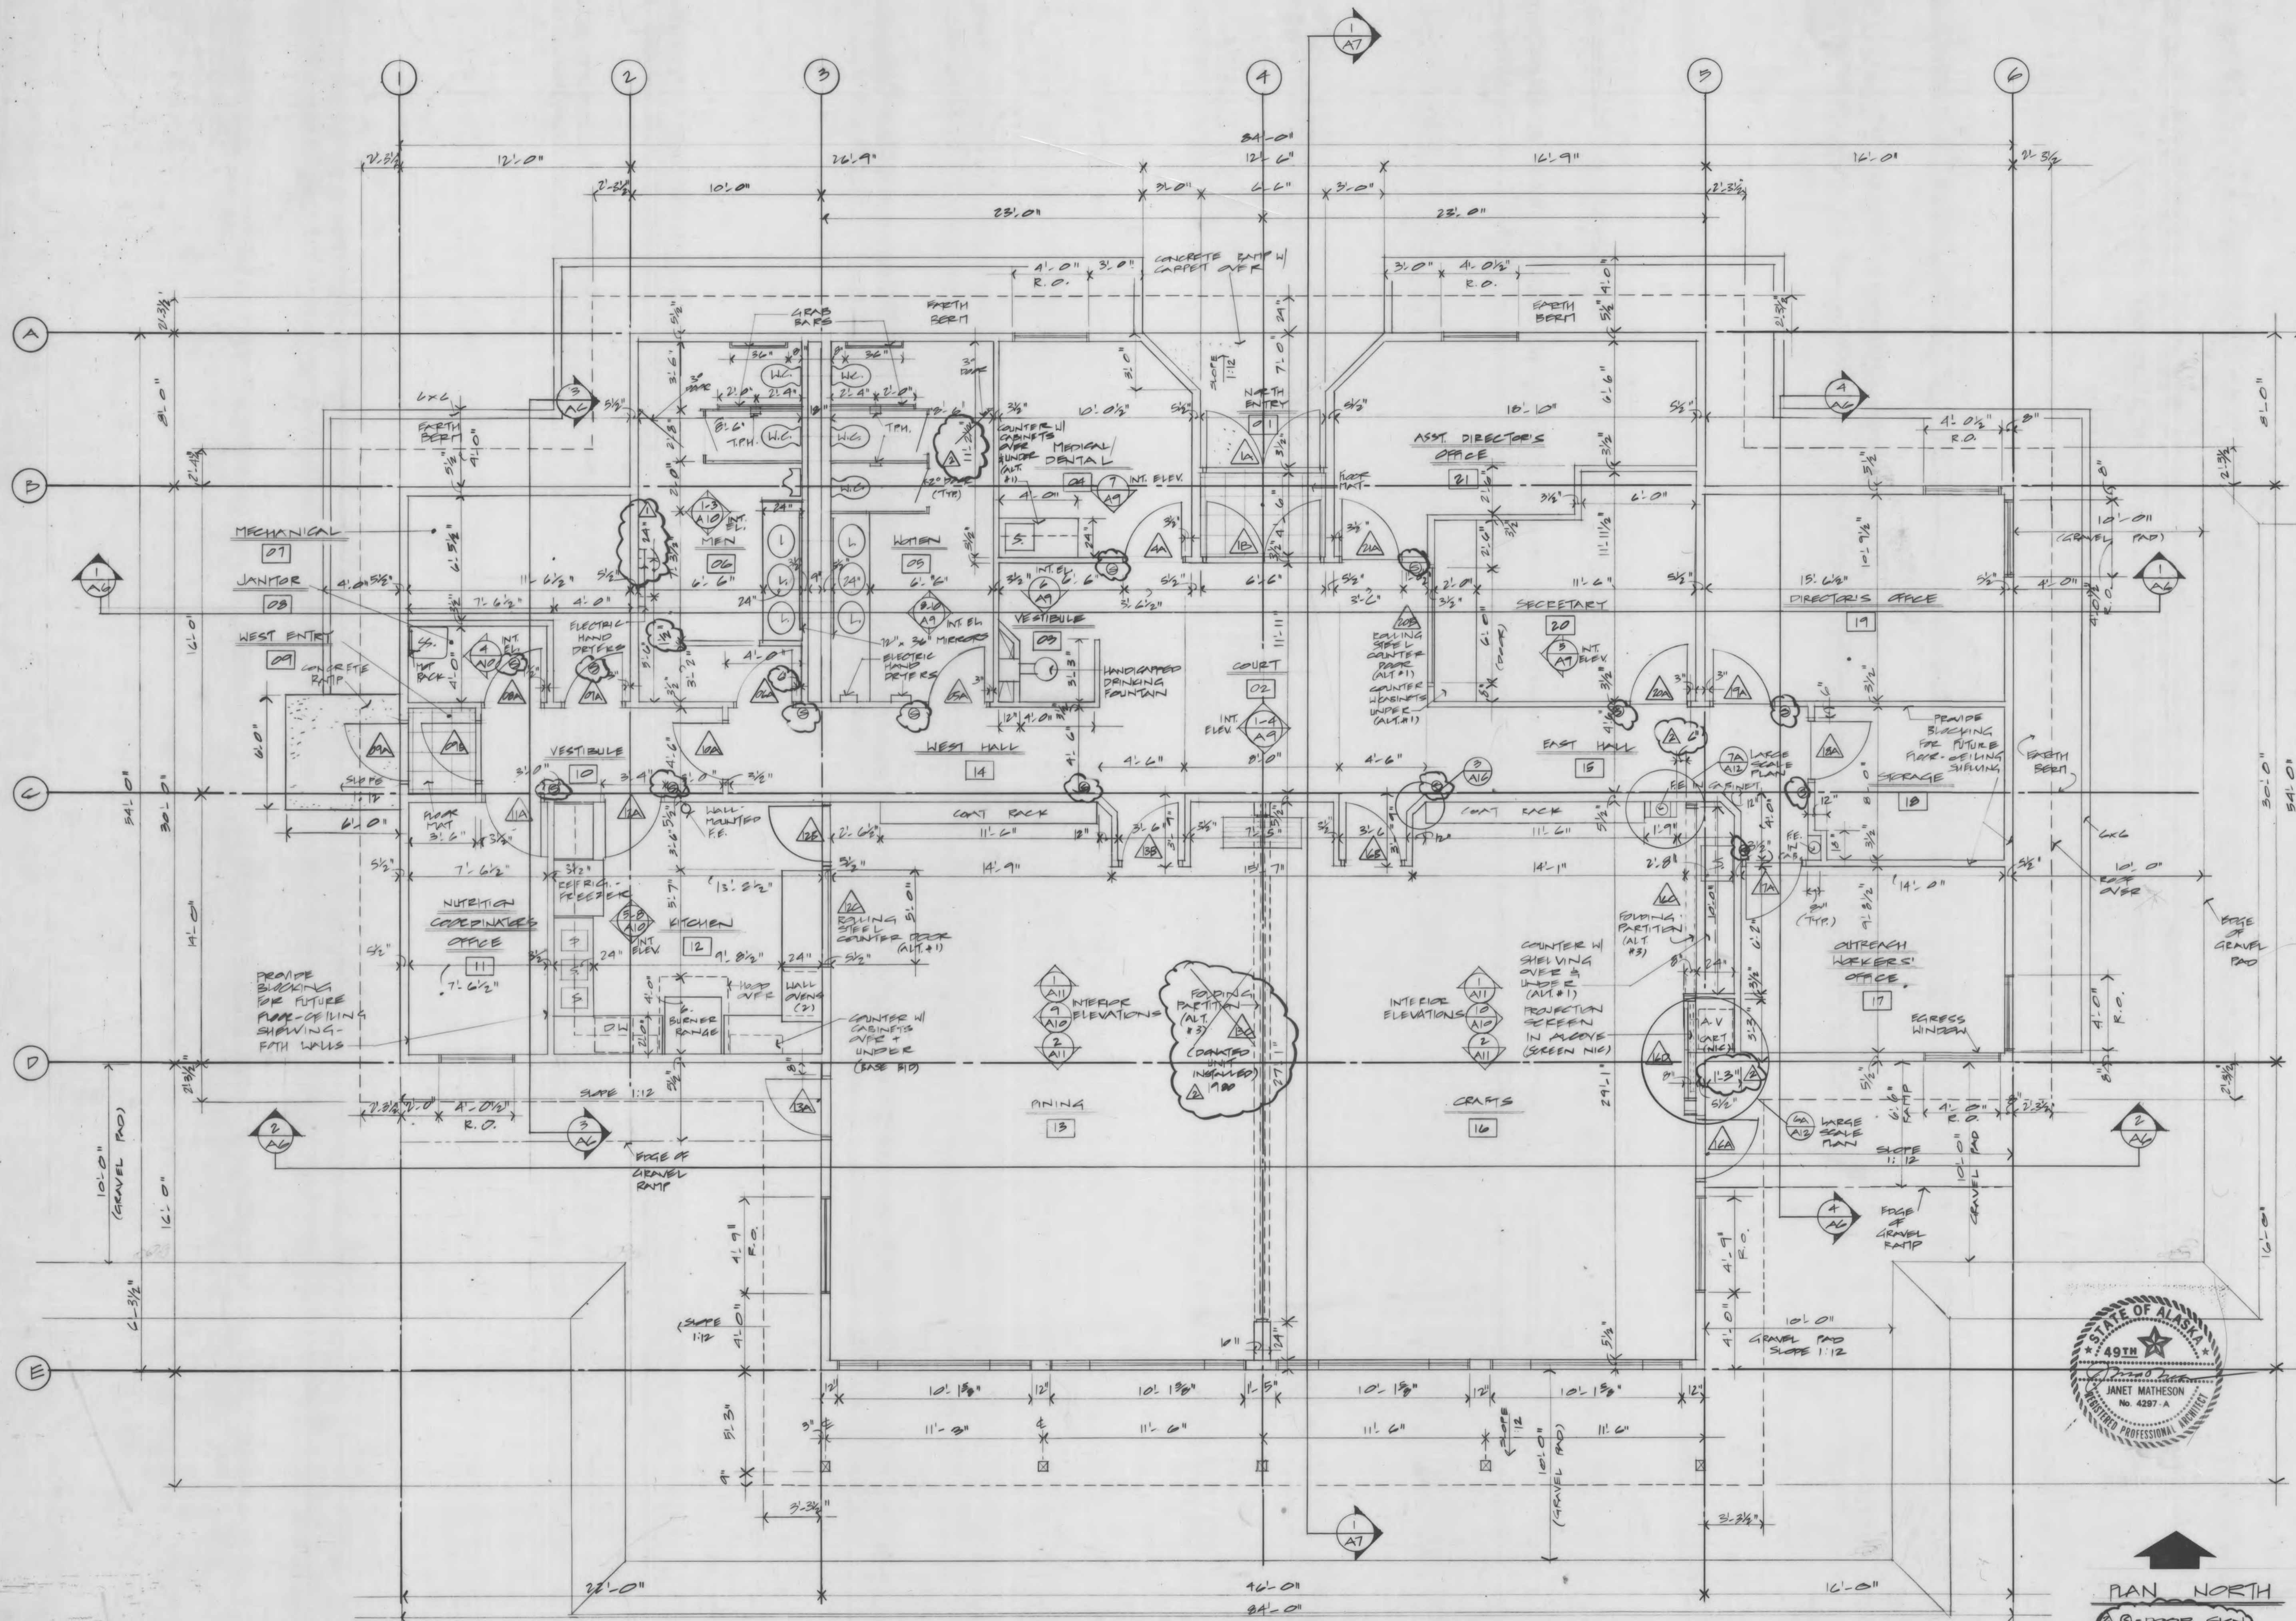

CONSTRUCTION CHANGES  
APPENDIX NO. 1

FLOOR  
PLAN  
REBID

SHT #

AI

MICROFILMED  
DATE: 12/83  
MICROFILM NUMBER:

DWN JH CKD JH

DATE: 2-22-83 PROJ: #71

CG. 0.179