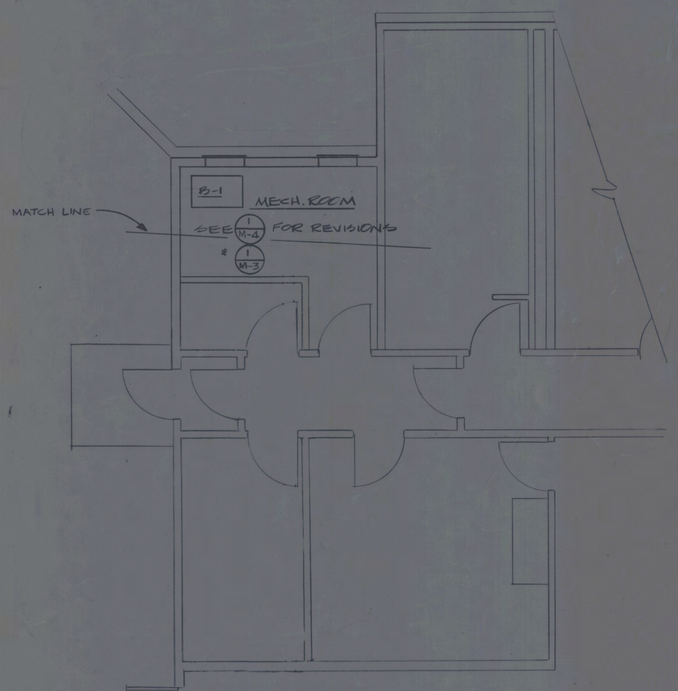

NORTH — 1/M-2 PLUMBING & HEATING FLOOR PLAN
SCALE: 1/4"=1'-0"

C. LEMARCHAND KENNEDY AND ASSOCIATES
environdesign
ARCHITECTURE, PLANNING, ENERGY MANAGEMENT
1327 KALAKAKET, FAIRBANKS, ALASKA 99701 (907) 479-3393

REVISIONS:

PROJECT NO.
DATE: 7/31/86
DRAWN: BW
CHECKED: MKC

CONTENTS:
PLUMBING & HEATING PLANS
SCALE: 1/4"=1'-0"

CITY OF FAIRBANKS
SENIOR CITIZENS RECREATION & NUTRITION CENTER ADDITION

DRAWING NO.
M-2
OF 4

STATE OF ALASKA
49TH
Michael A. Crawford
No. 4260 M E
REGISTERED PROFESSIONAL ENGINEER

SUNFAIR ENGINEERING
FAIRBANKS, ALASKA

ENG7945.TIF

F8-4-038