



C. LEMARCHAND KENNEDY AND ASSOCIATES:
environdesign
 ARCHITECTURE, PLANNING, ENERGY MANAGEMENT
 1327 KALAKAKET, FAIRBANKS, ALASKA 99701 (907) 479-3193



REVISIONS:

PROJECT NO.
8602
 DATE: 6-30-86
 DRAWN: JMB
 CHECKED:


CONTENTS:
 RM 108, 110
 INTERIOR
 ELEVATIONS
 SCALE: 1/4" = 1'-0"




DRAWING NO.

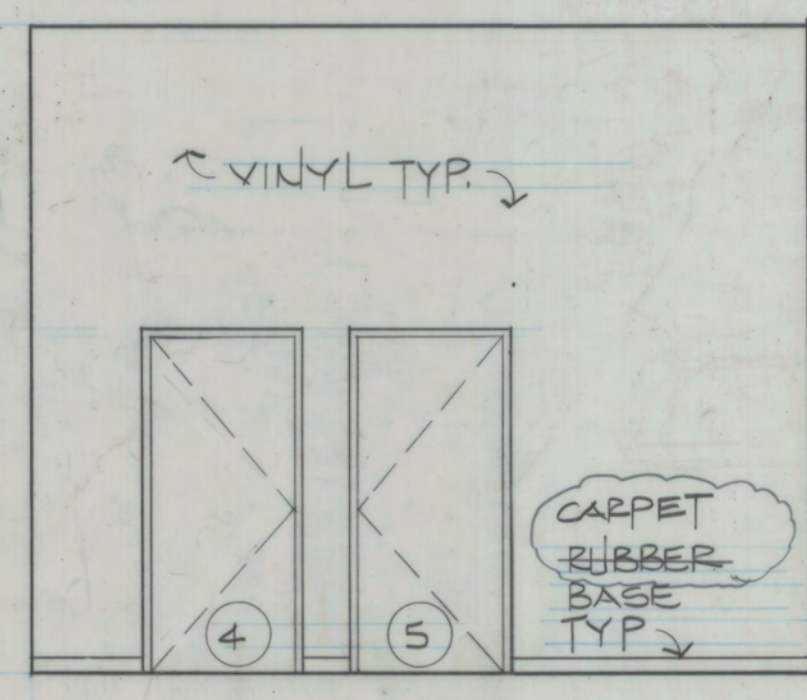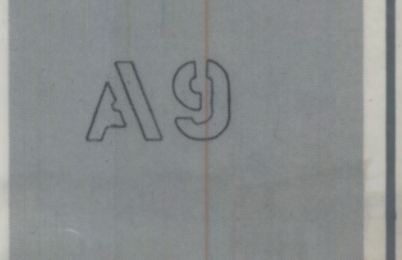


NORTH
RM 108

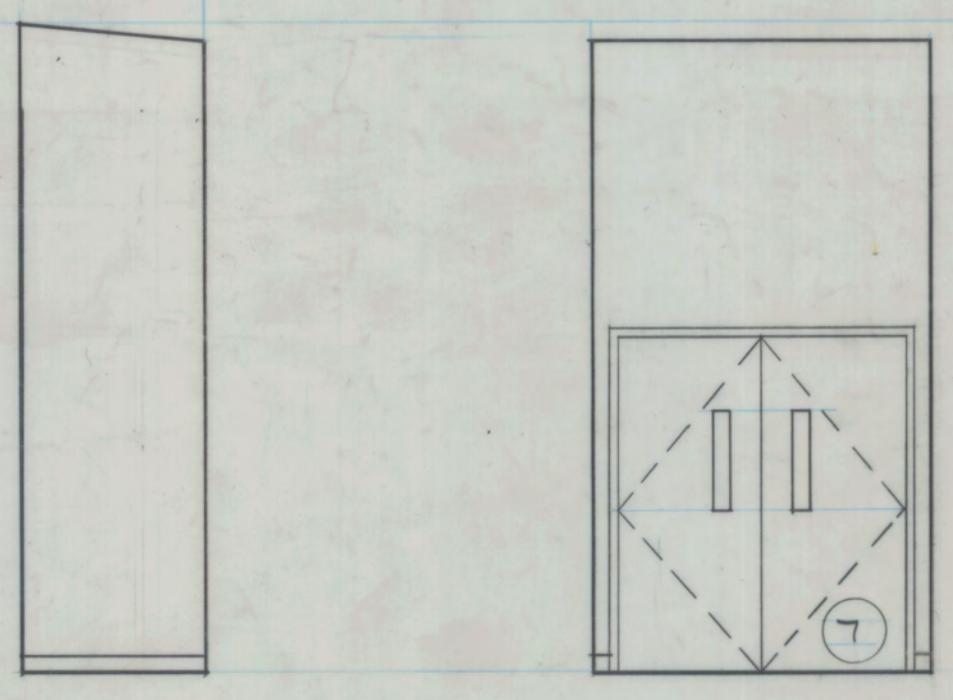


NORTHEAST NORTH

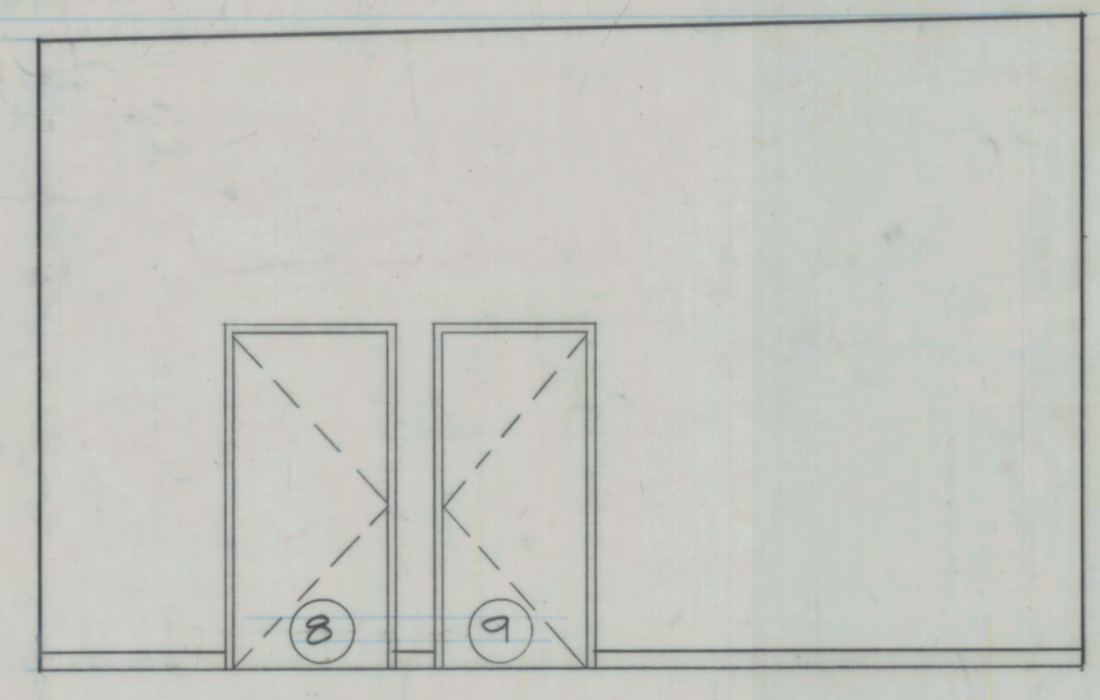


SOUTHEAST

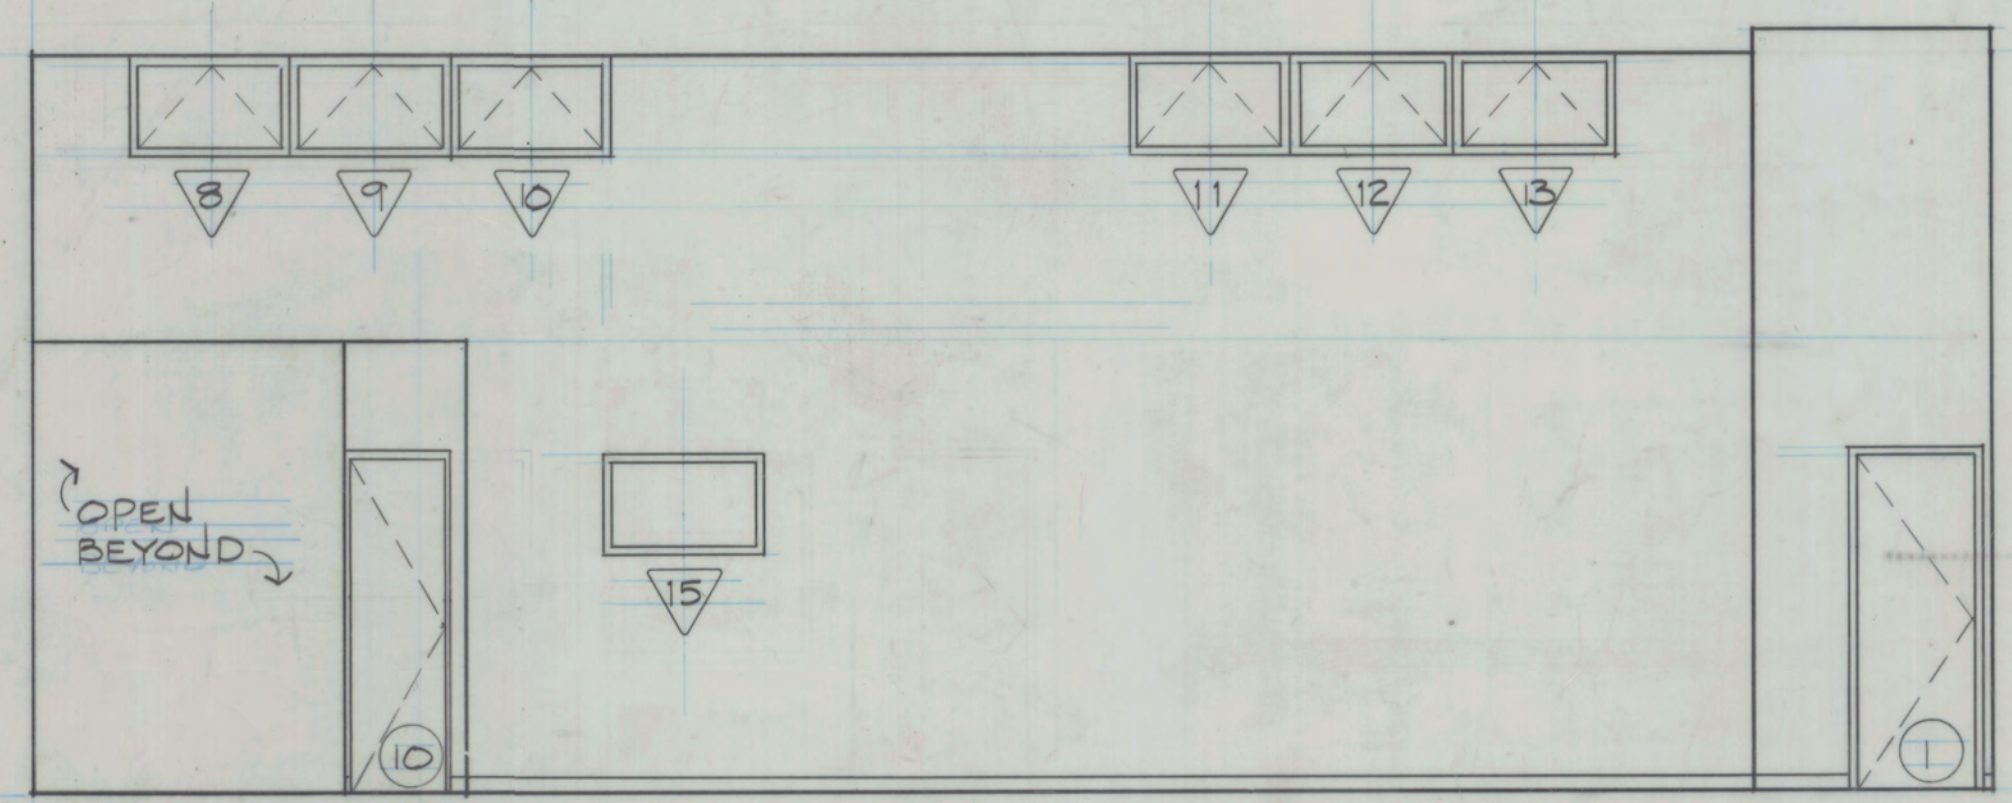


SOUTH
RM 108 cont

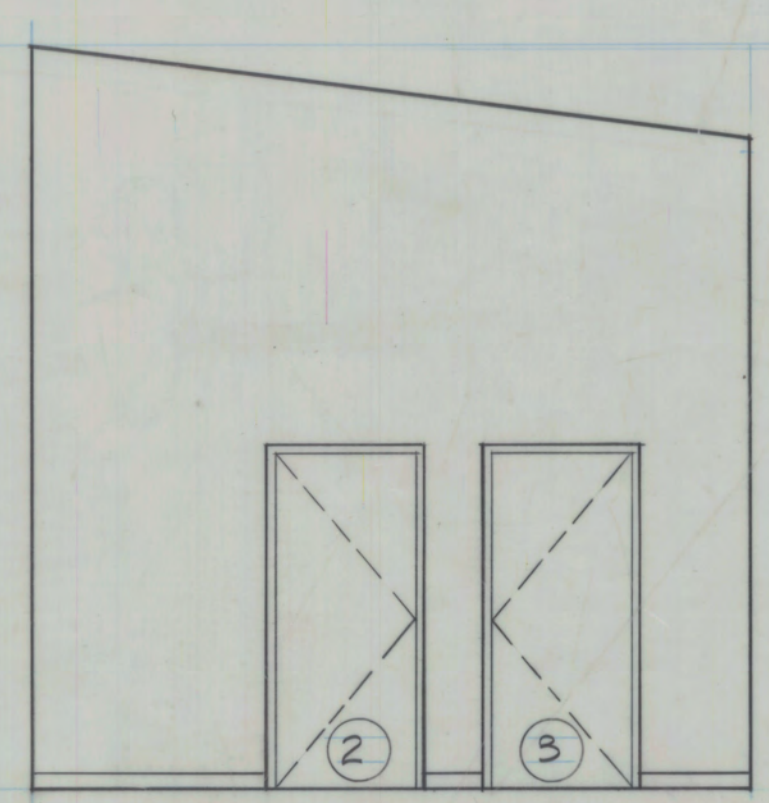


WEST

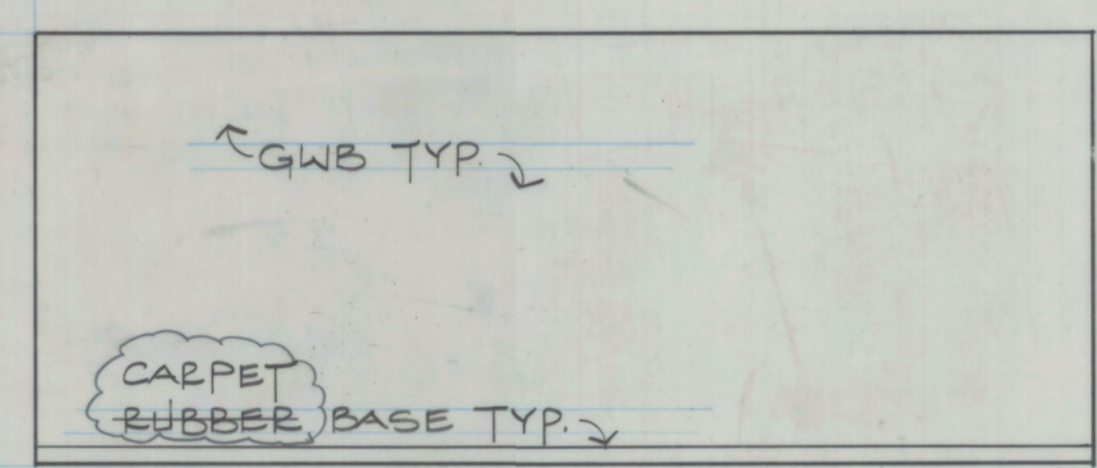

NORTH
RM 110

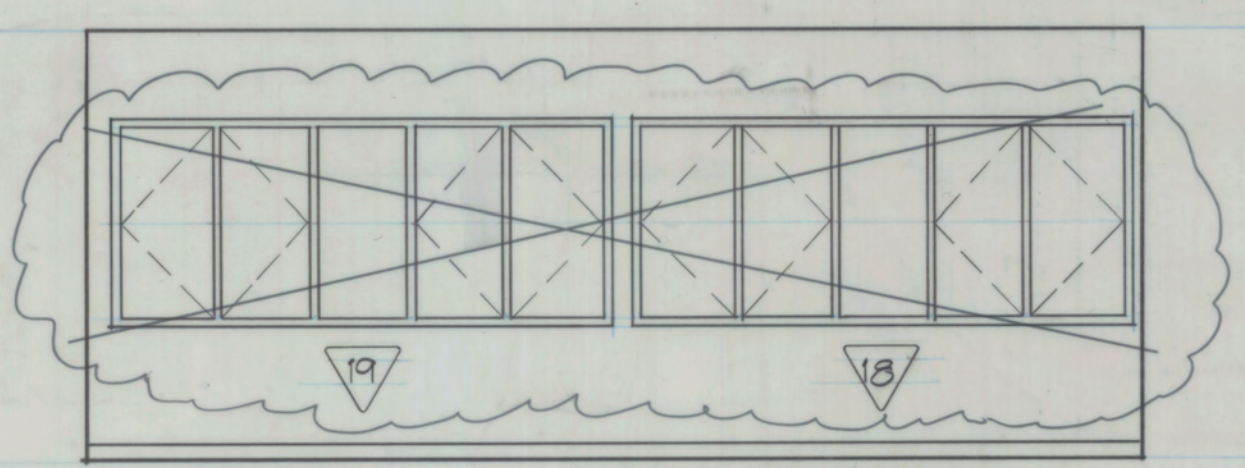

SOUTH

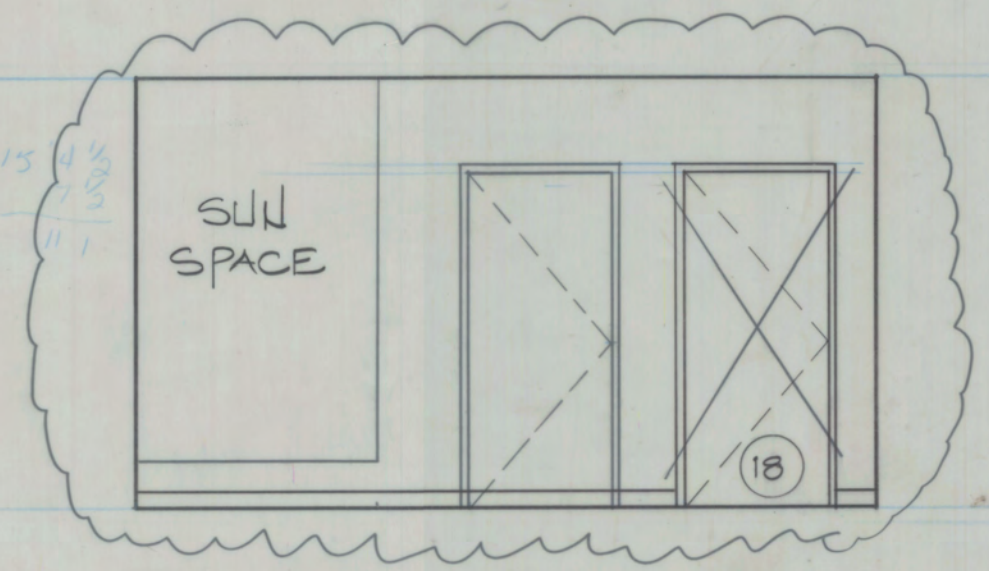

WEST