


CITY IMPOUND LOT LIGHTS
APPENDIX A

City Impound Lot Lights

Current Light Schematic

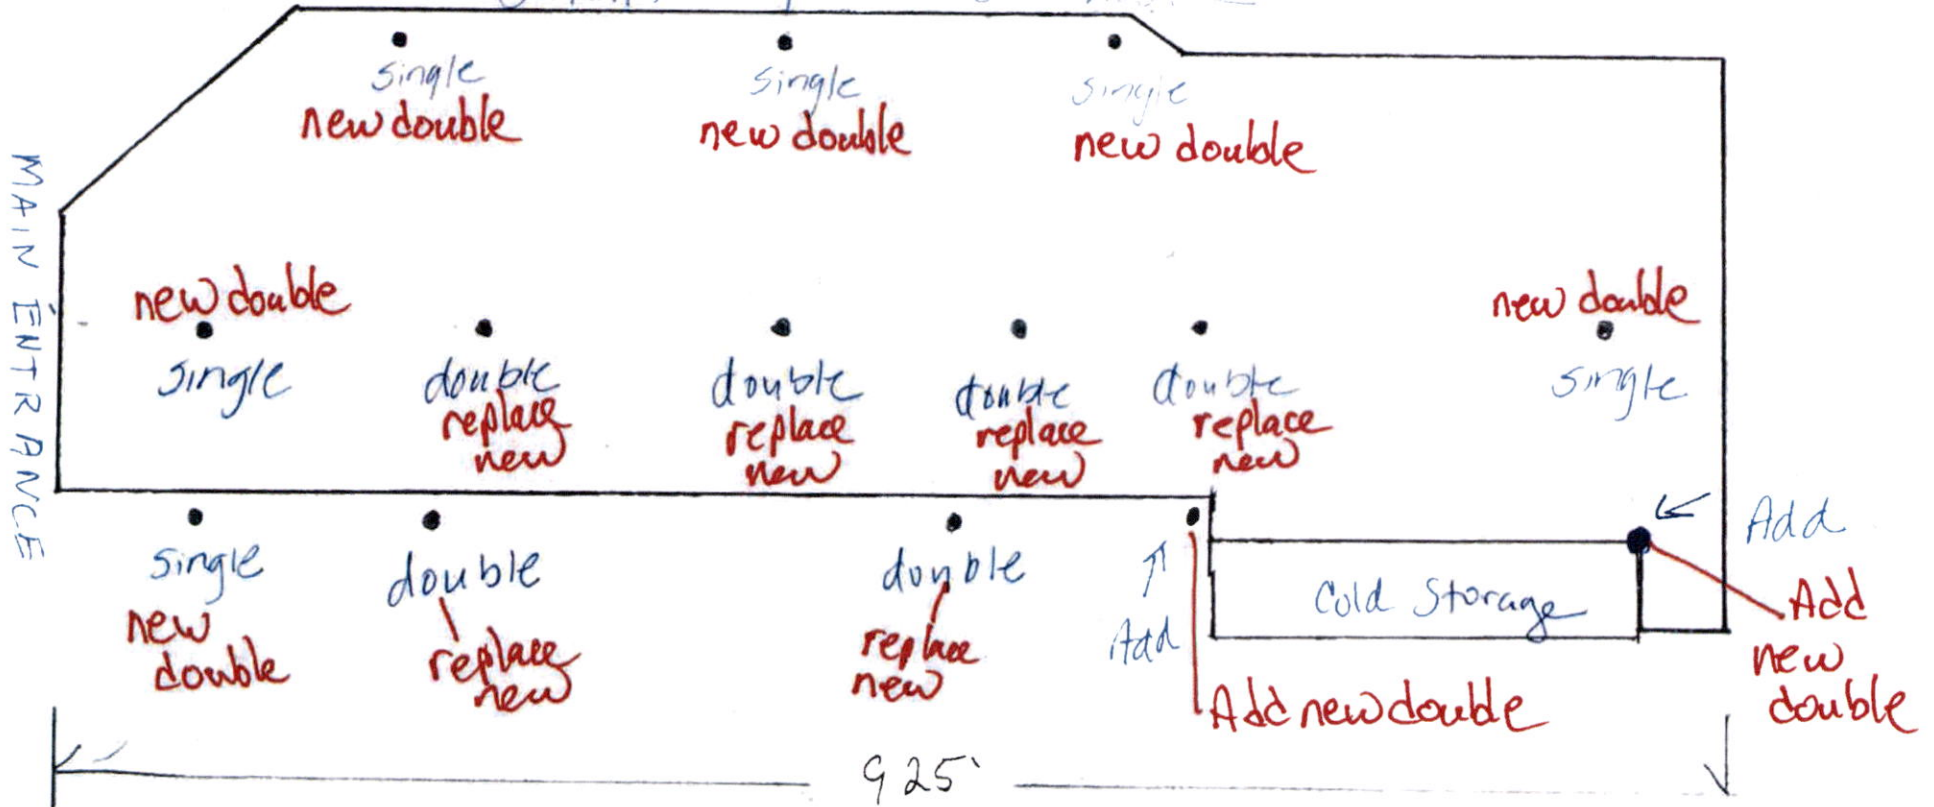





Esri, USGS | State of Alaska, Esri, HERE, Garmin, FAO, NOAA, USGS, EPA, NPS

200ft
47.774 64.830 Degrees